



5 cm

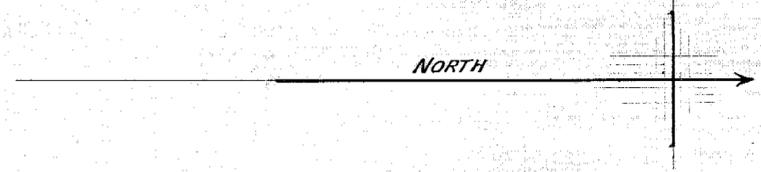

STORY'S CREEK TIN MINE
 Development to March 31st 1928 40 feet scale
 Surveyed with 5" I. & S. Theodolite
 Donald Fraser
 Auth. Surveyor

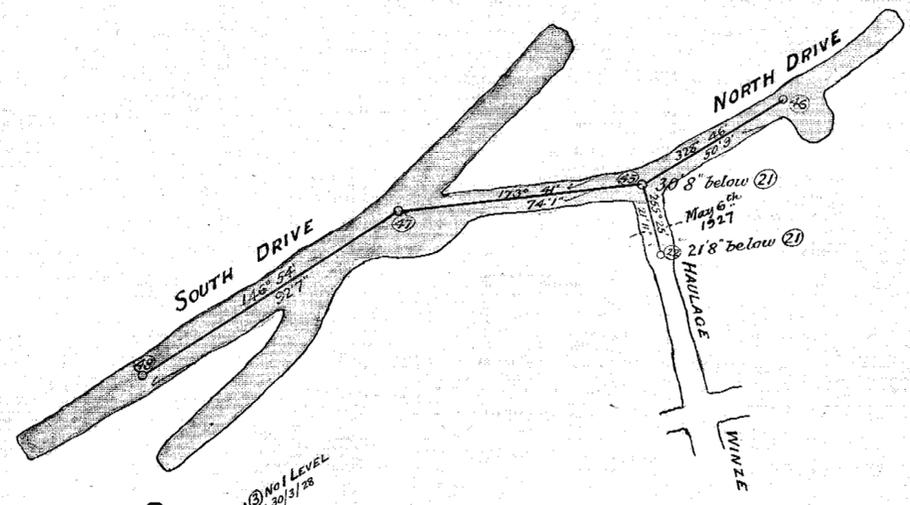