


5 cm

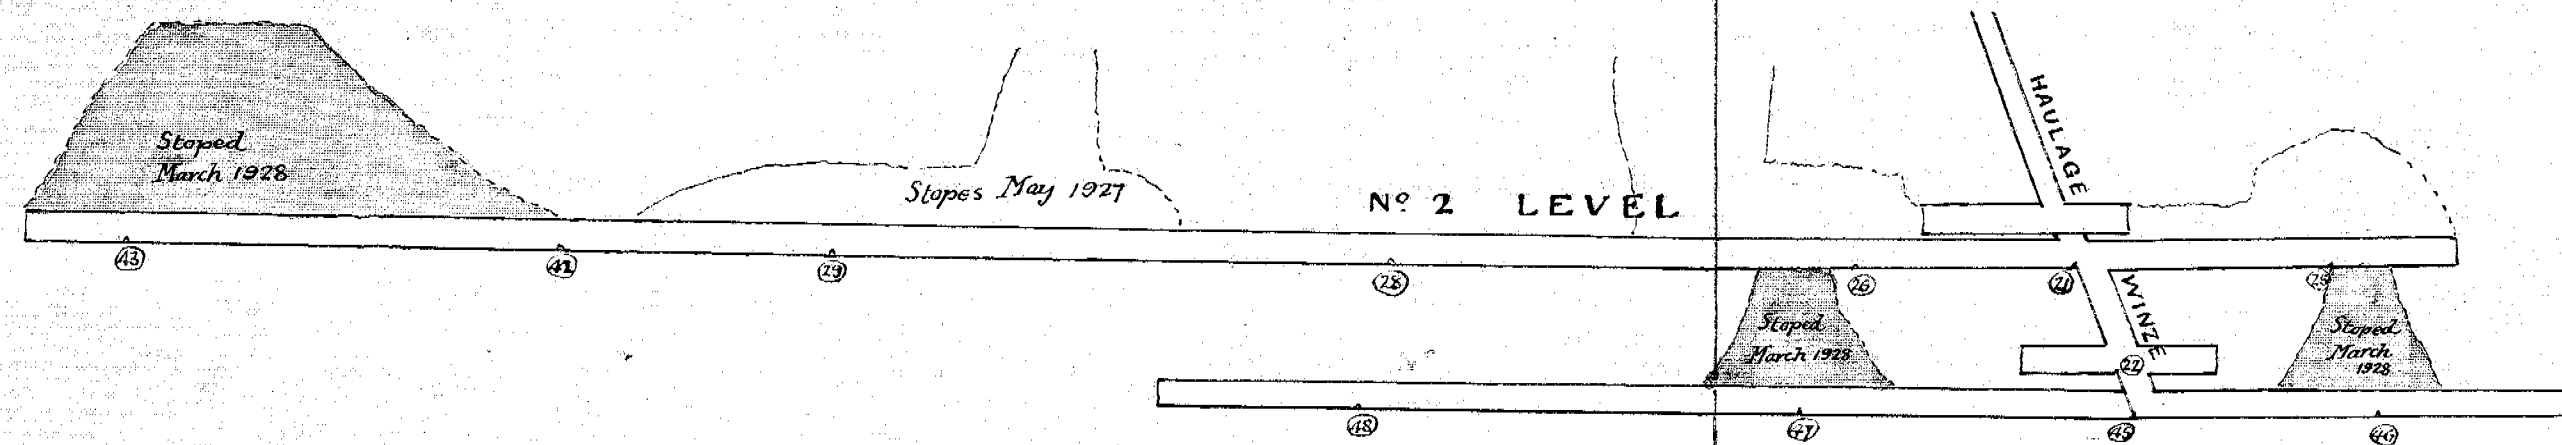

40 Feet to 1 inch
Storey's Creek Lin Mine
Section of Levels
to 31st March 1928
Donald Fraser
Authd Surveyor