

5 cm


STORY'S CREEK MINE

EXTENSIONS

For year ending 31st December, 1921.

1571 M 20 AC

D. McLEOD

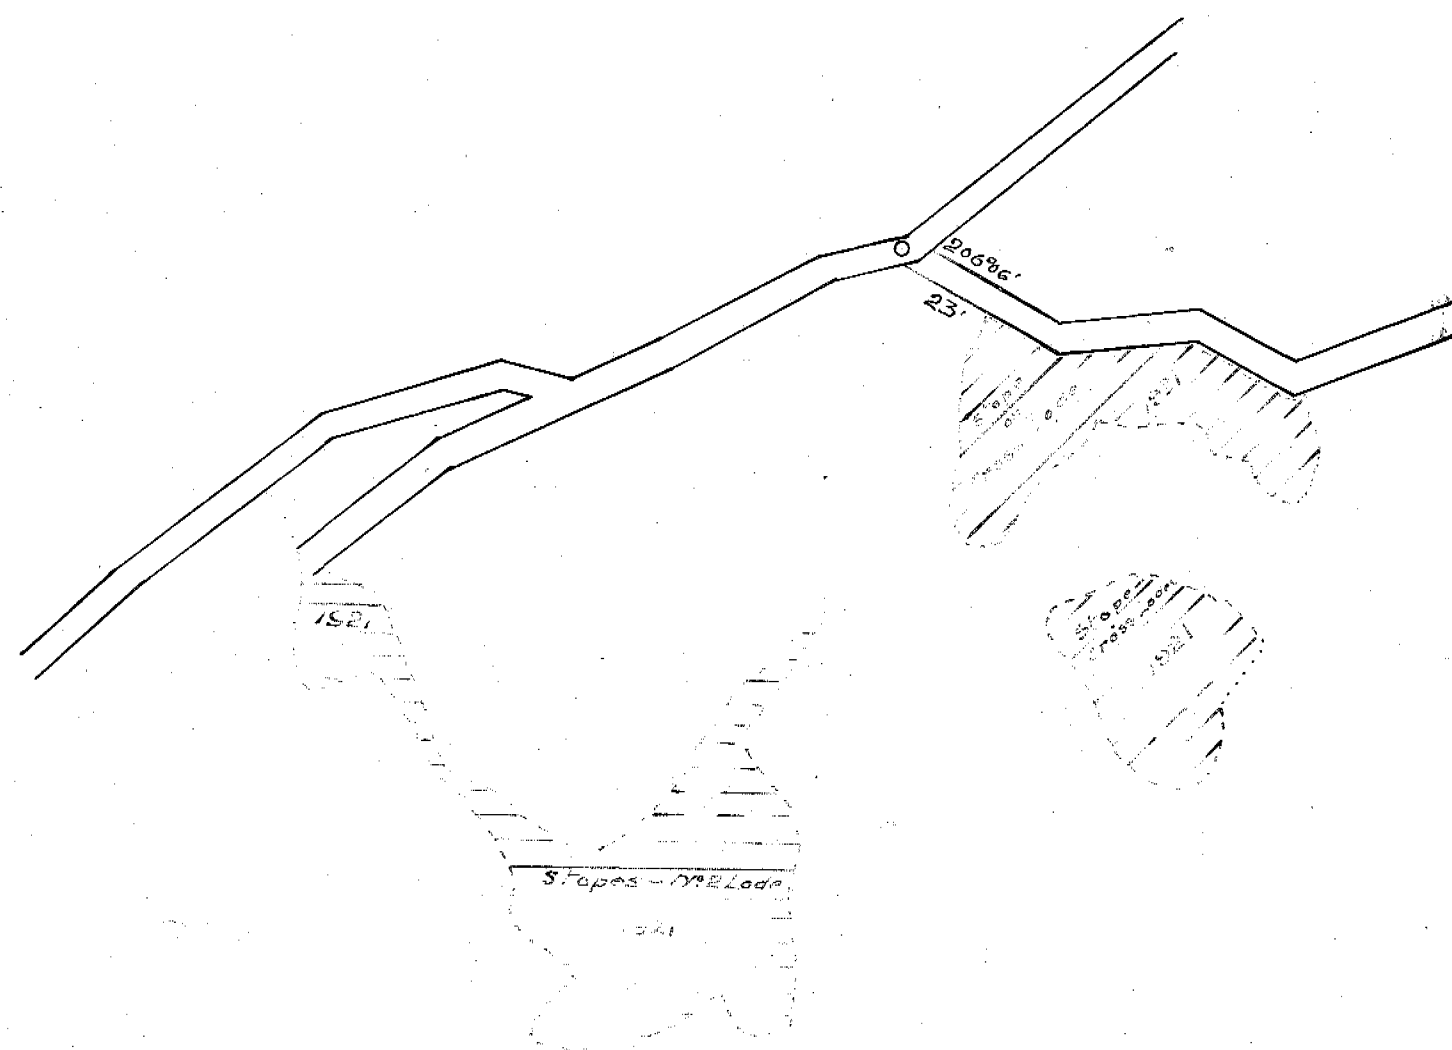

REFERENCE

Stopes on N°1 Lode
" " N°2 "
" " Cross "

Survey with theodolite and
H² prismatic compass.

Joe. Miller
Manager
Jan'y. 1922.

52-14