


STORY'S CREEK TIN MINE, AVOCA.

PLAN

SCALE - 40 FEET TO 1 INCH

DEVELOPMENT TO DATE APRIL 24th 1926. - MAY 6th 1927 as shown in red figures and traverse lines surveyed with 5" T. & S. Theodolite

*Donald Fraser
Cadastral Surveyor
May 6th 1927*

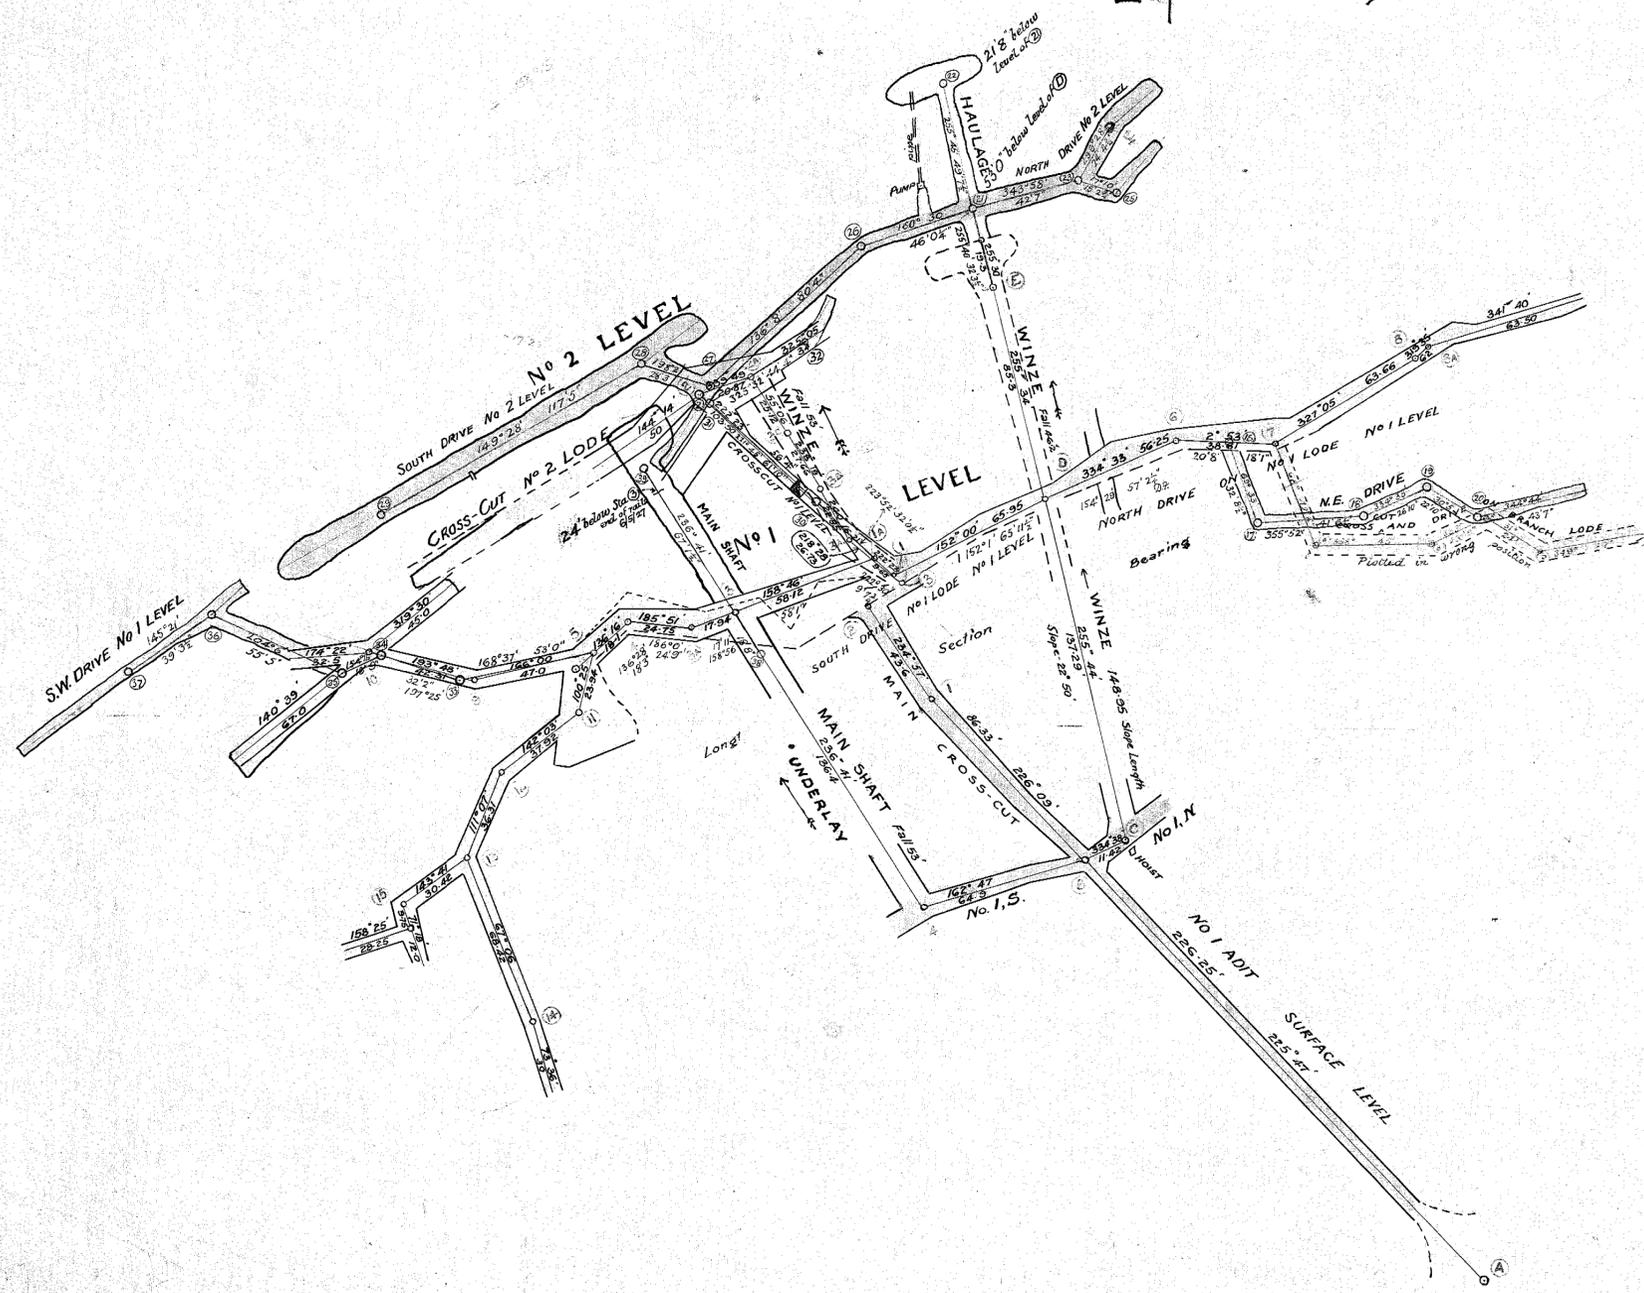

*R/B Montgomery
Dist. Surveyor
April
1926*