


55-01

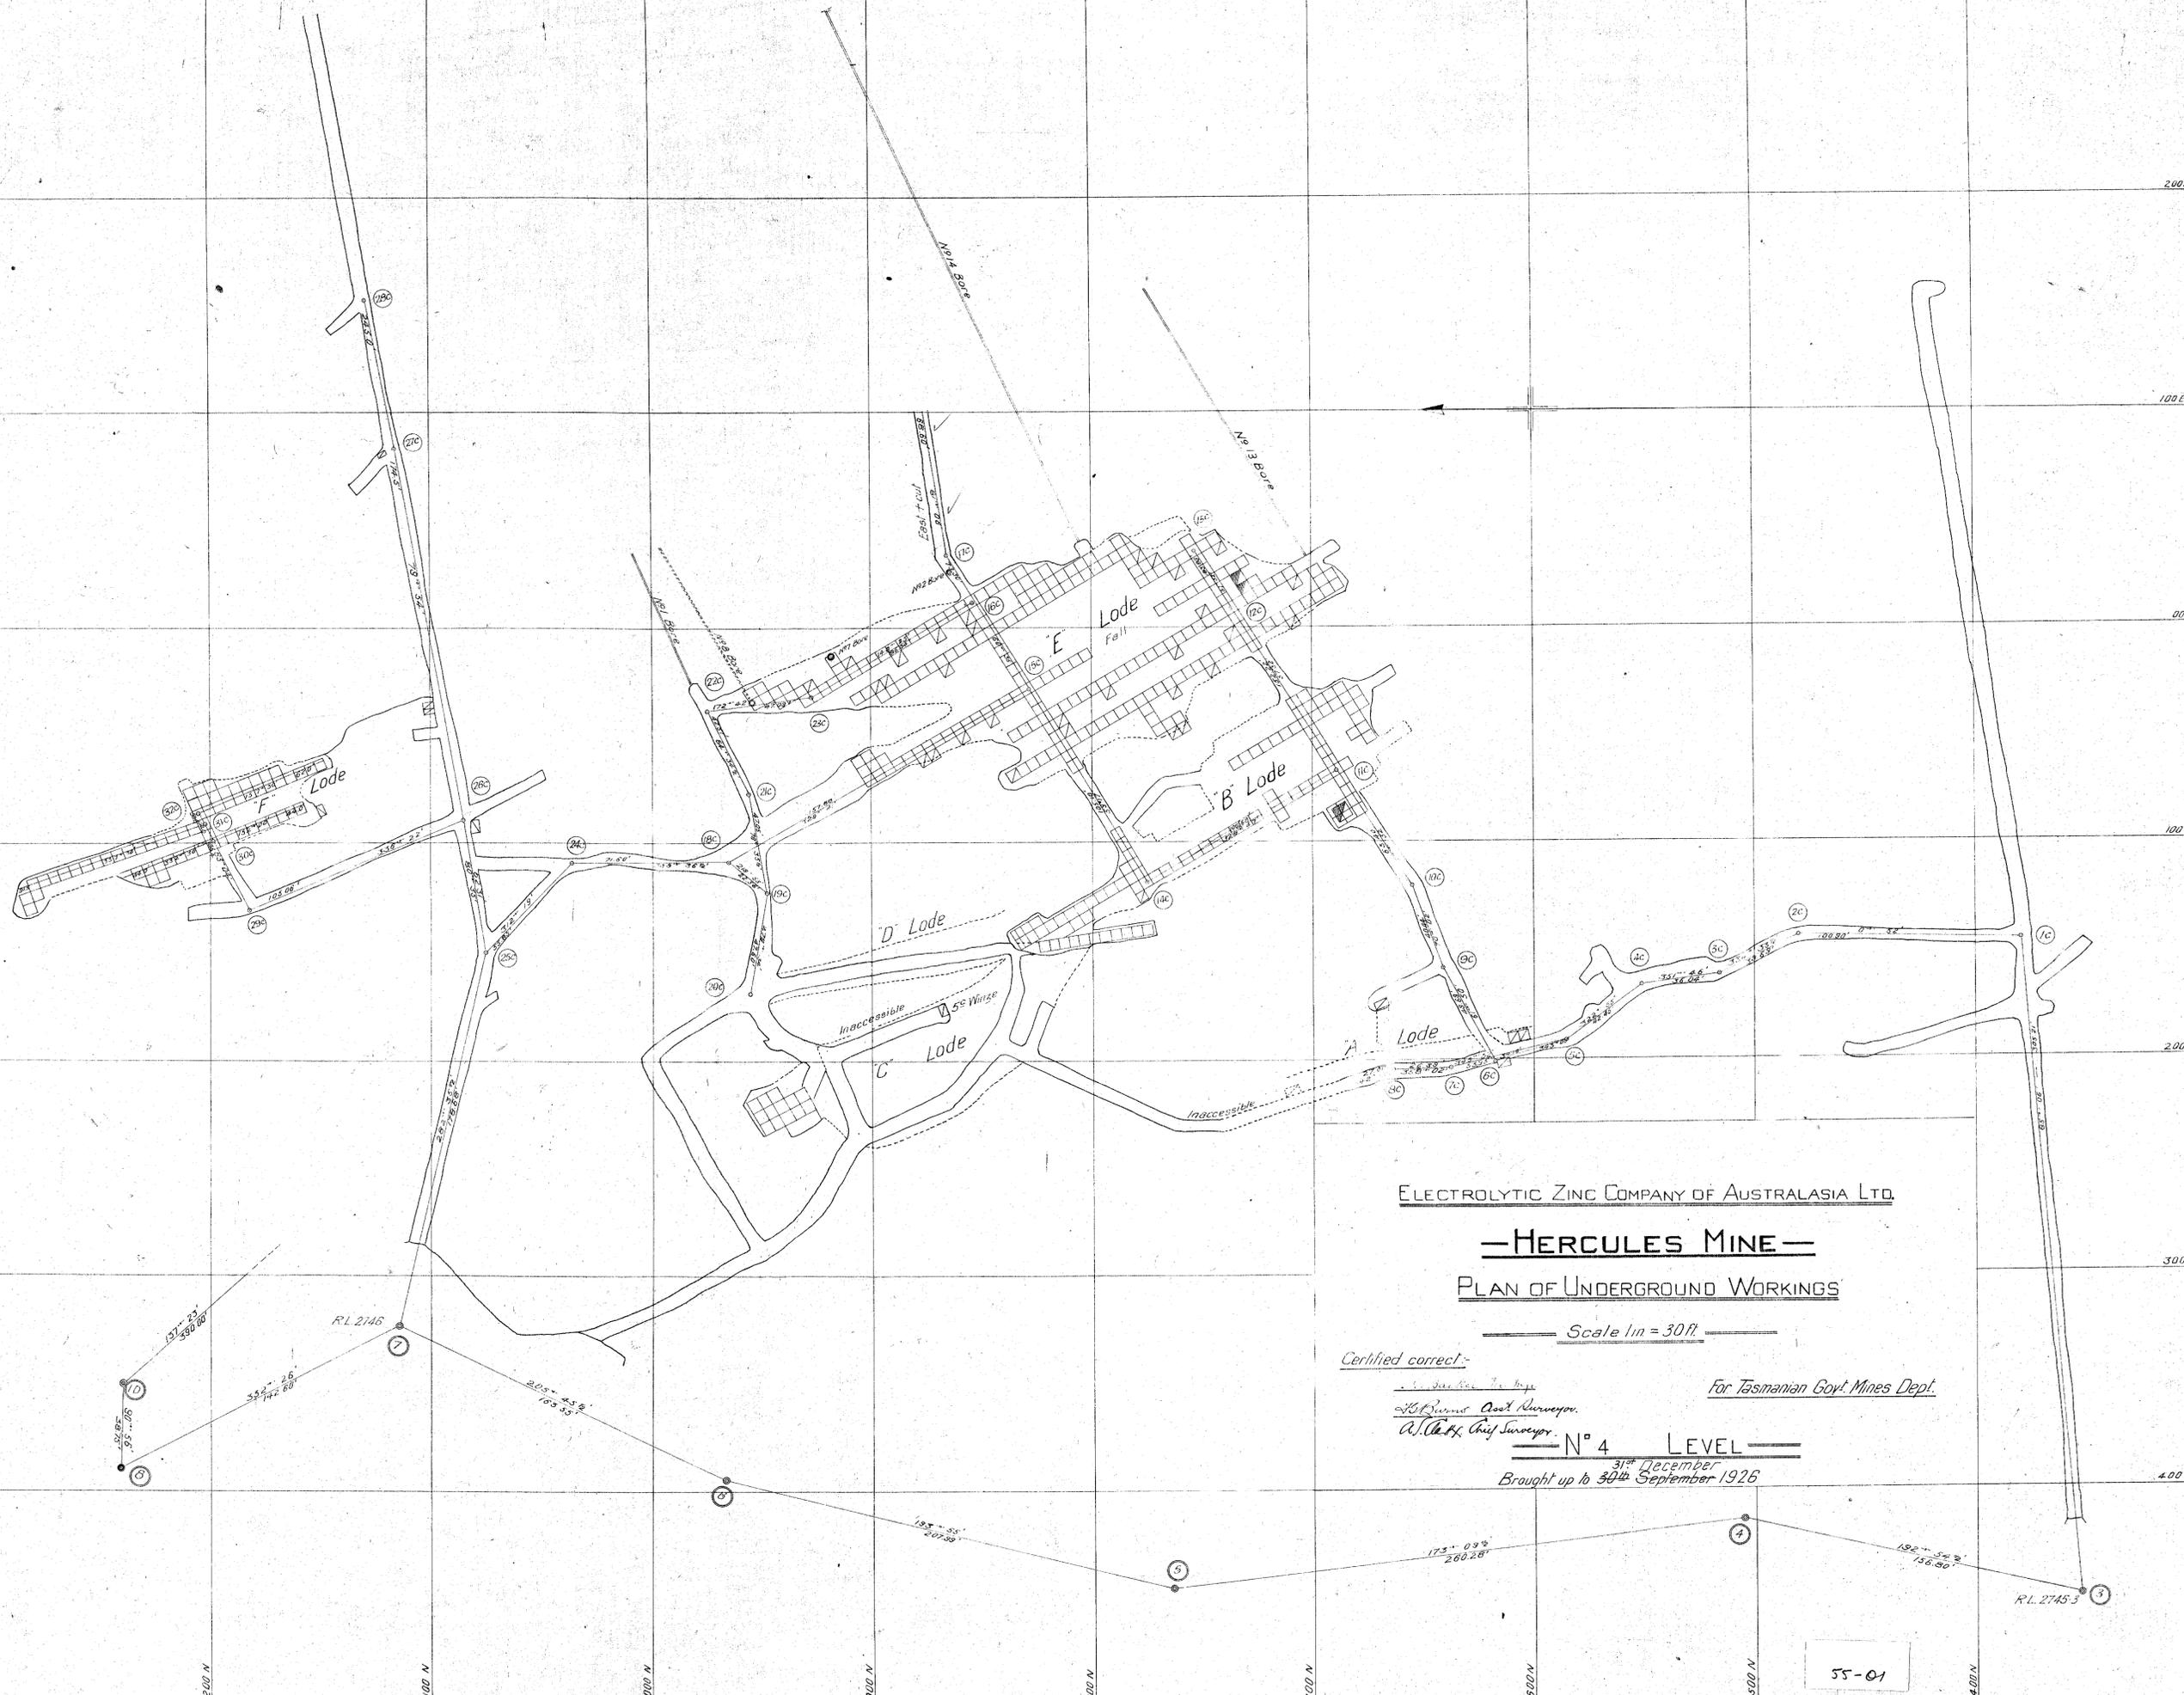

ELECTROLYTIC ZINC COMPANY OF AUSTRALASIA LTD.

—HERCULES MINE—

PLAN OF UNDERGROUND WORKINGS

Scale 1 in = 30 ft.

Certified correct:-

A. J. Burns
A. J. Burns
A. J. Burns
A. J. Burns

For Tasmanian Govt. Mines Dept.

— N° 4 LEVEL —

Brought up to 31st December 1926

55-01