

ELECTROLYTIC ZINC COMPANY OF AUSTRALASIA LTD.

— ROSEBERY MINE —

— LONGITUDINAL SECTION —

— SCALE 40 FT. TO 1 IN. —

— Brought up to 31st December 1927 —

Note: Datum = Sea level

Reference
Hanging-wall crosscuts
Footwall
Stopes

Work done from [] to [] shown in red

Drawing and Tracing by F.G. Burns 20-8-27


A. Clark

Chief Surveyor

A. Barker

Mine Manager

— SHEET N^o 1 —

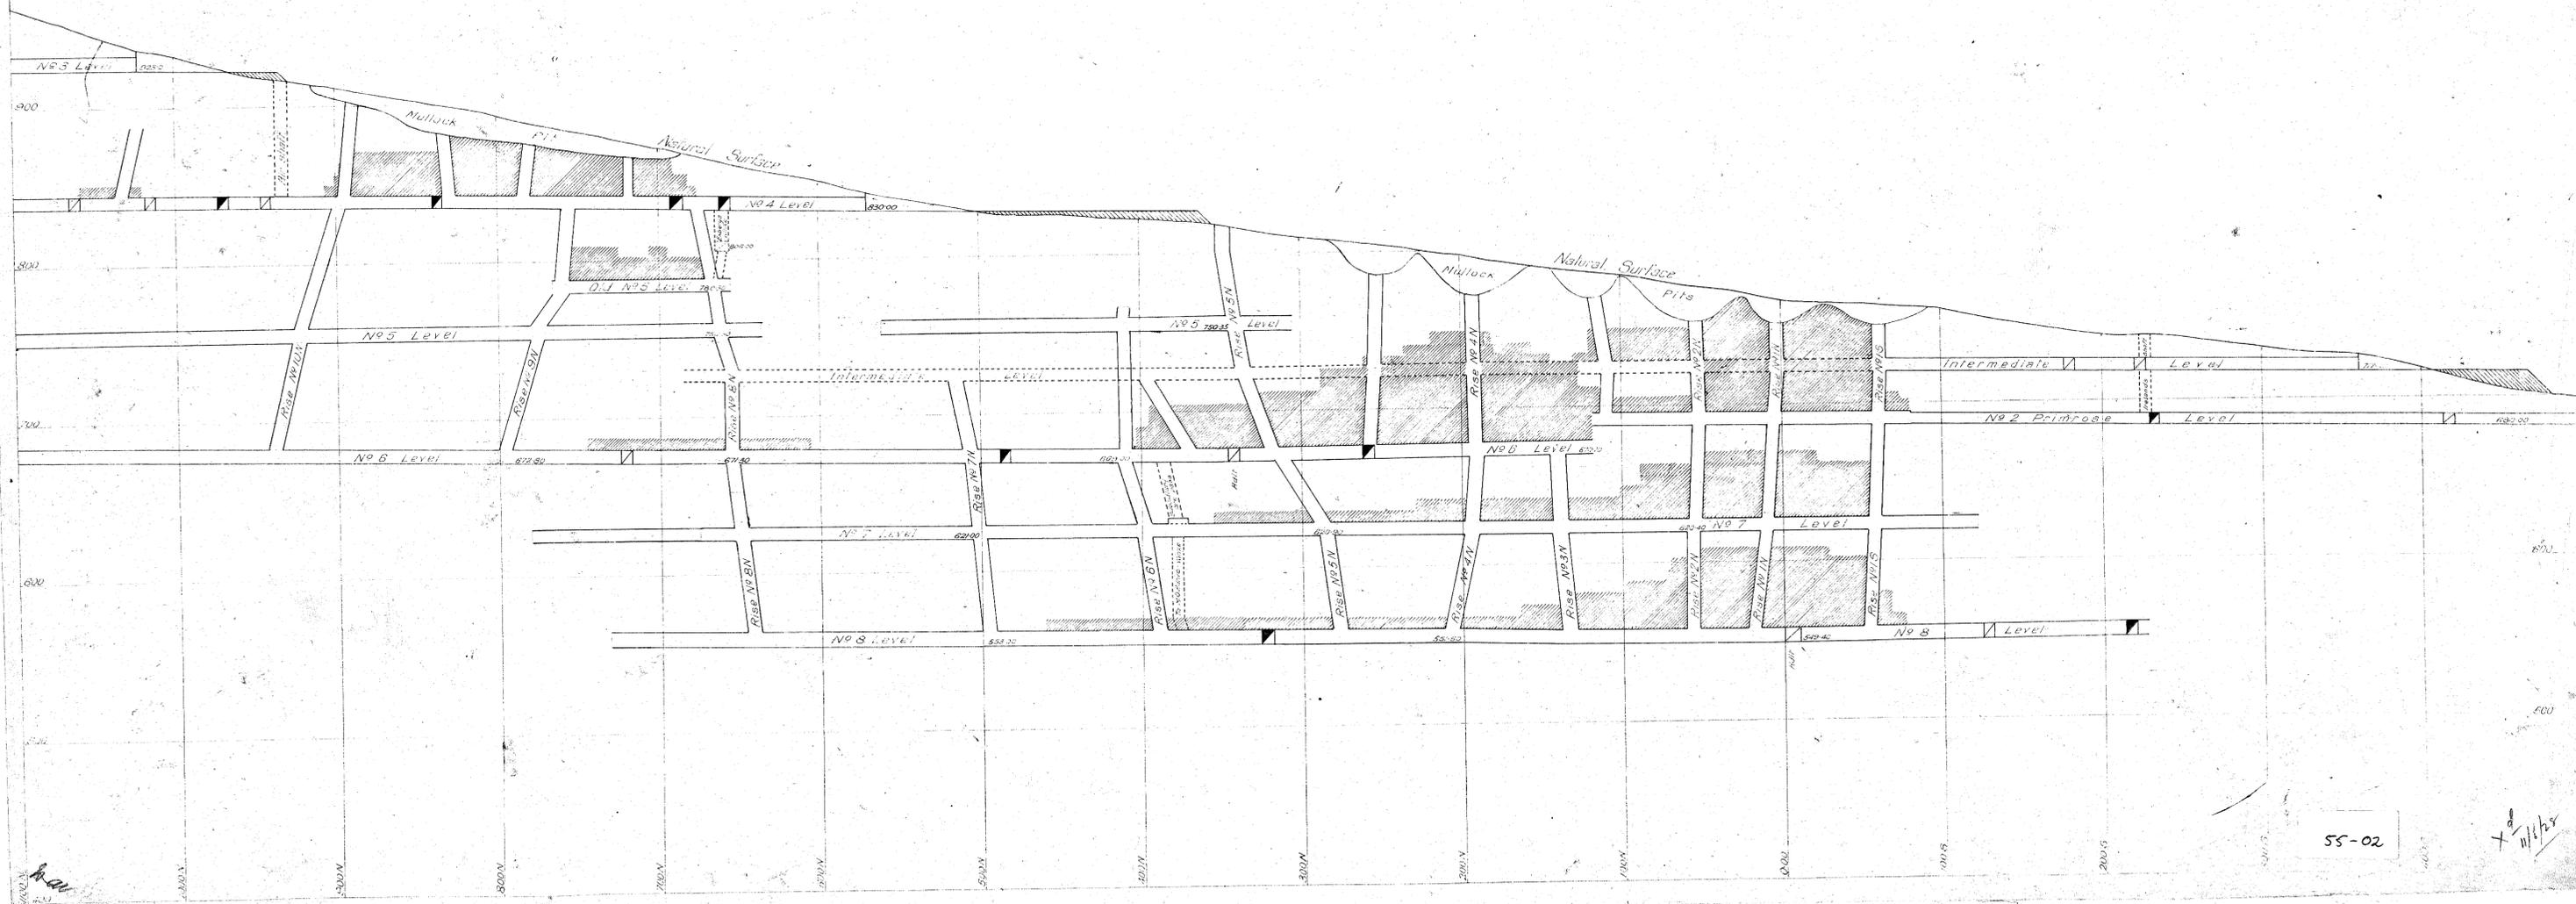

X of Wilby