

ELECTROLYTIC ZINC COMPANY OF AUSTRALASIA LTD

HERCULES MINE

LONGITUDINAL SECTIONS

SCALE 40 FT. TO IN

Brought up to 31st December 1927


Note - Datum = Sea level

Reference
Hanging-wall crosscuts
Footwall
Slopes


Drawing and tracing by F.G. Burns 19-1-28

A. Clark Chief Surveyor
A. Barker Mine Manager


Note - Sections taken parallel to M.S. coordinates
North footwall slopes E. side shown dotted.

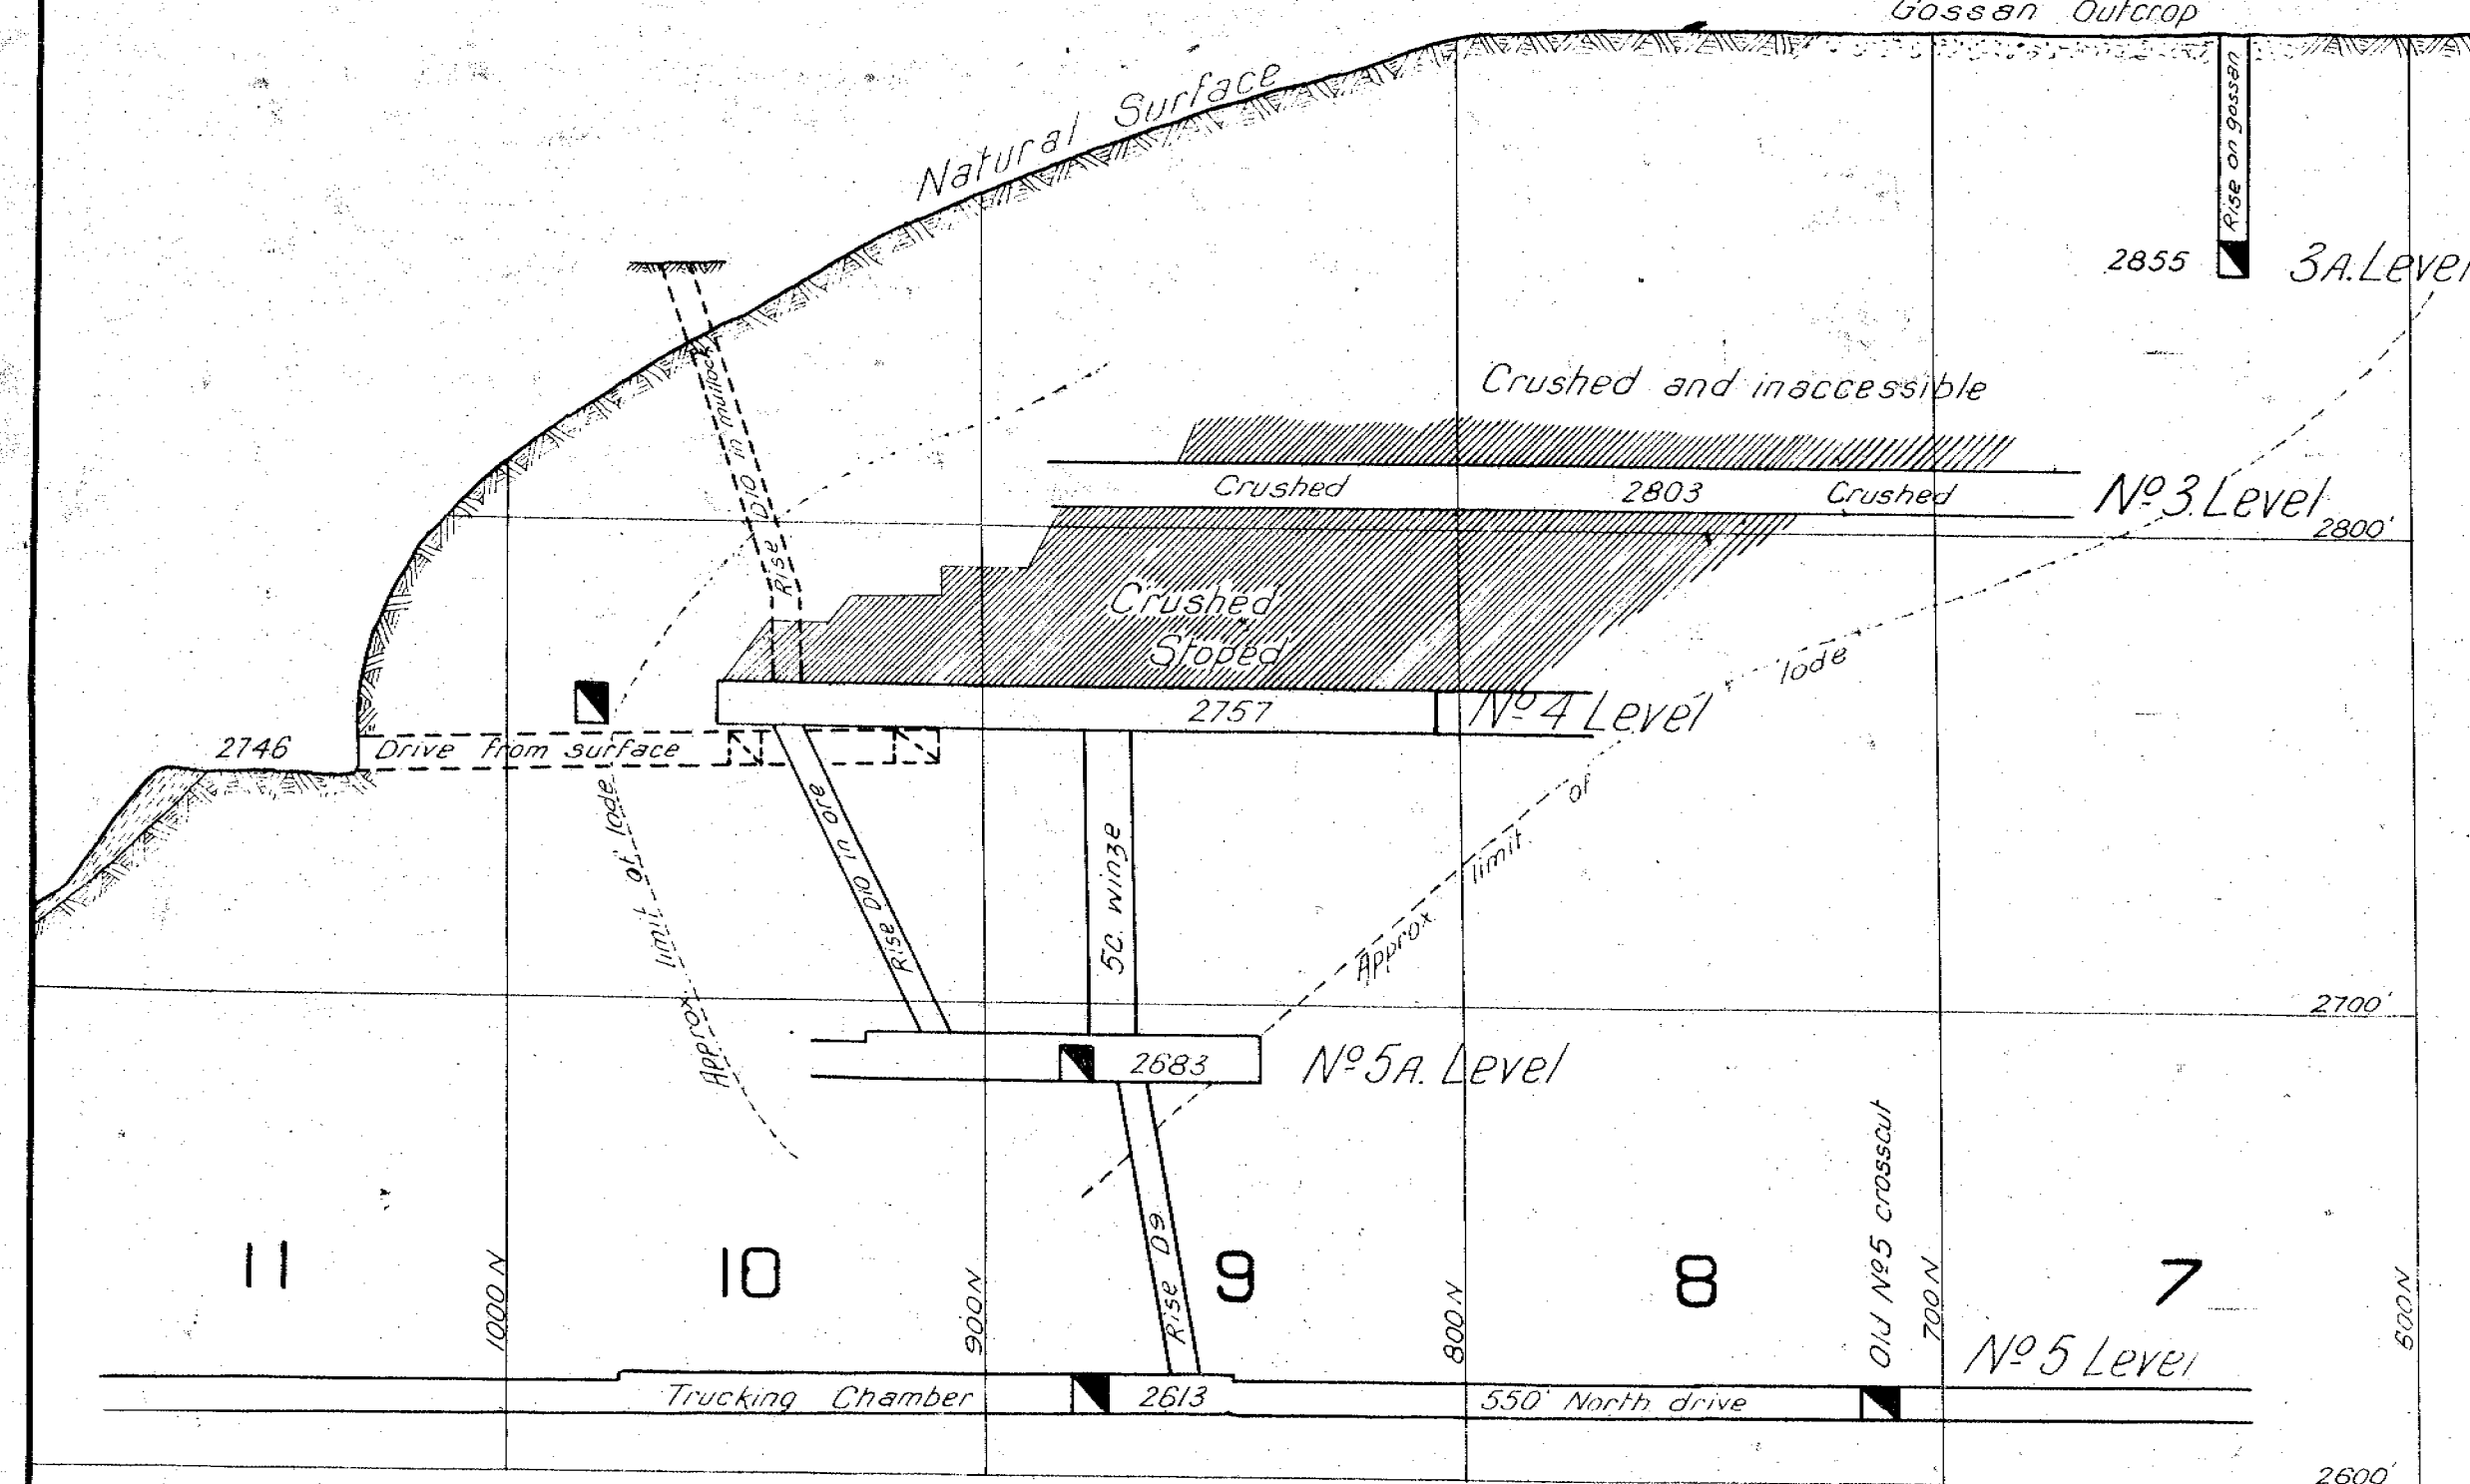


— "C" LODE —

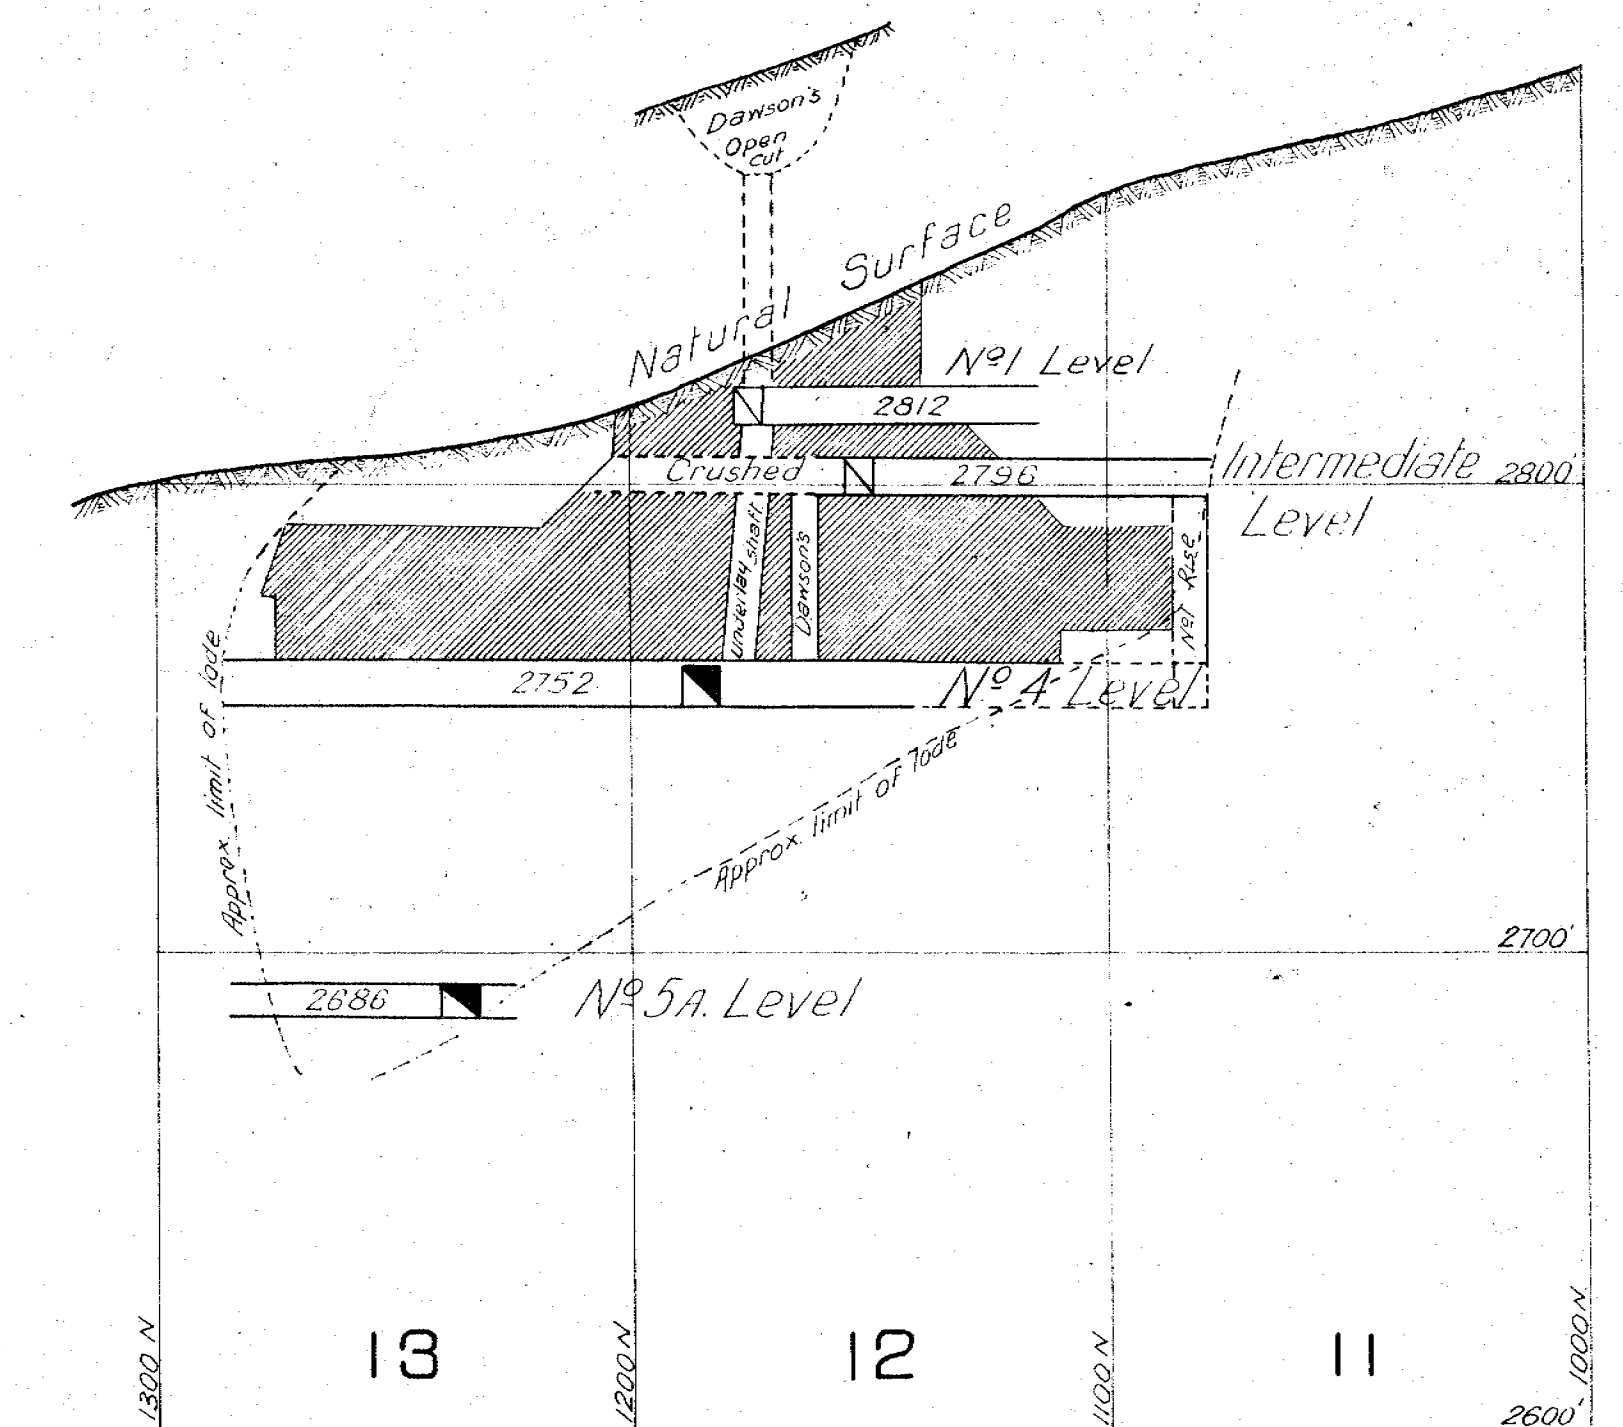


— "F" LODE —

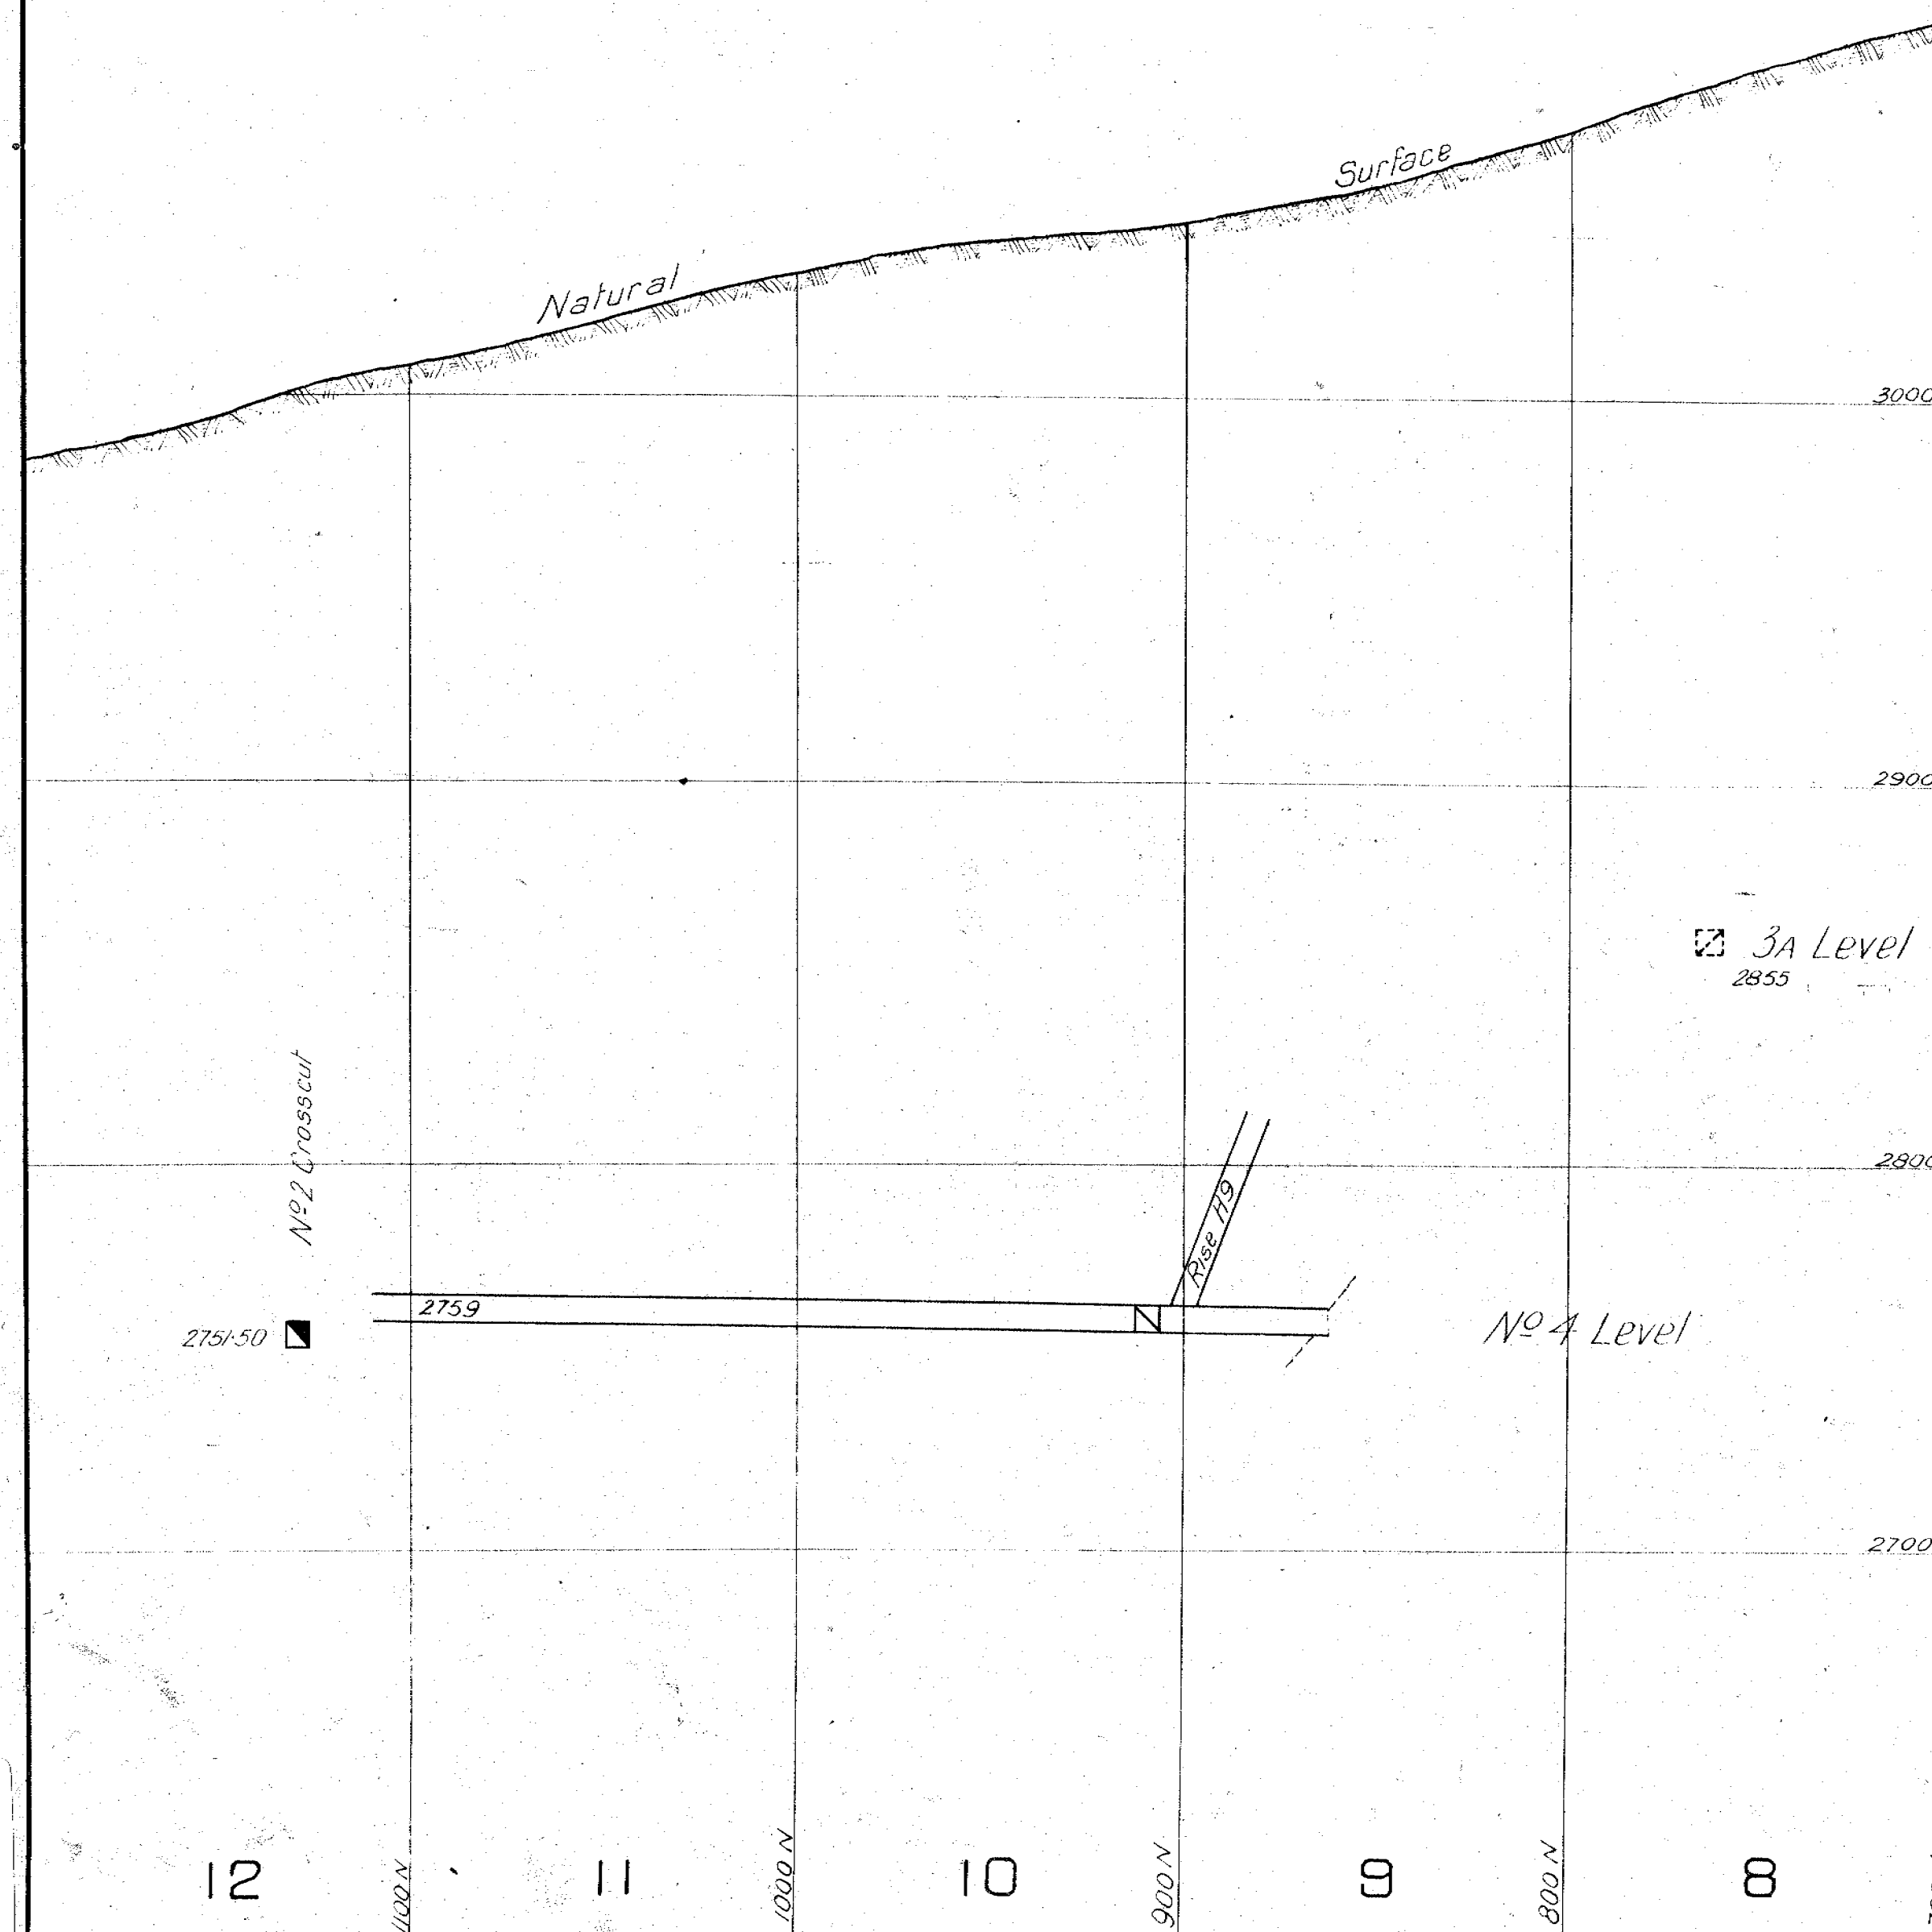

— "G" LODE —

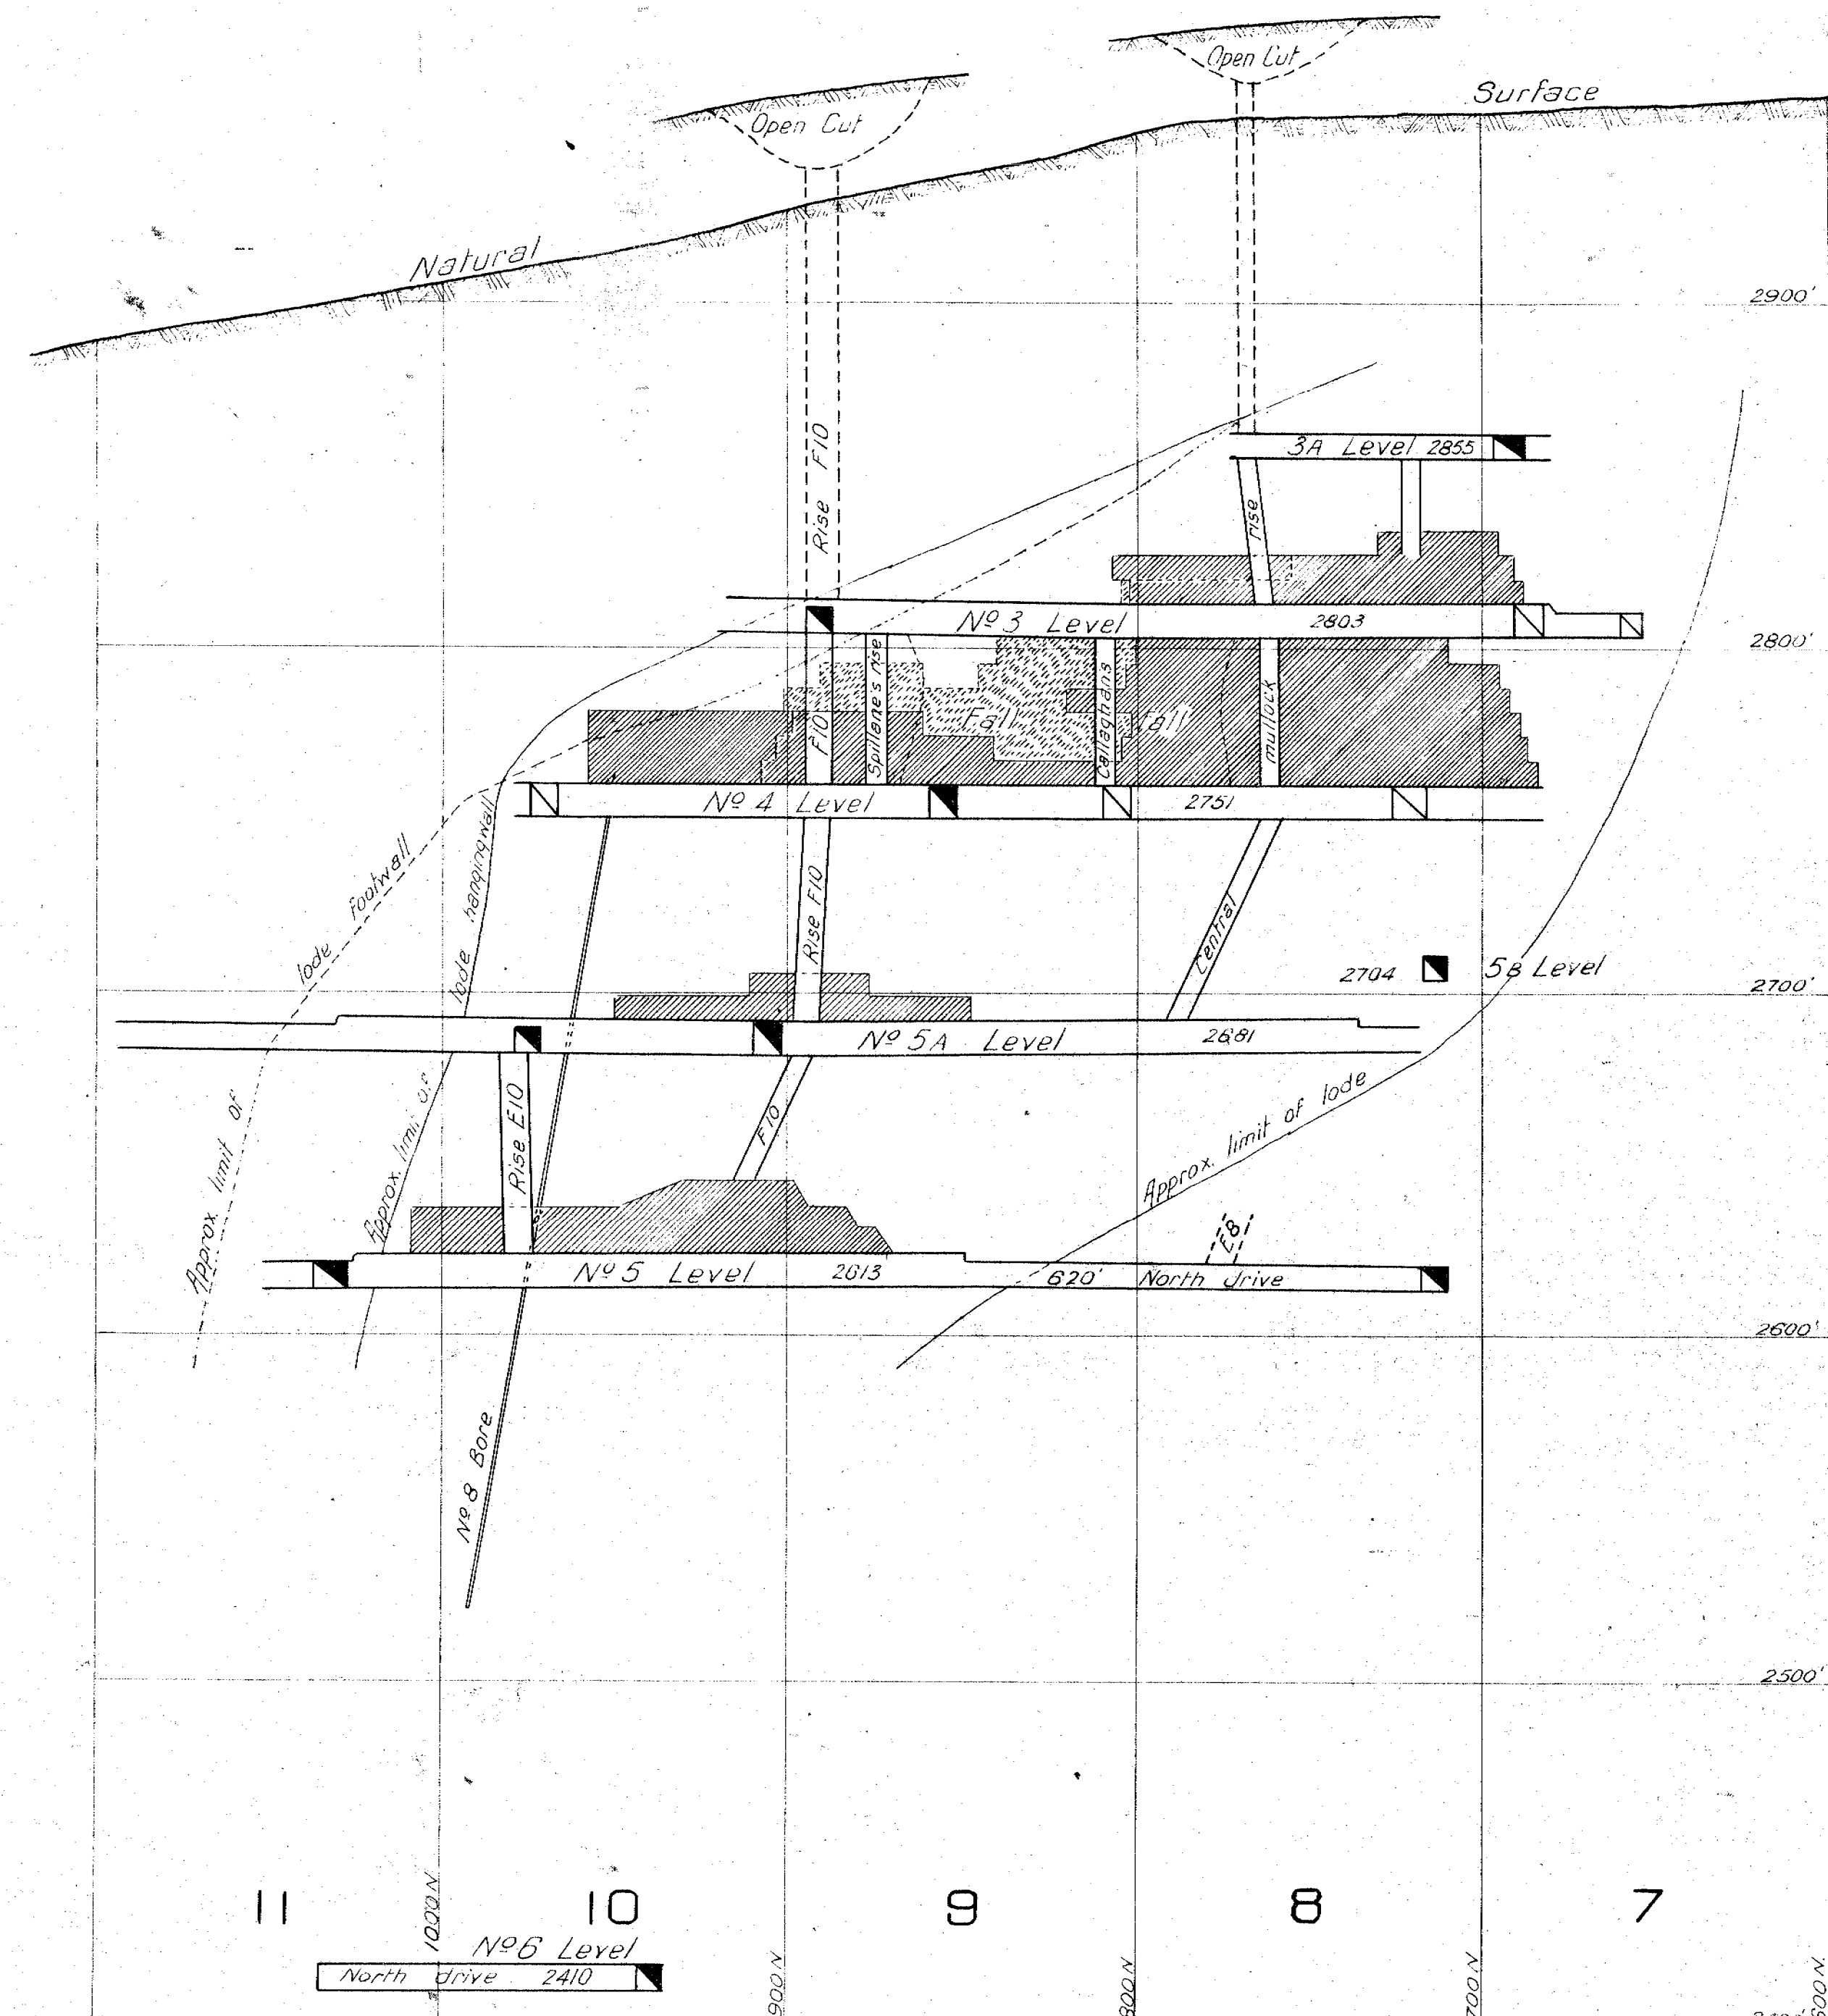

— "E" LODE —

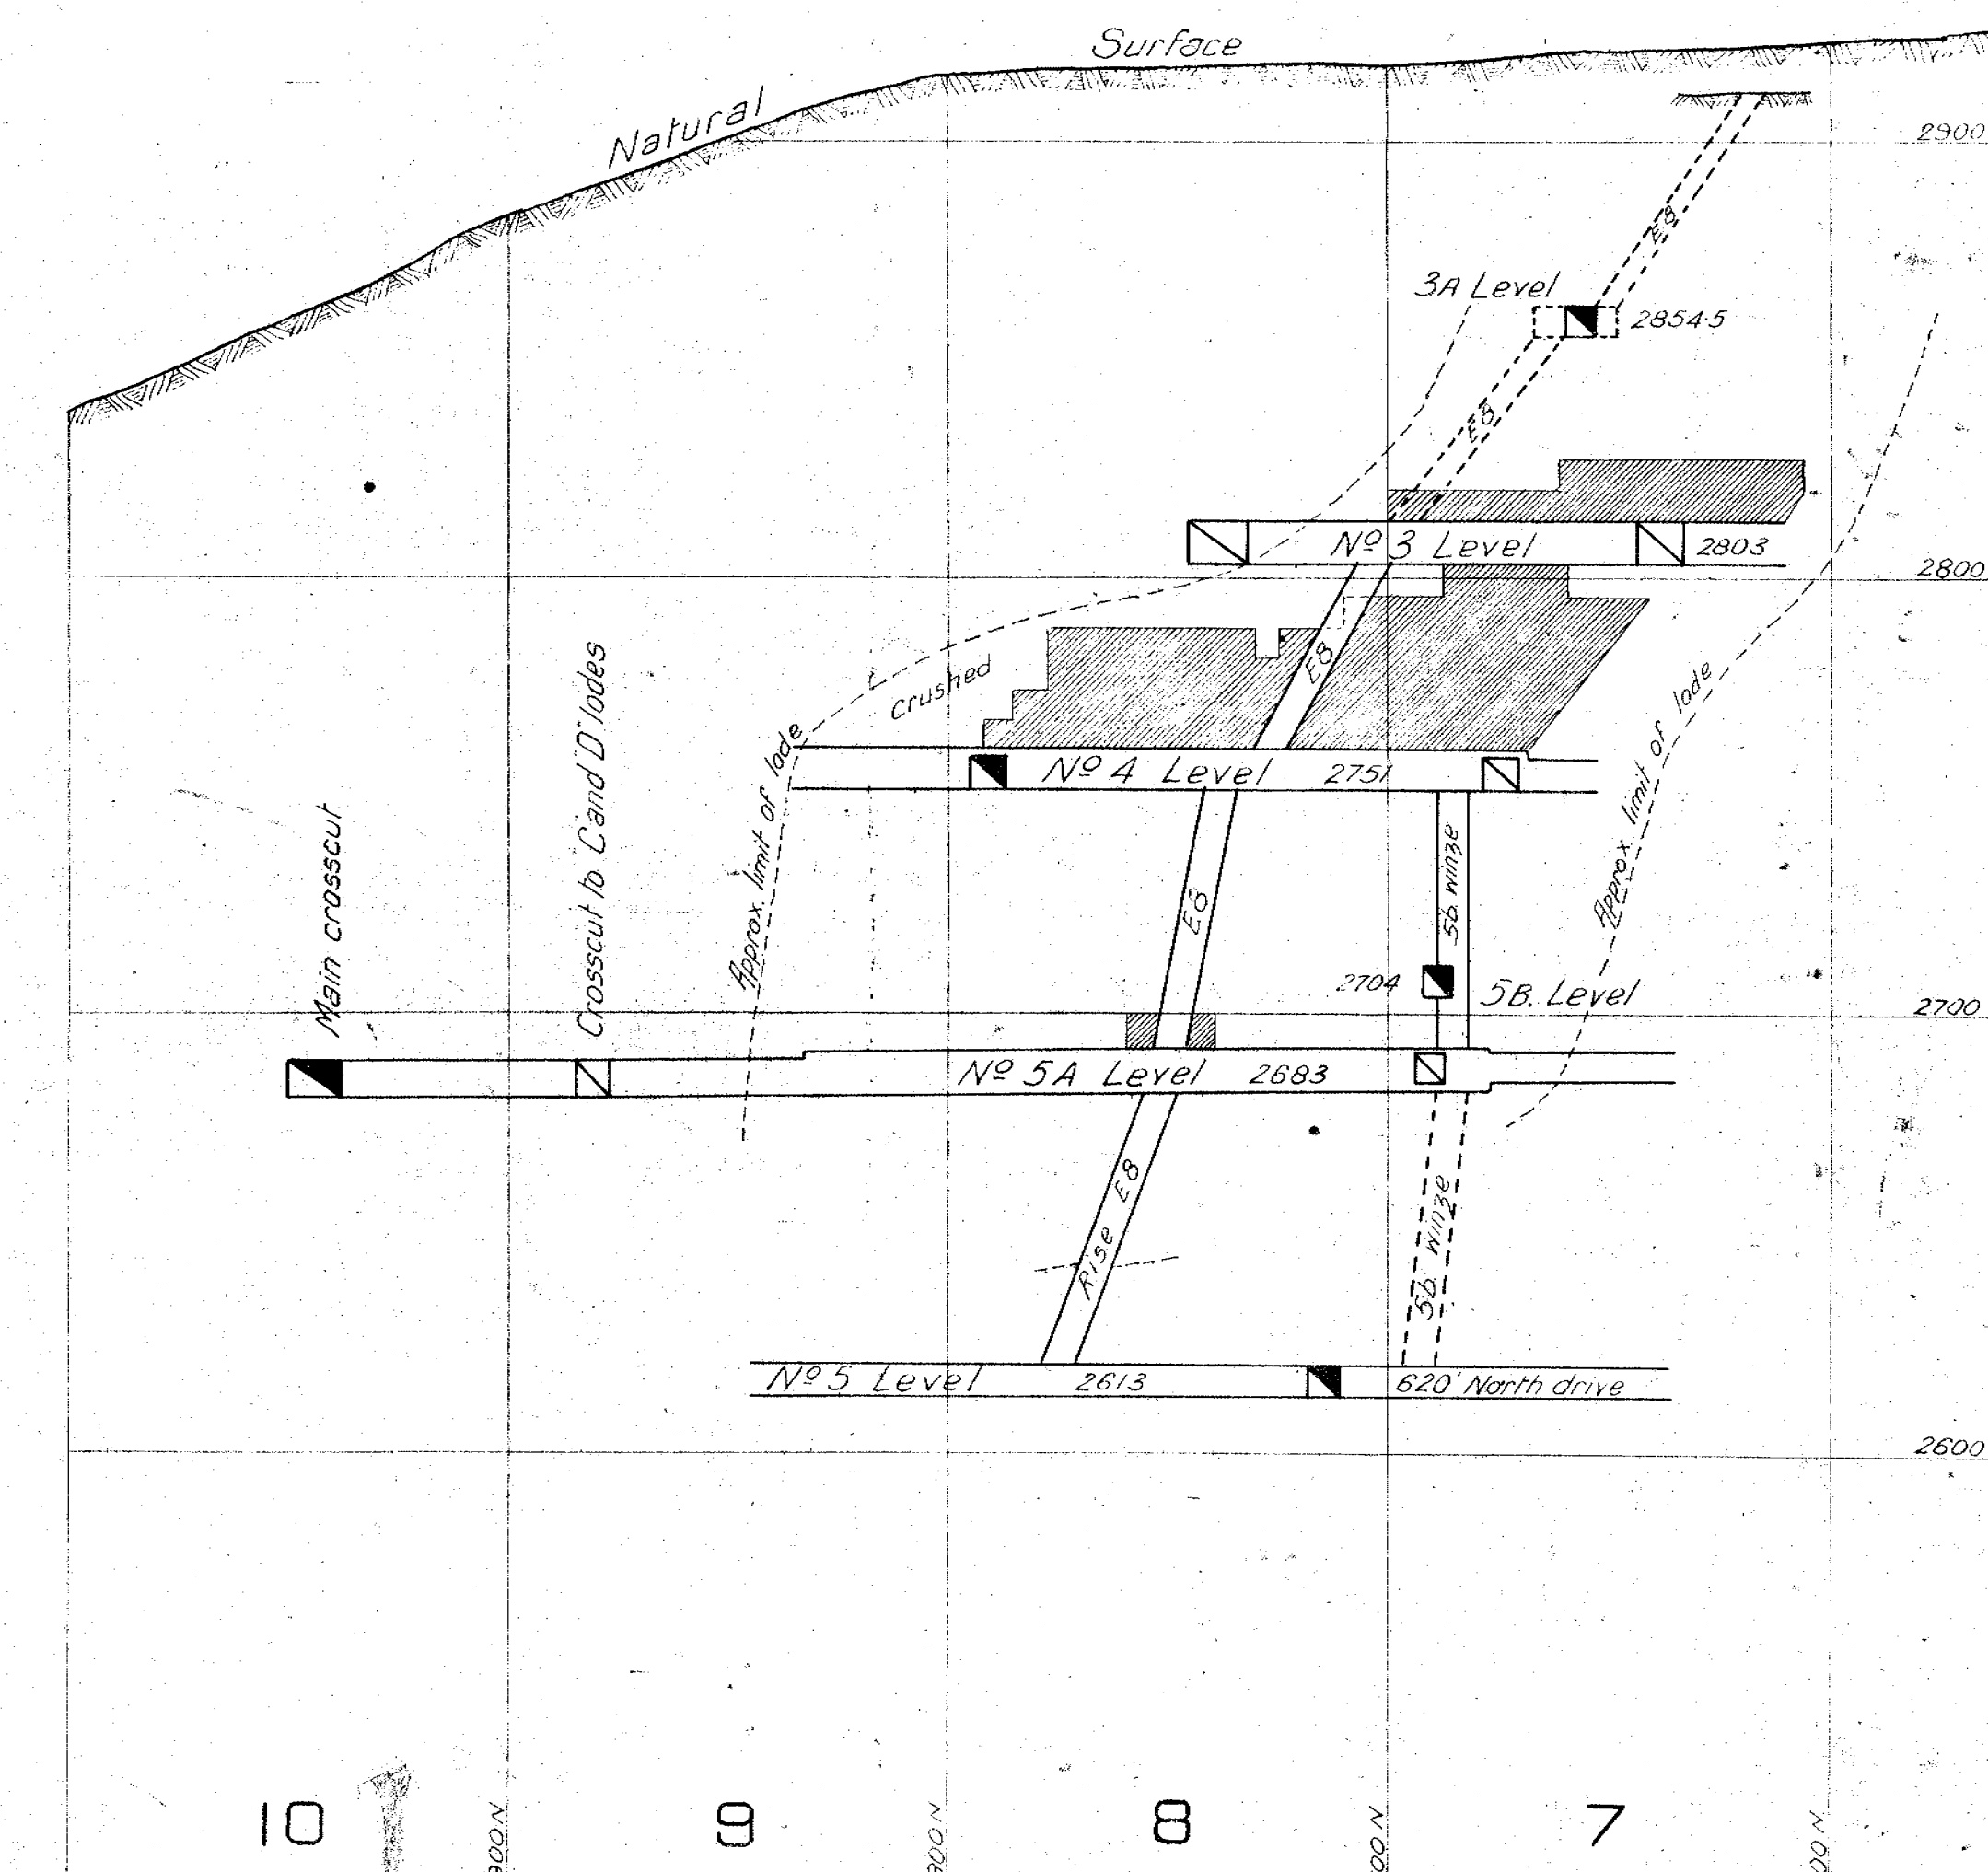

— "B" LODE —