

55-04


ELECTROLYTIC ZINC COY. OF AUSTRALASIA LTD.

# HERCULES MINE

## NO 4 LEVEL

SCALE 1 IN. = 40 FT.

Work done from [ ] to [ ] shown in red  
 Drawing and Tracing by F. G. Burns 7-9-27  
 Brought up to 31st December 1927  
 A. Barker Mine Manager  
 A. S. Clark Chief Surveyor

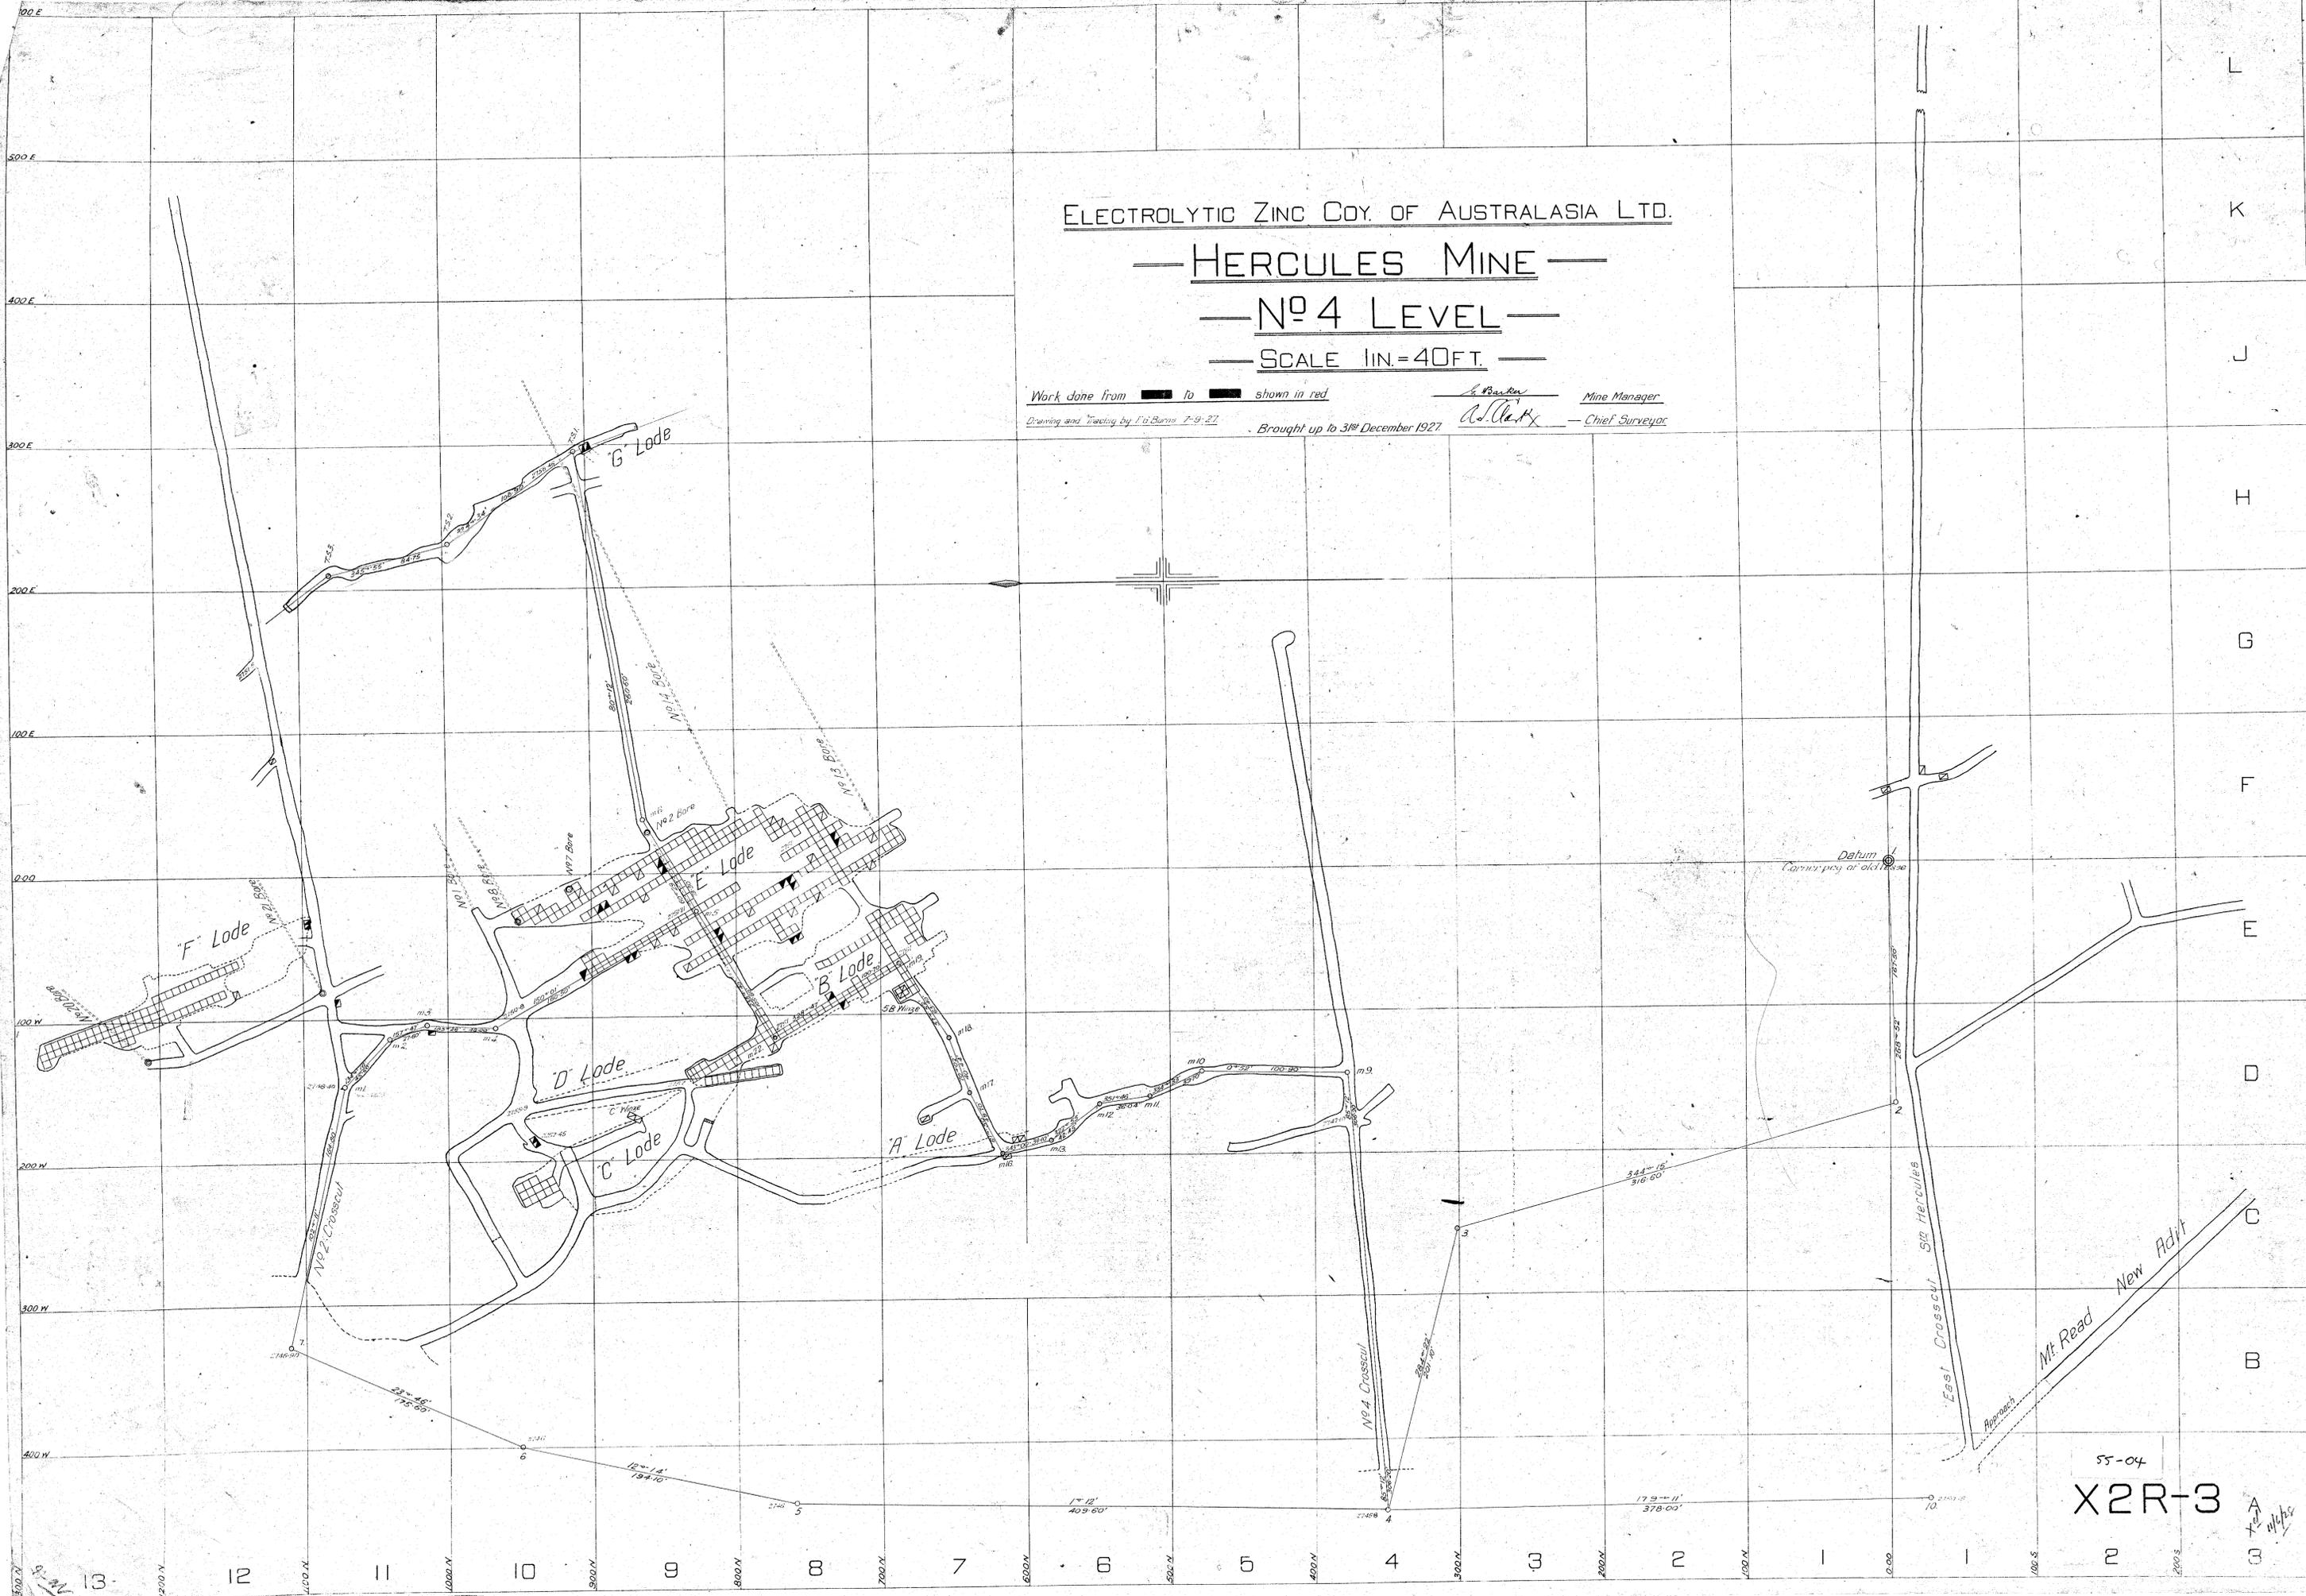

55-04  
 X2R-3

A  
 B  
 C