


55-05

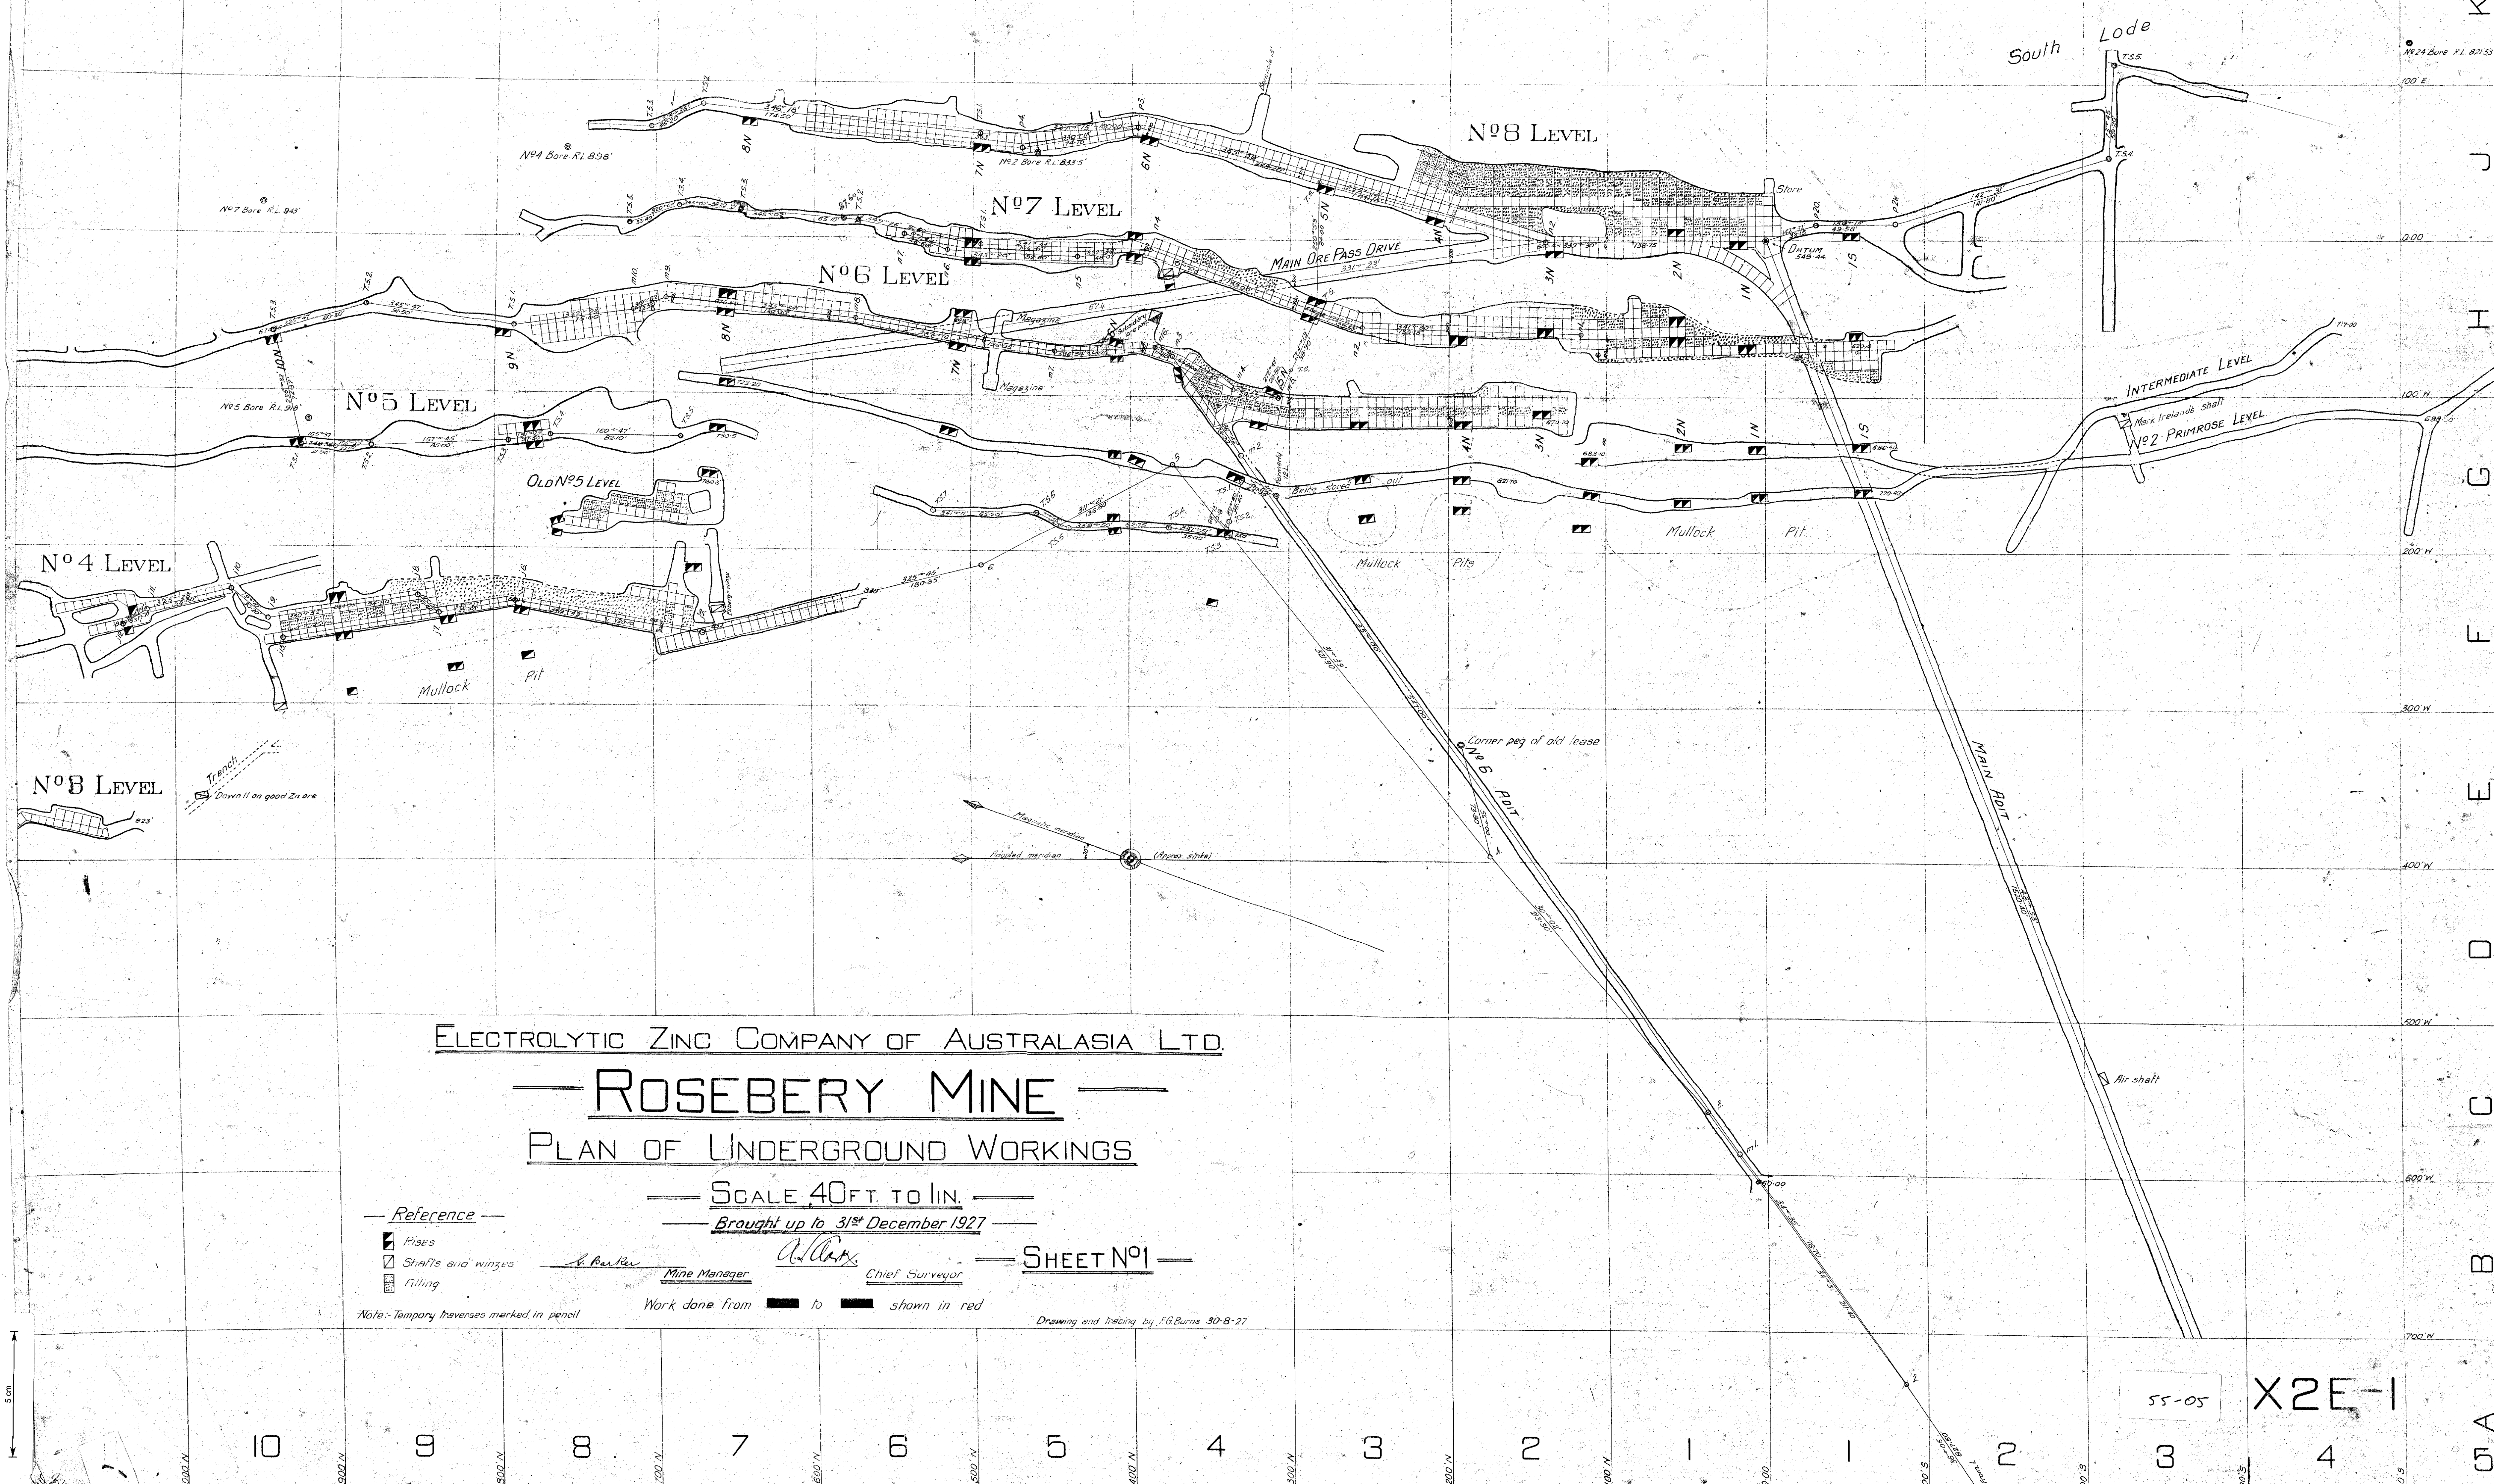

ELECTROLYTIC ZINC COMPANY OF AUSTRALASIA LTD.

— ROSEBERY MINE —

PLAN OF UNDERGROUND WORKINGS

SCALE 40 FT. TO IN.

Brought up to 31st December 1927

— Reference —

- ▣ Rises
- ▣ Shafts and winzes
- ▣ Filling

S. Carter

Mine Manager

A. J. Cox

Chief Surveyor

— SHEET N°1 —

Note: Temporary traverses marked in pencil

Work done from [] to [] shown in red

Drawing and tracing by F.G. Burns 50-B-27

55-05

X2E-1

10

9

8

7

6

5

4

3

2

1

1

2

3

4

A
B
C
D
E
F
G
H
I
J