

ELECTROLYTIC ZINC COMPANY OF AUSTRALASIA LTD

HERCULES MINE

No 5 Level

SCALE 40 FEET TO 1 INCH


Work done from [] to [] shown in red

Drawing and tracing by E.G.S.M. 1-10-27

A. C. [] Chief Surveyor

A. Barker Mine Manager

Brought up to 31st December 1927

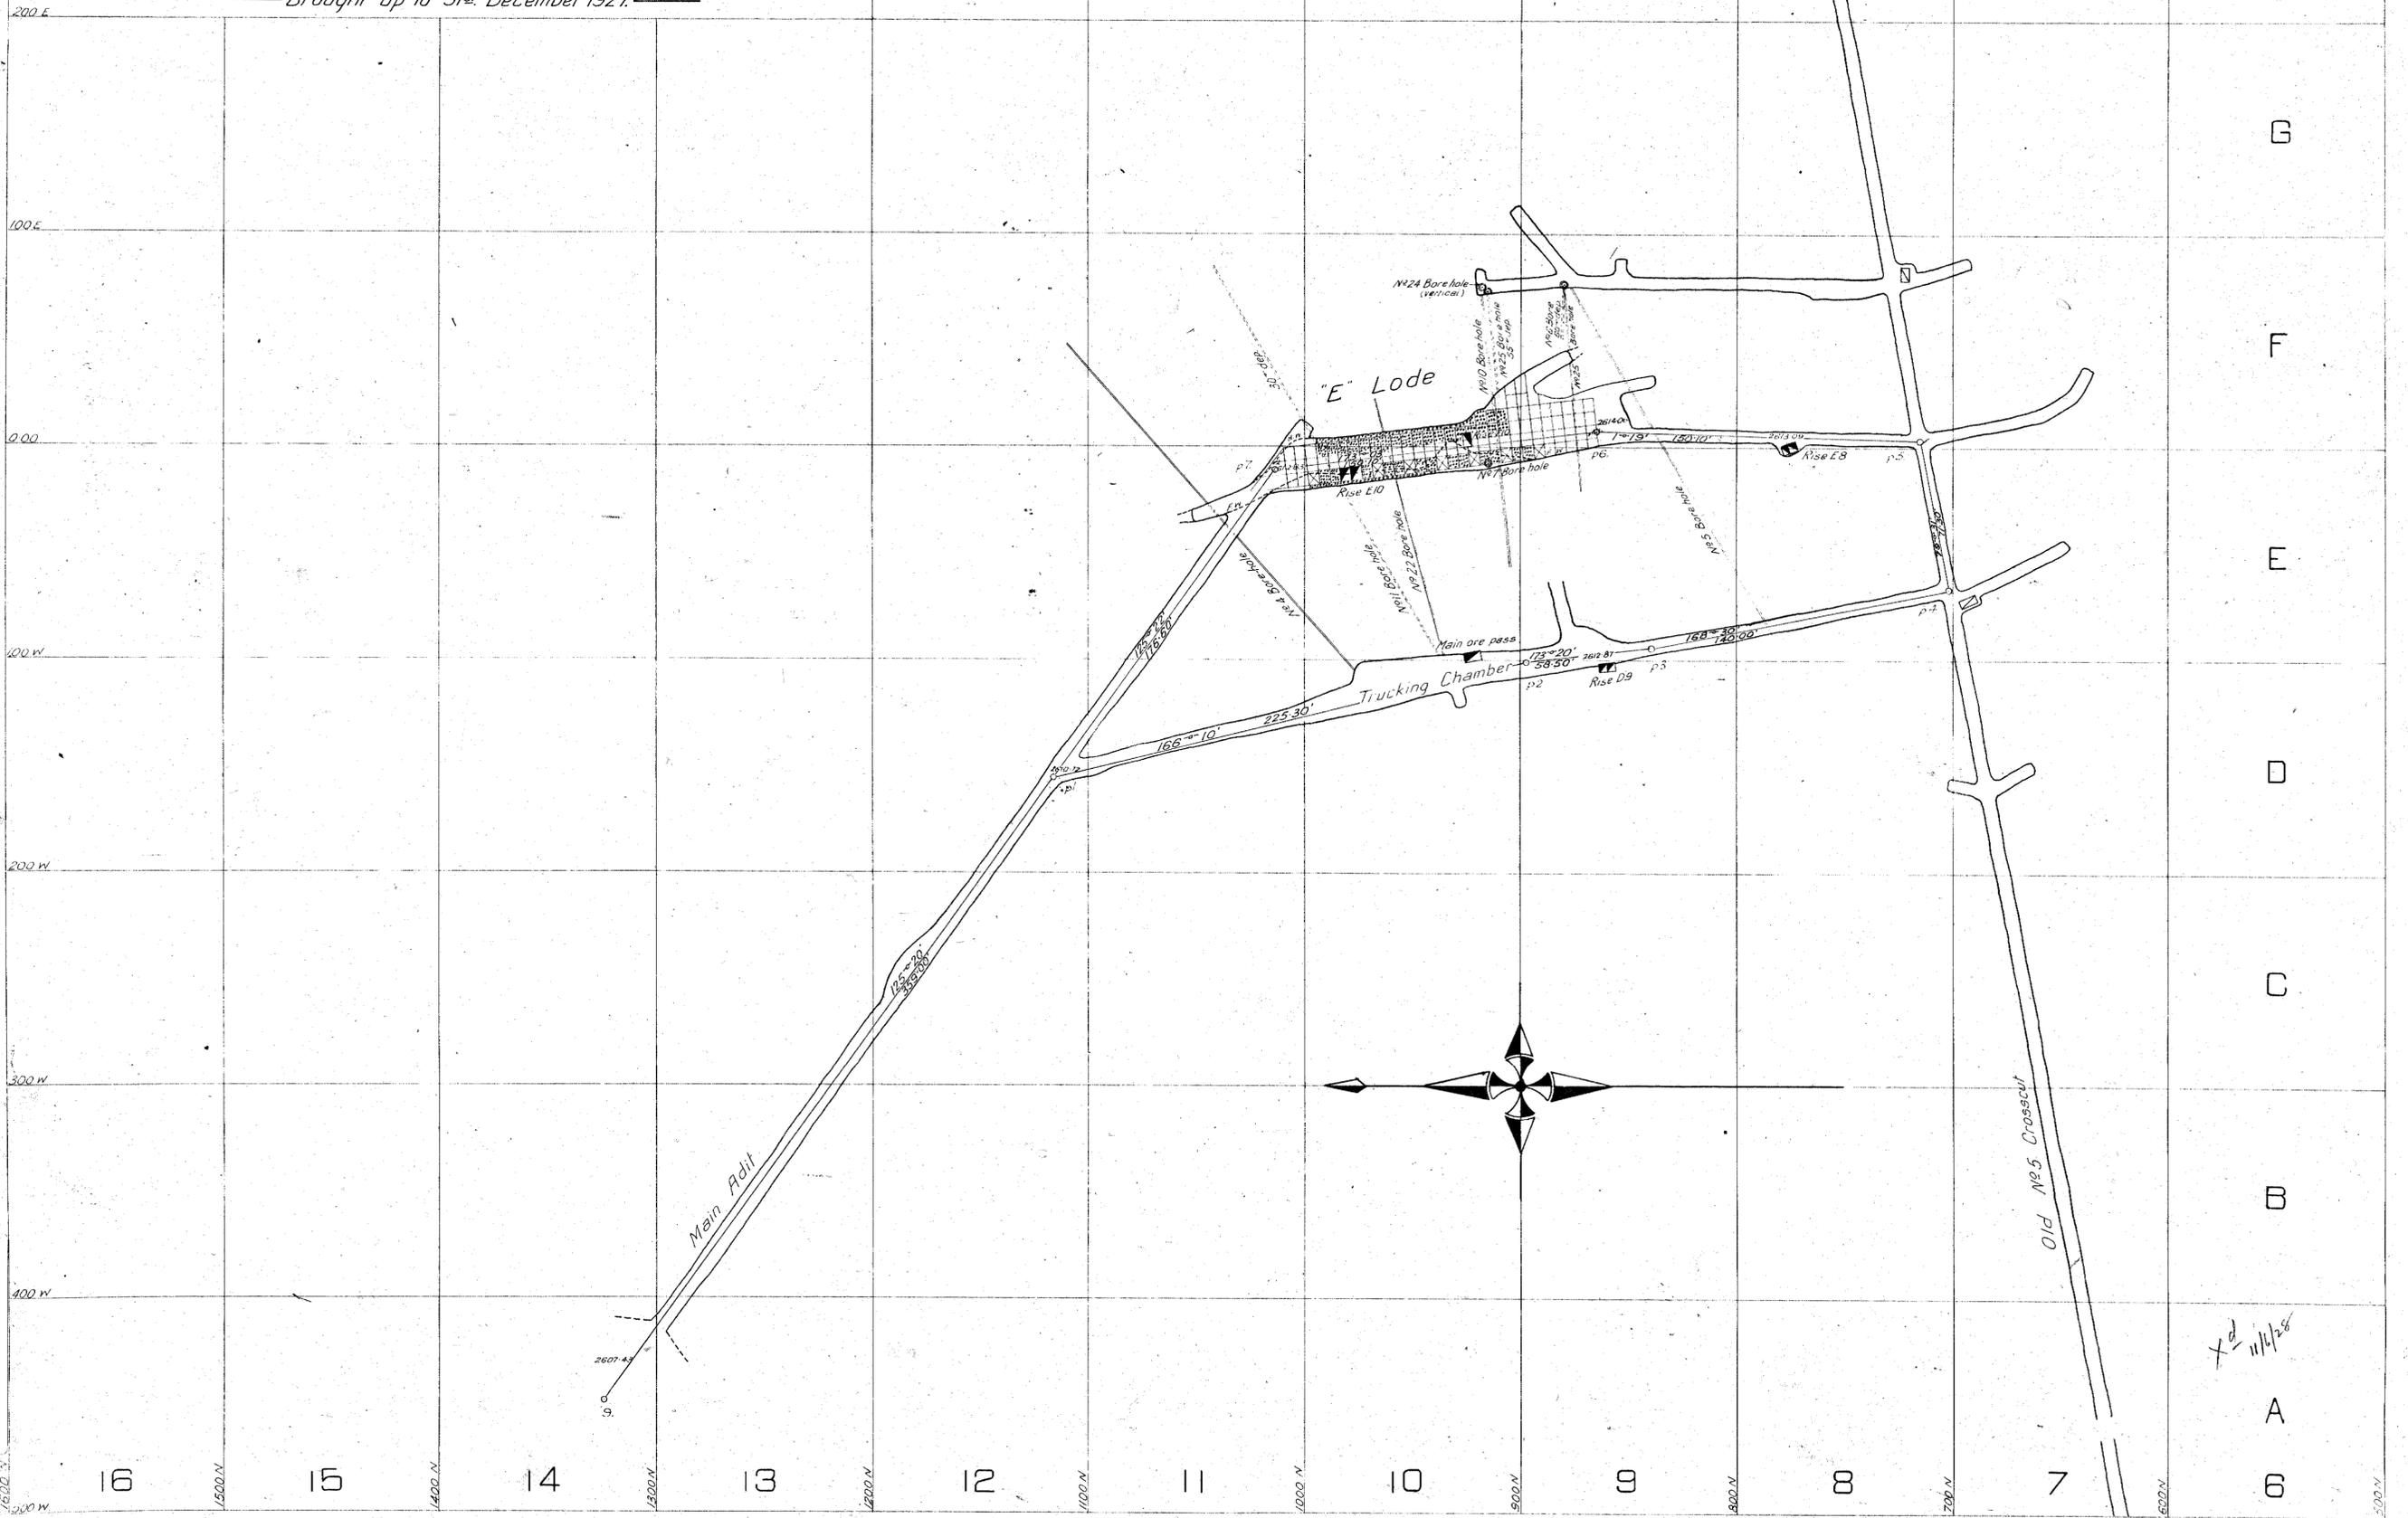

X^d 11/1/28