

ELECTROLYTIC ZINC COMPANY OF AUSTRALASIA LTD

HERCULES MINE

No 3 Level

SCALE 40 FEET TO 1 INCH



Work done from [redacted] to [redacted] shown in red

Drawing and tracing by F.G. Burns 9-11-27

A. Clark Chief Surveyor

A. Barker Mine Manager

Brought up to 31st December 1927

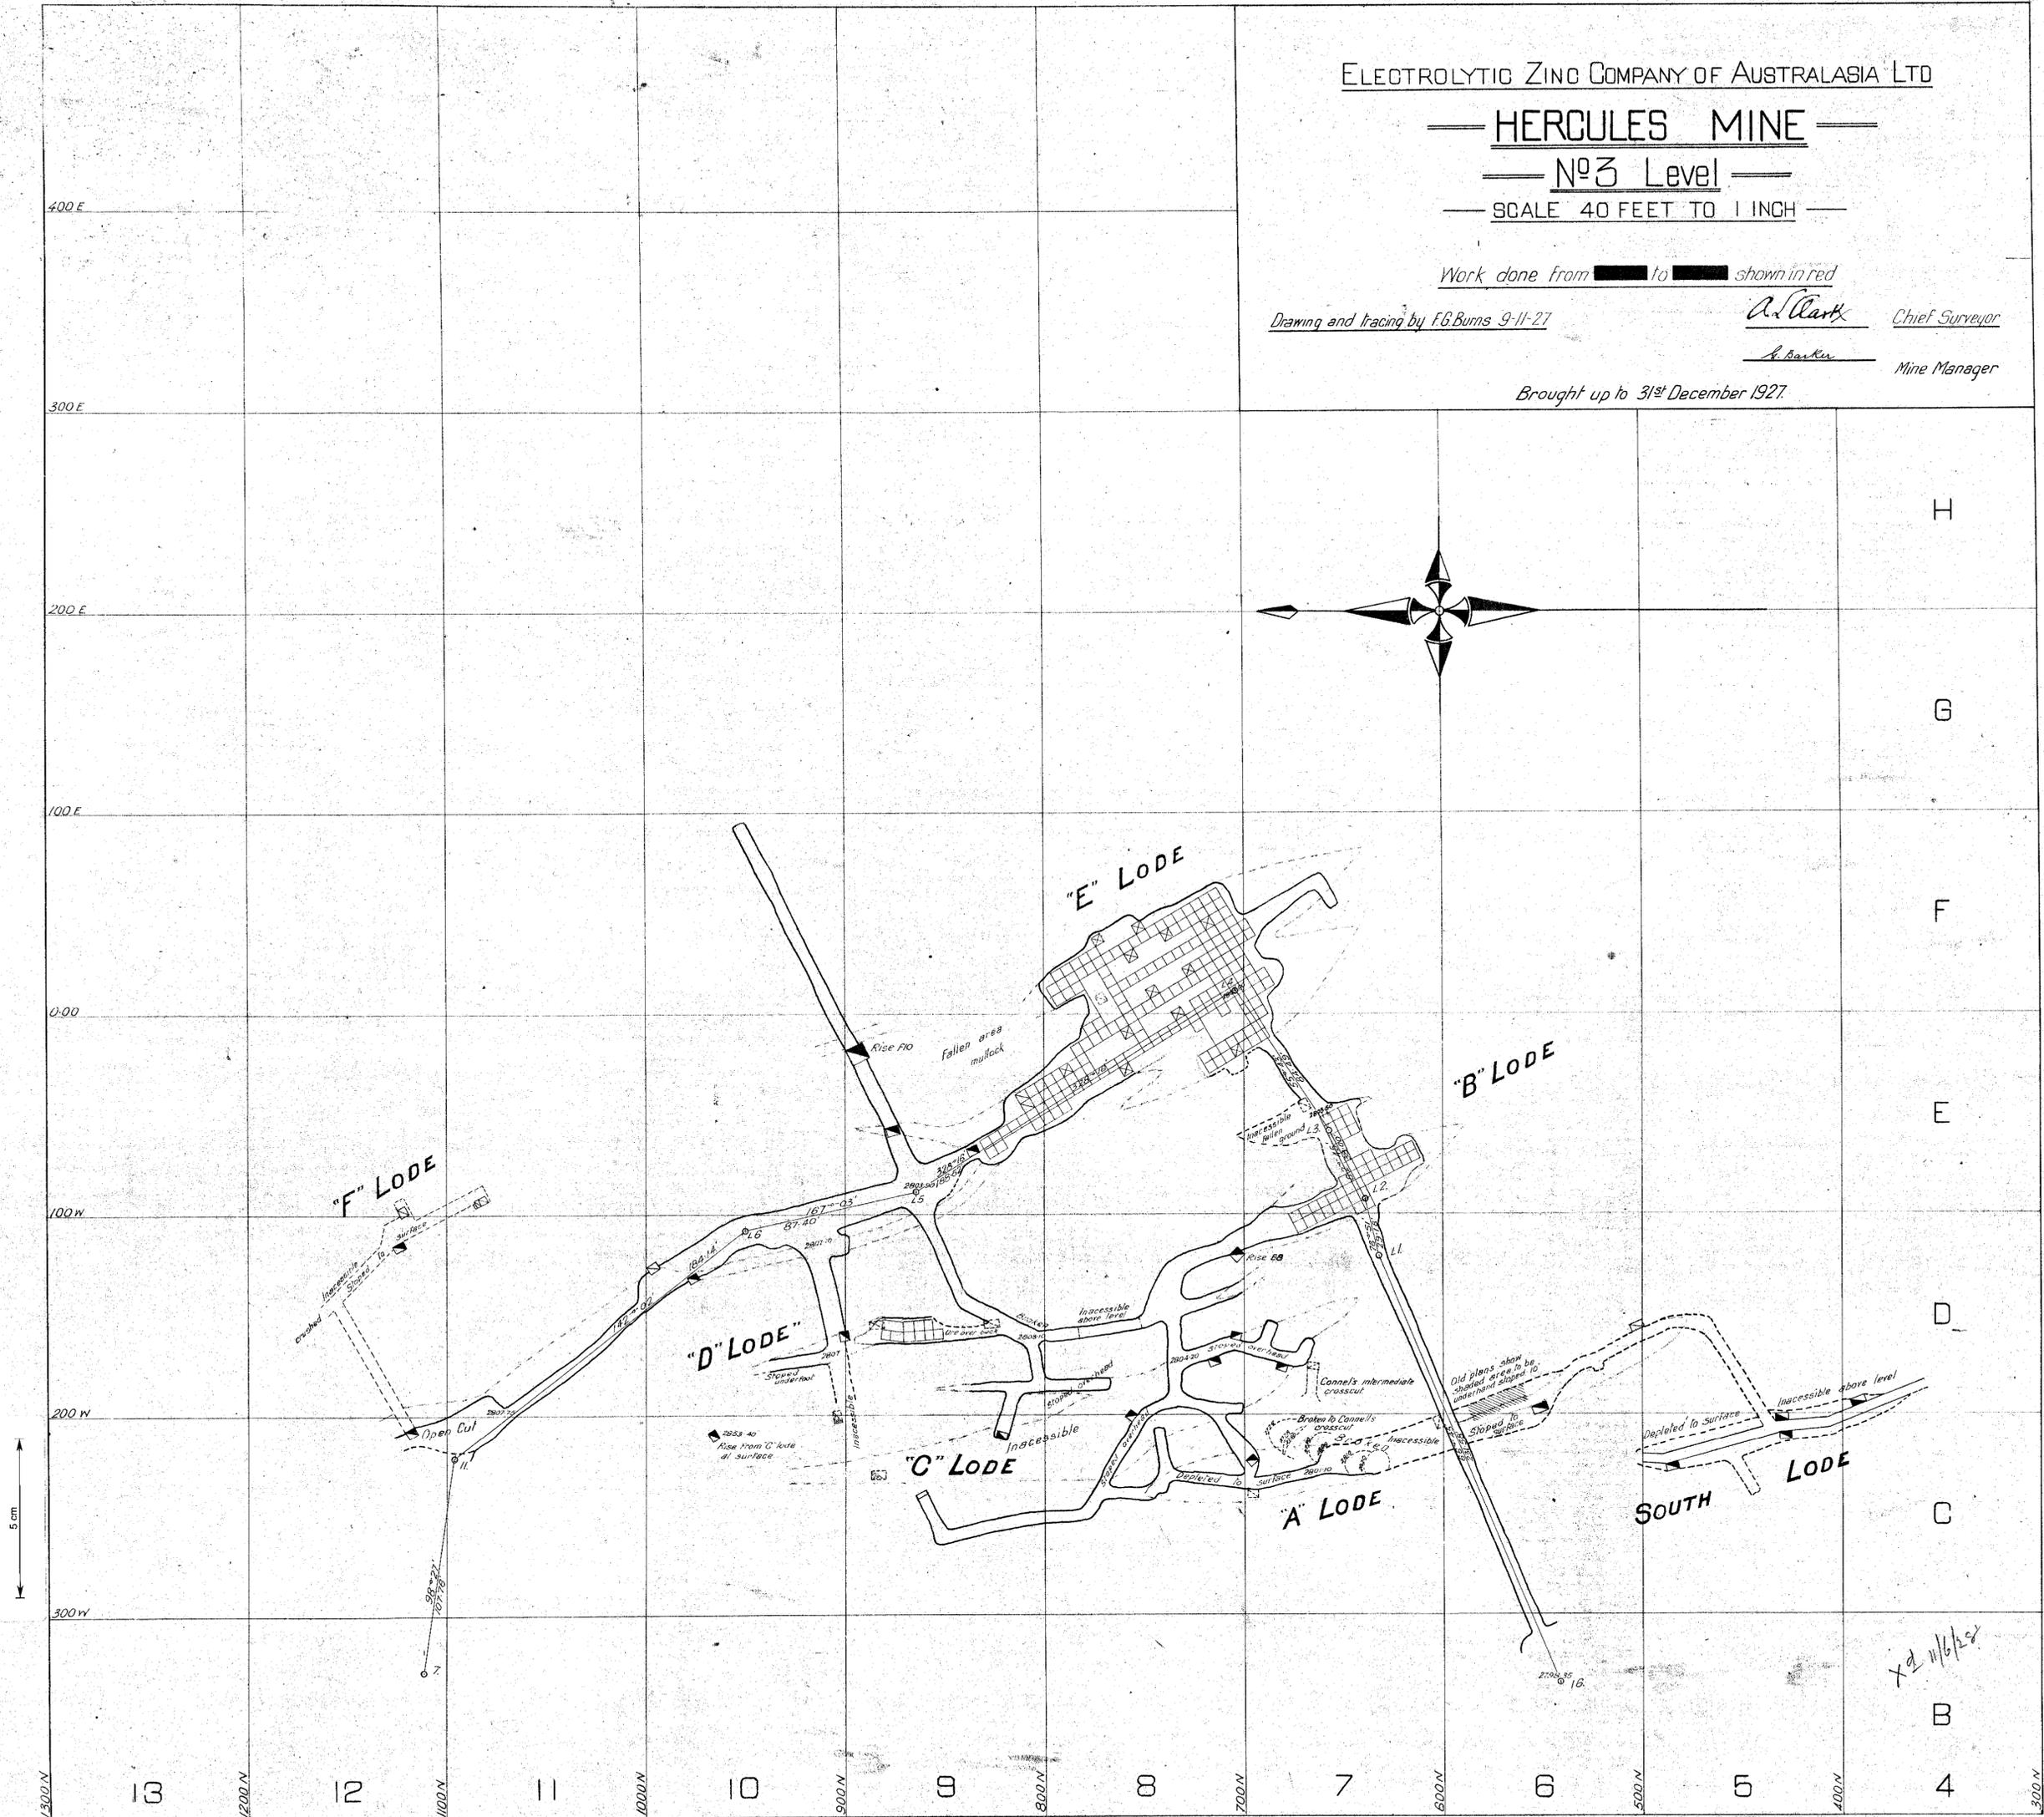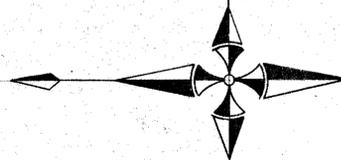

Handwritten initials 'F.G.B.' in the bottom left corner.

55-10 X2R-4