

ELECTROLYTIC ZINC COMPANY OF AUSTRALASIA LTD.

# HERCULES MINE

## — No 5a Level —

SCALE 40 FEET TO 1 INCH

Work done from ████ to ████ show in red



Drawing and tracing by F.G. Burns 16-9-26

*A. Cart* — Chief Surveyor

*L. Barker* — Mine Manager

Brought up to 31<sup>st</sup> December 1927

55-11

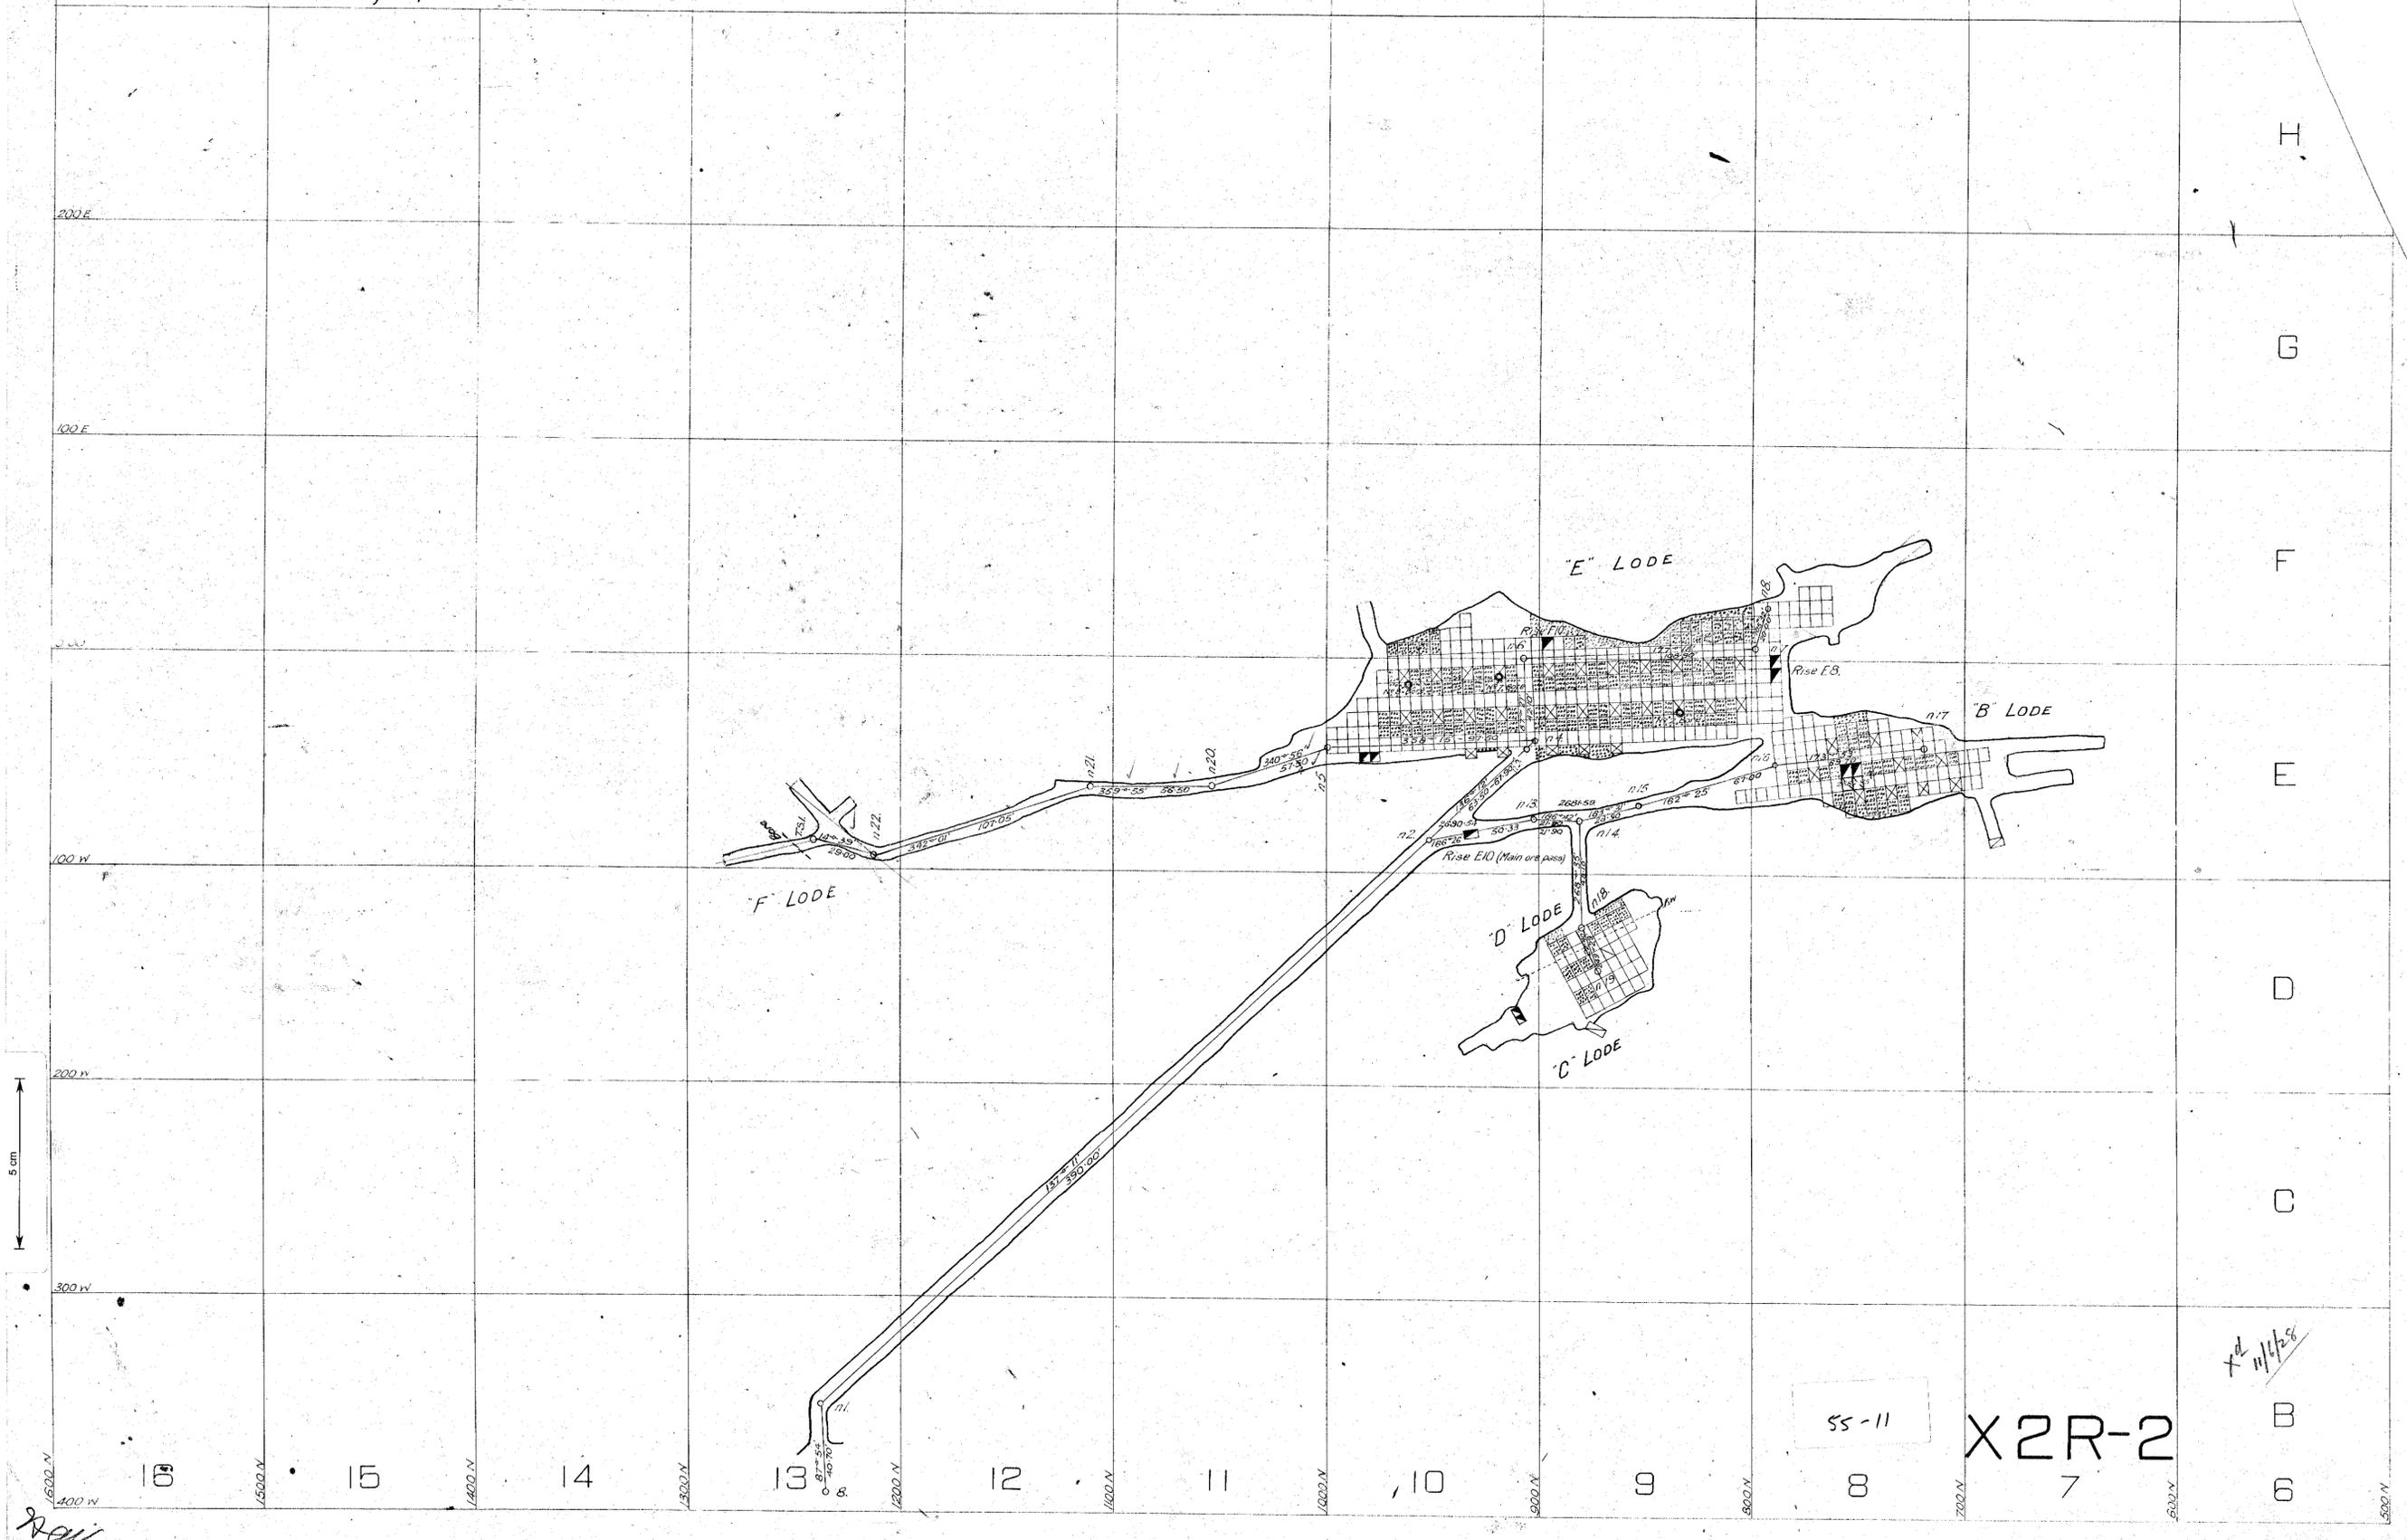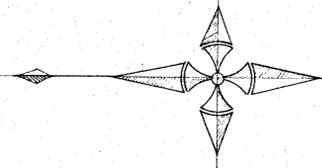

55-11

X2R-2

*X<sup>d</sup> 11/1/28*

*rai*