


55-12

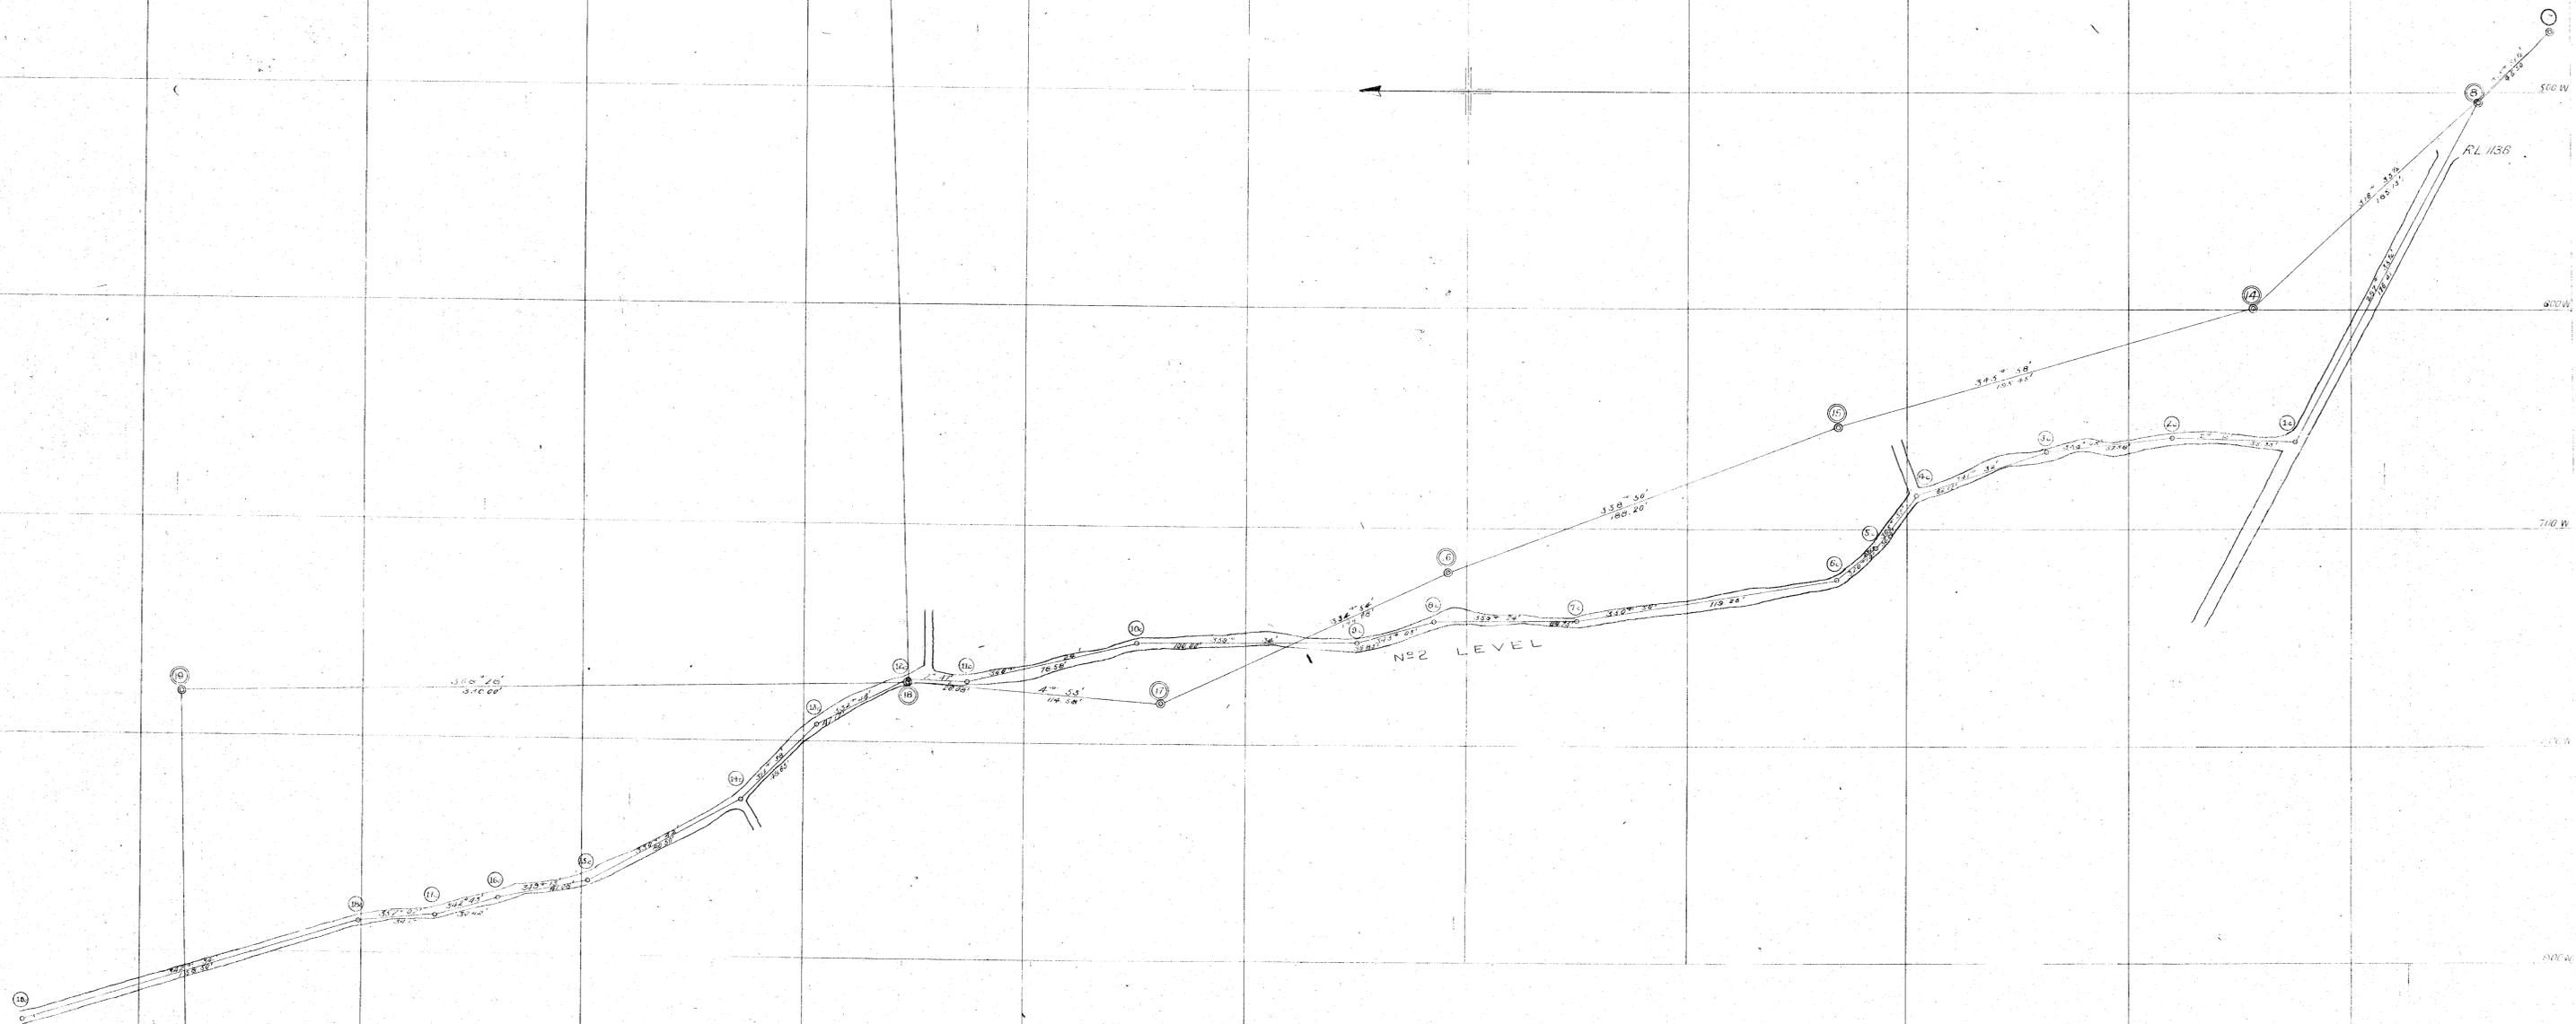

ELECTROLYTIC ZINC COMPANY OF AUSTRALASIA LTD.

— ROSEBERY MINE —

PLAN OF UNDERGROUND WORKINGS

Scale 1 in = 30 ft

Certified correct-

A. Parker

For Tasmanian Govt. Mines Dept.

W. D. ...
R. ...

SHEET No 3

Brought up to 30th September 1926
31st December

55-12