

Electrolytic Zinc Company of Australasia Ltd.


LONGITUDINAL SECTION - ROSEBERY MINE

Scale 1" = 50'

Work done from 31-12-24 to 31-12-25 shown in red

Certified correct:-

H. Burns, Asst. Surveyor.
G. Barker, M. Eng.

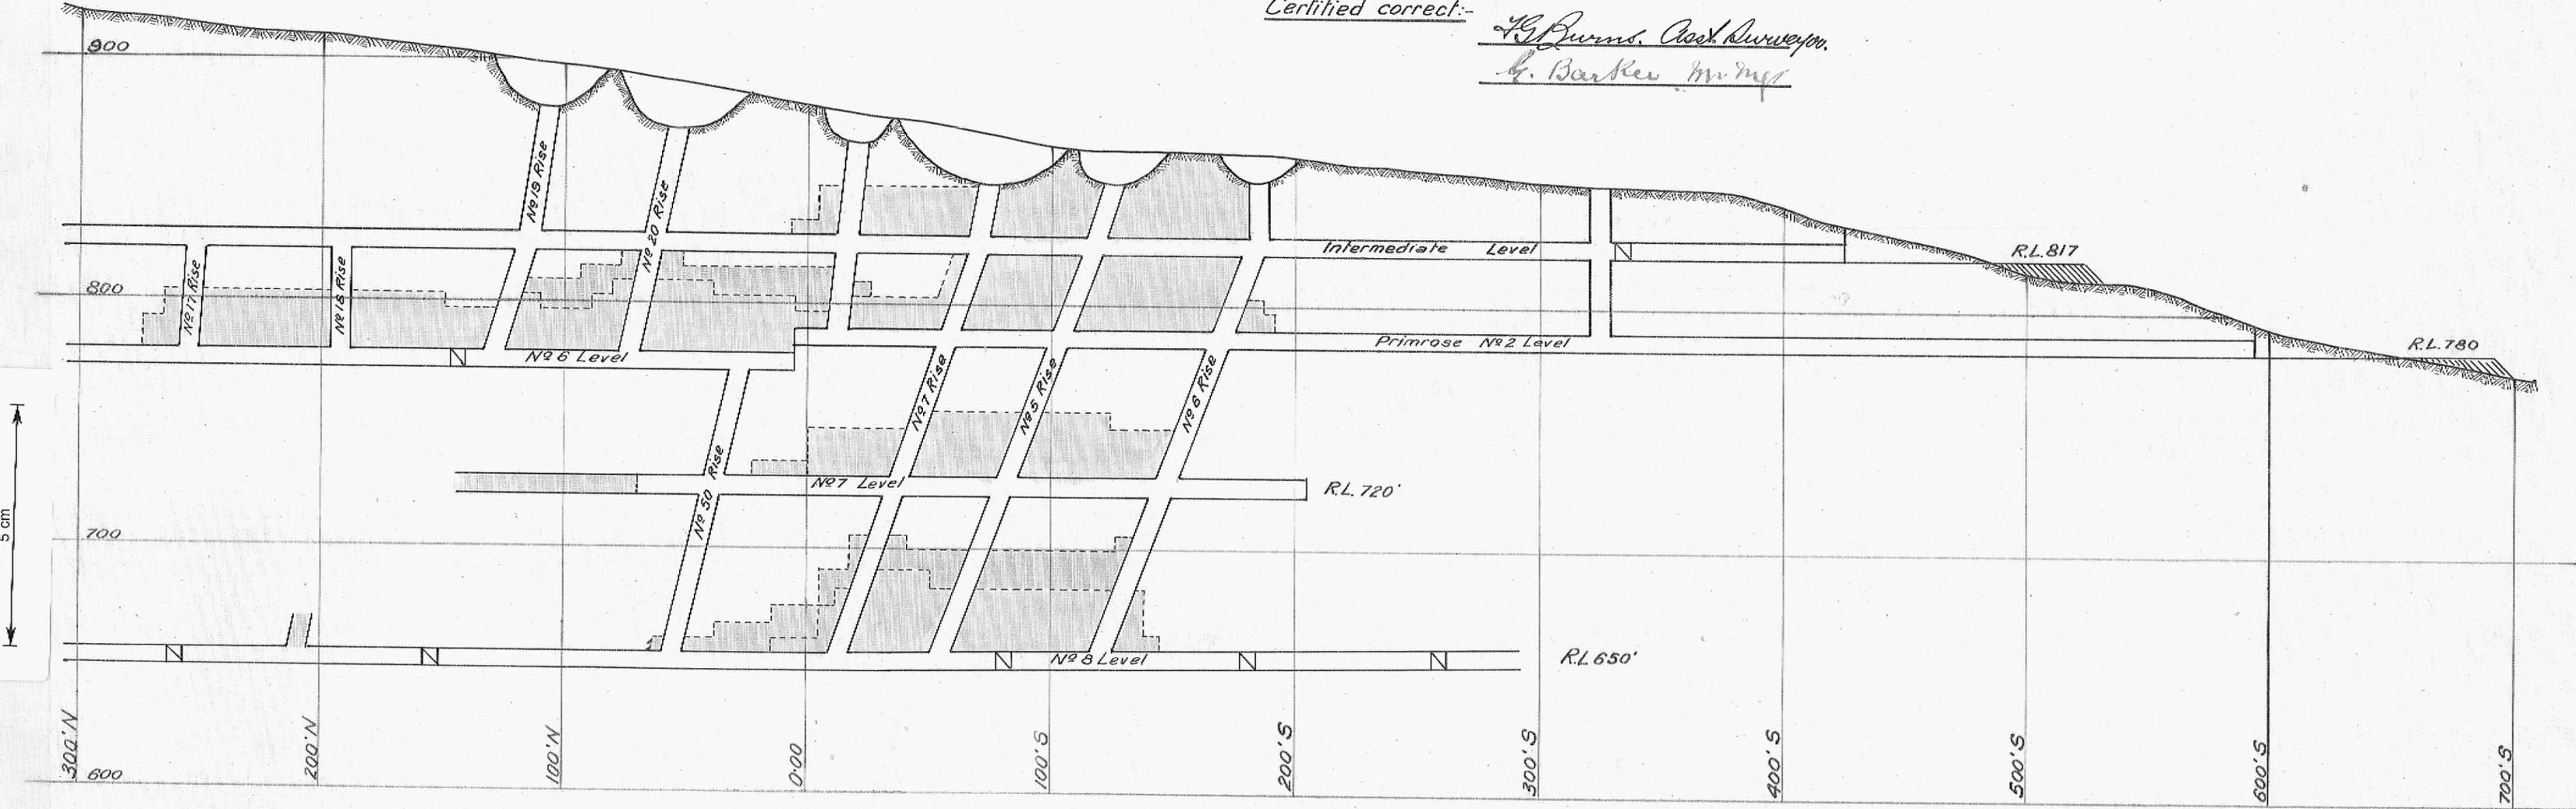

55-20