


5 cm

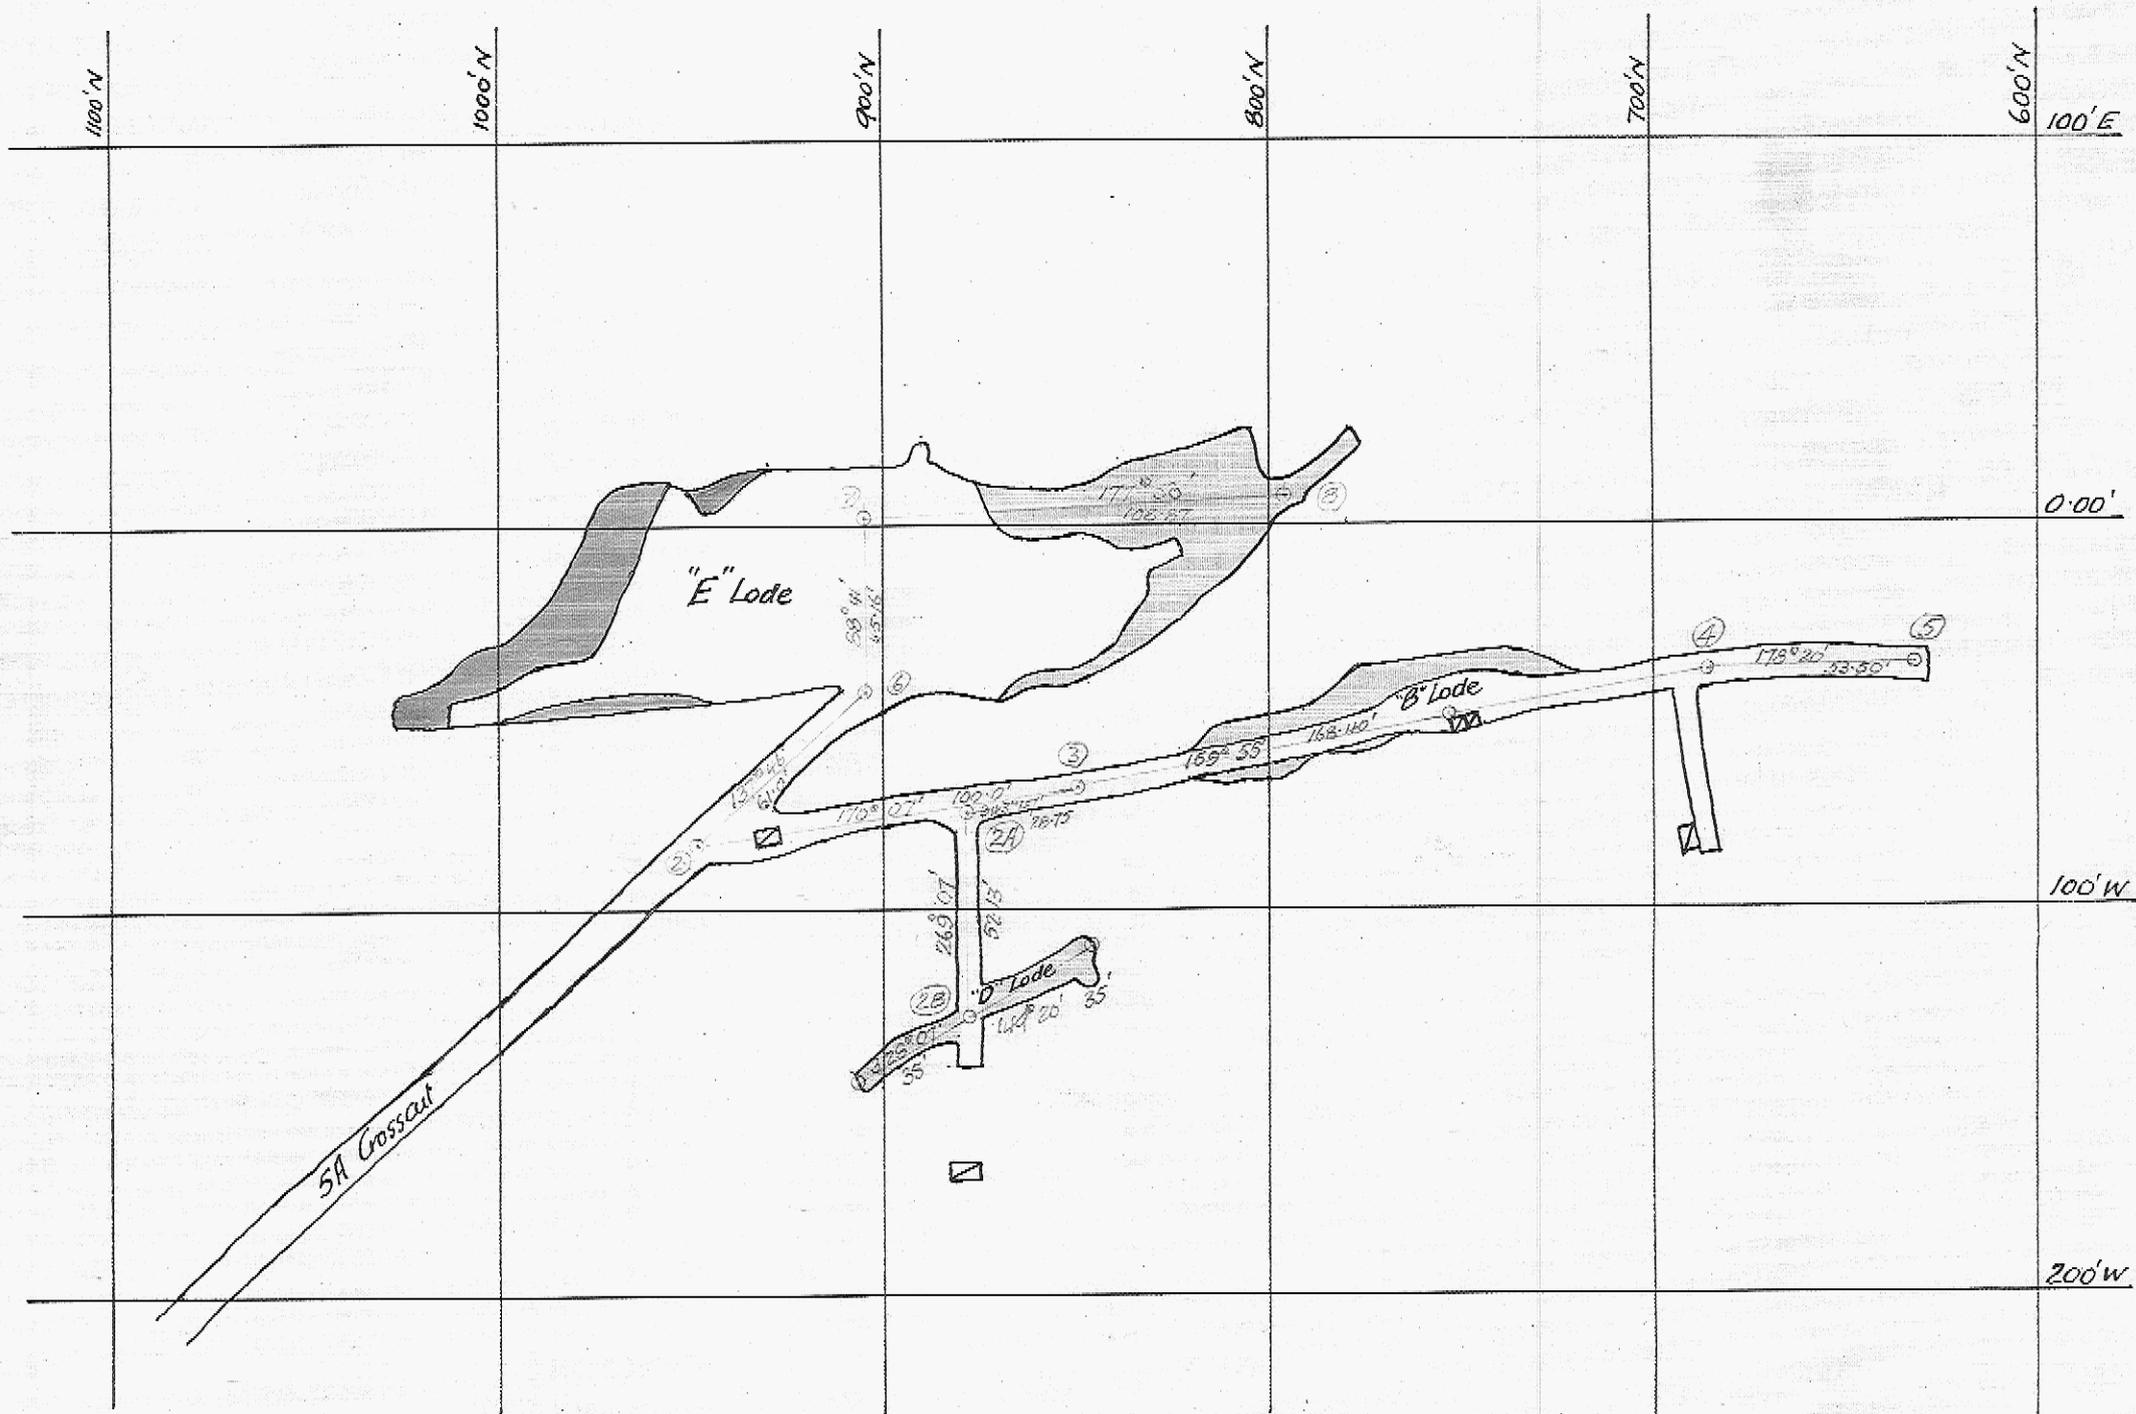

Electrolytic Zinc Company of Australasia Ltd.

Certified correct:-

H. Burns *Asst. Surveyor*
G. Barker *in charge*

HERCULES MINE-5A level
 Work done from 31-12-24 to 31-12-25 shown in red

Scale 1" = 50'

55-23