


HERCULES MINE

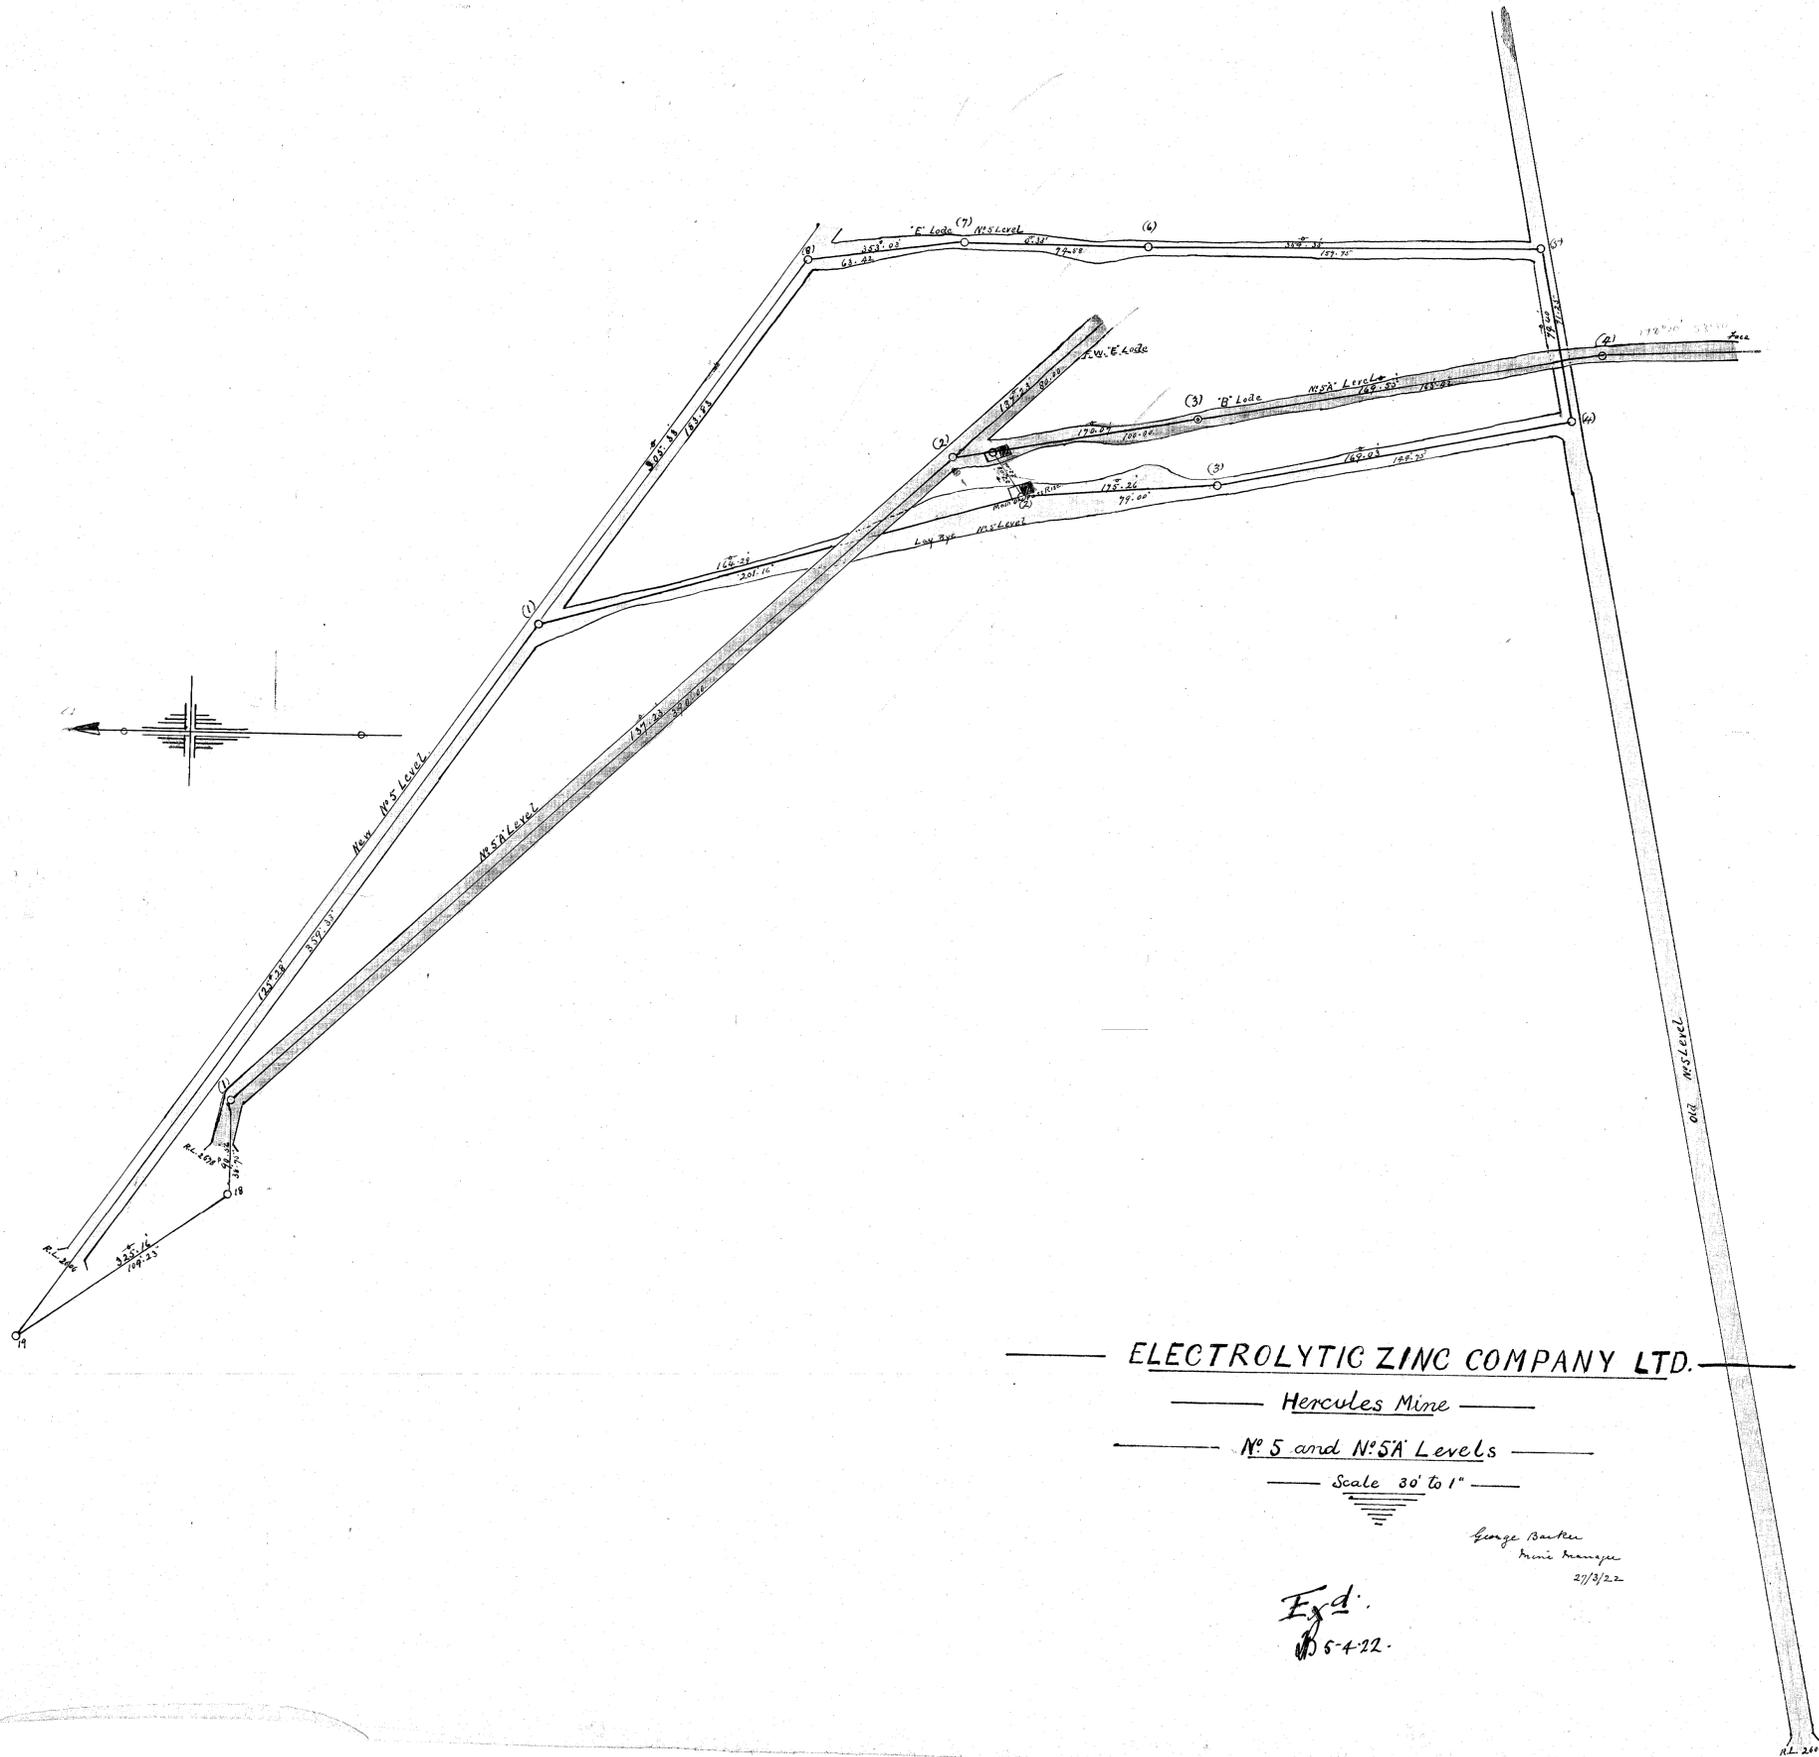

ELECTROLYTIC ZINC COMPANY LTD.

Hercules Mine

No. 5 and No. 5A Levels

Scale 30' to 1"

George Barker
Mine Manager
27/3/22

Exd.
B 5-4-22

55-24