


5 cm

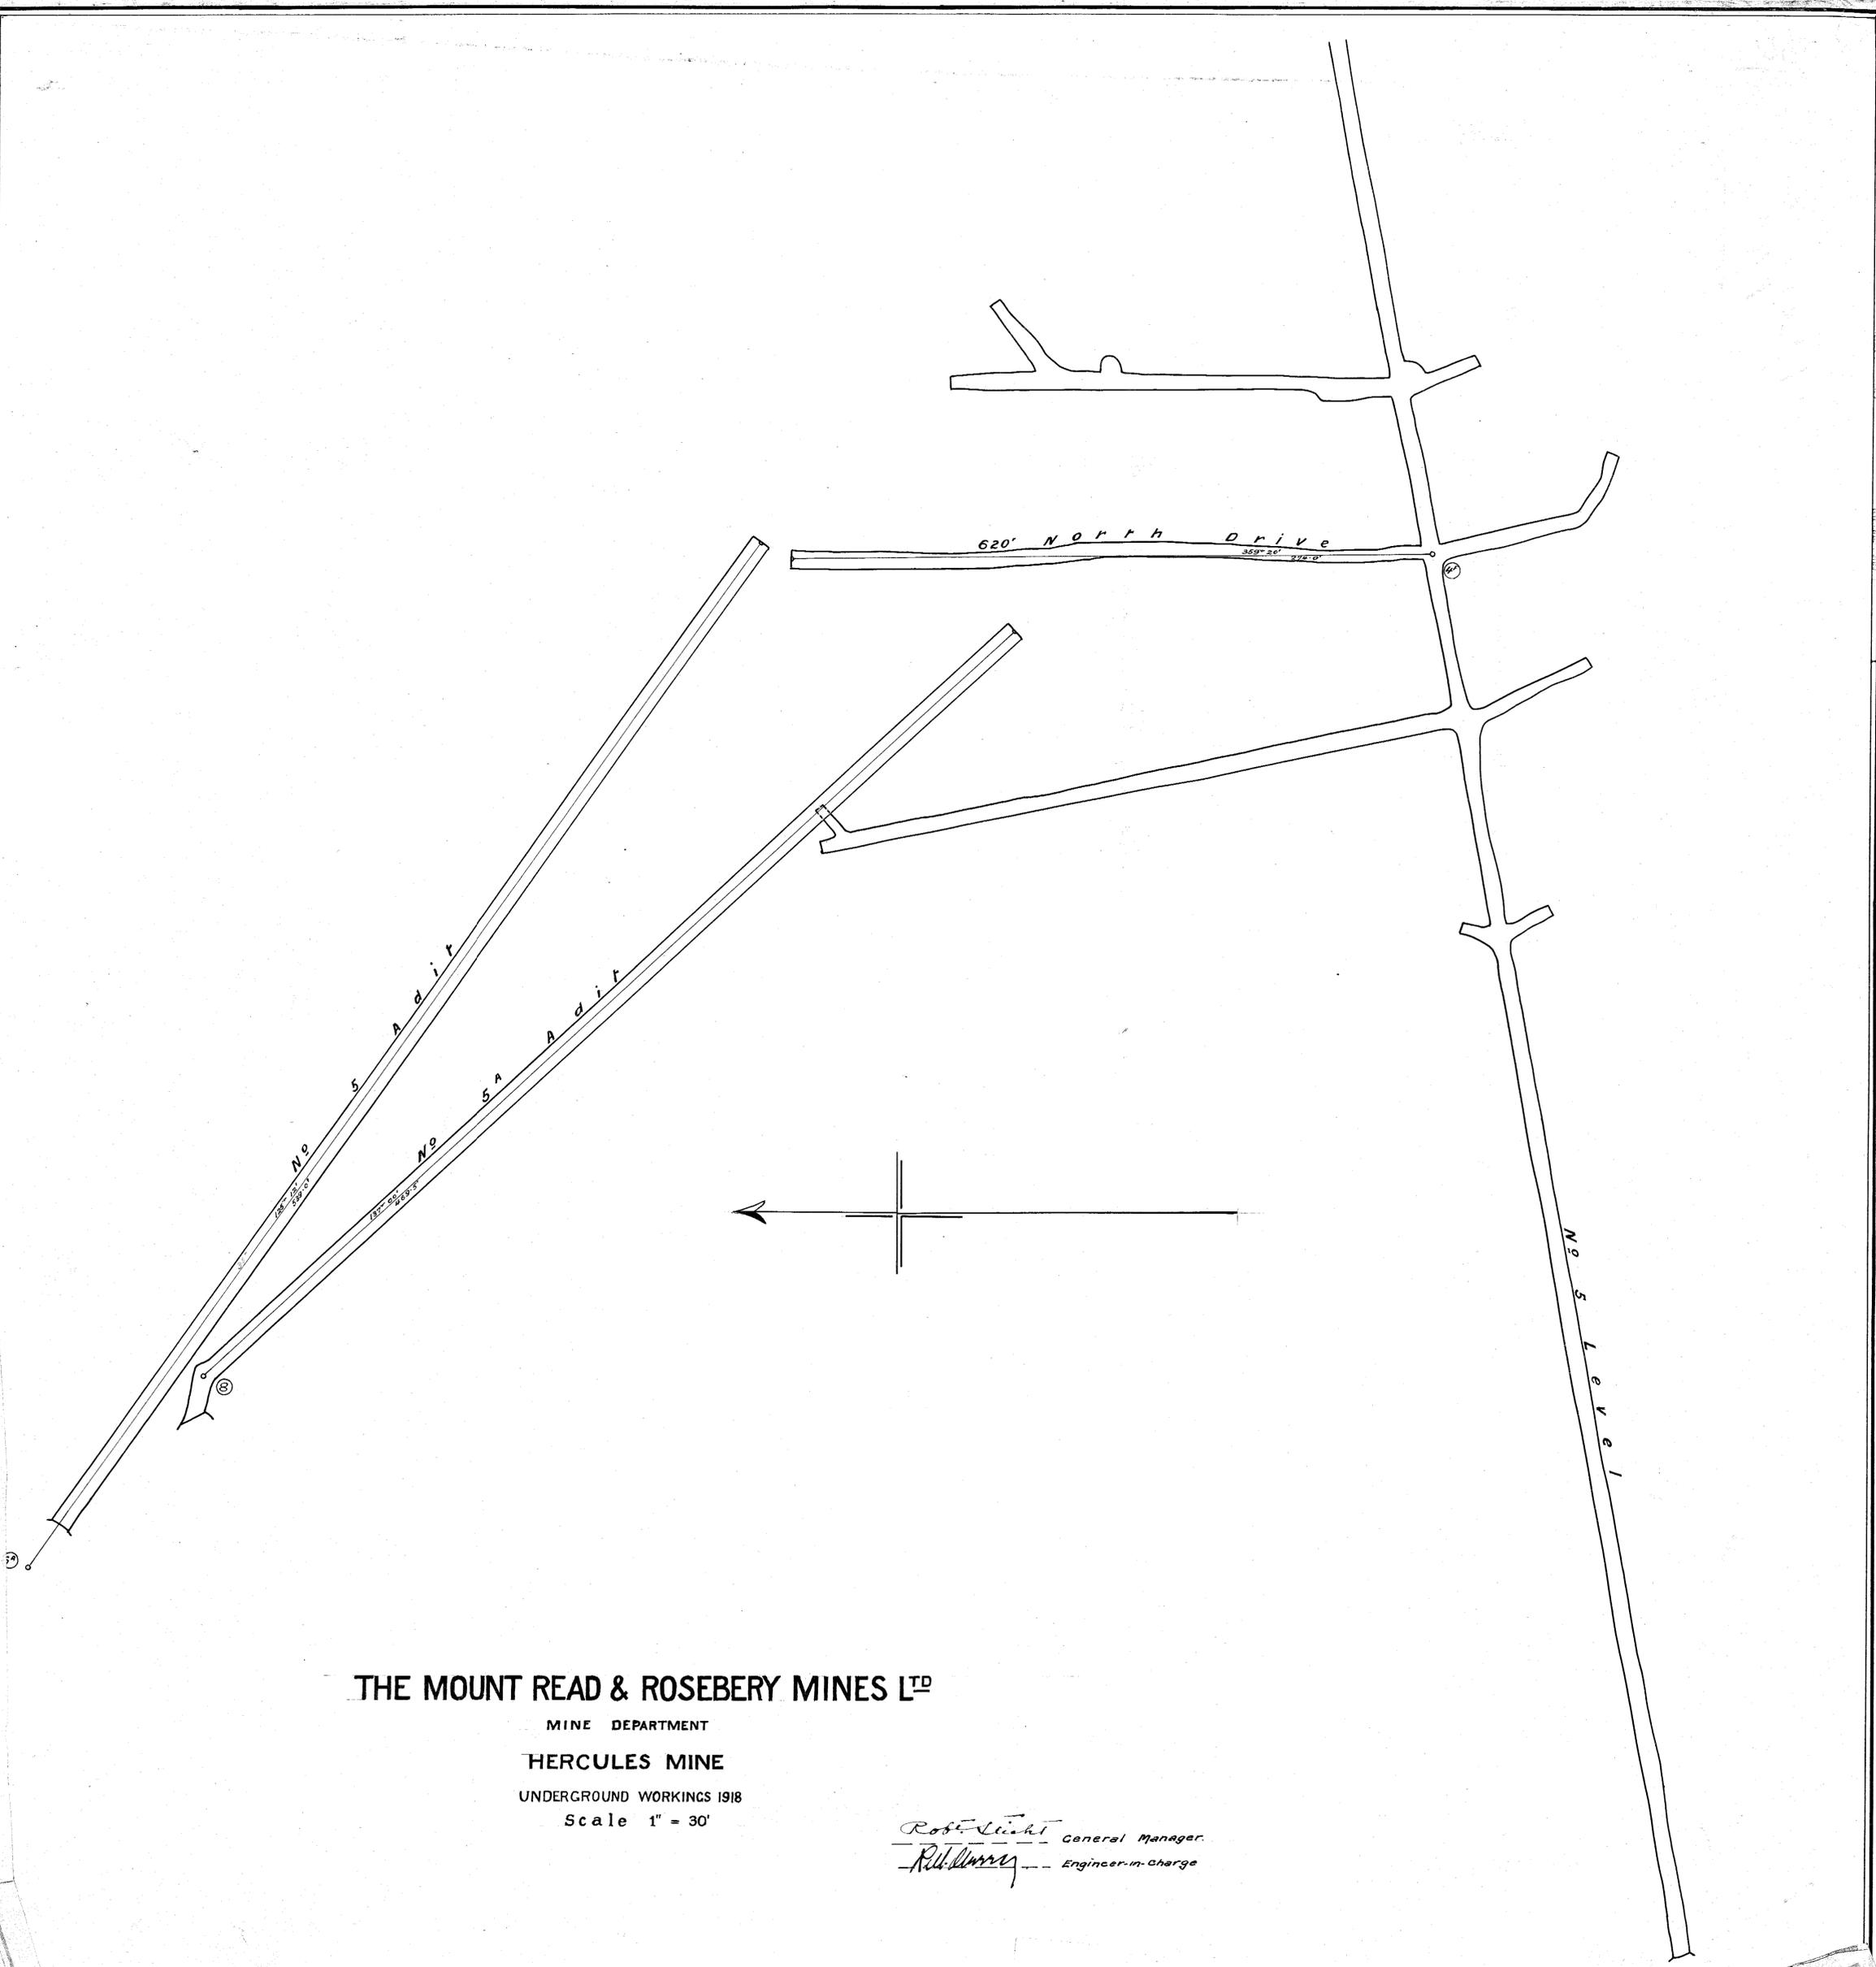

THE MOUNT READ & ROSEBERY MINES LTD

MINE DEPARTMENT

HERCULES MINE

UNDERGROUND WORKINGS 1918

Scale 1" = 30'

Robt. Link General Manager.
R. L. Murray Engineer-in-charge