


55-30

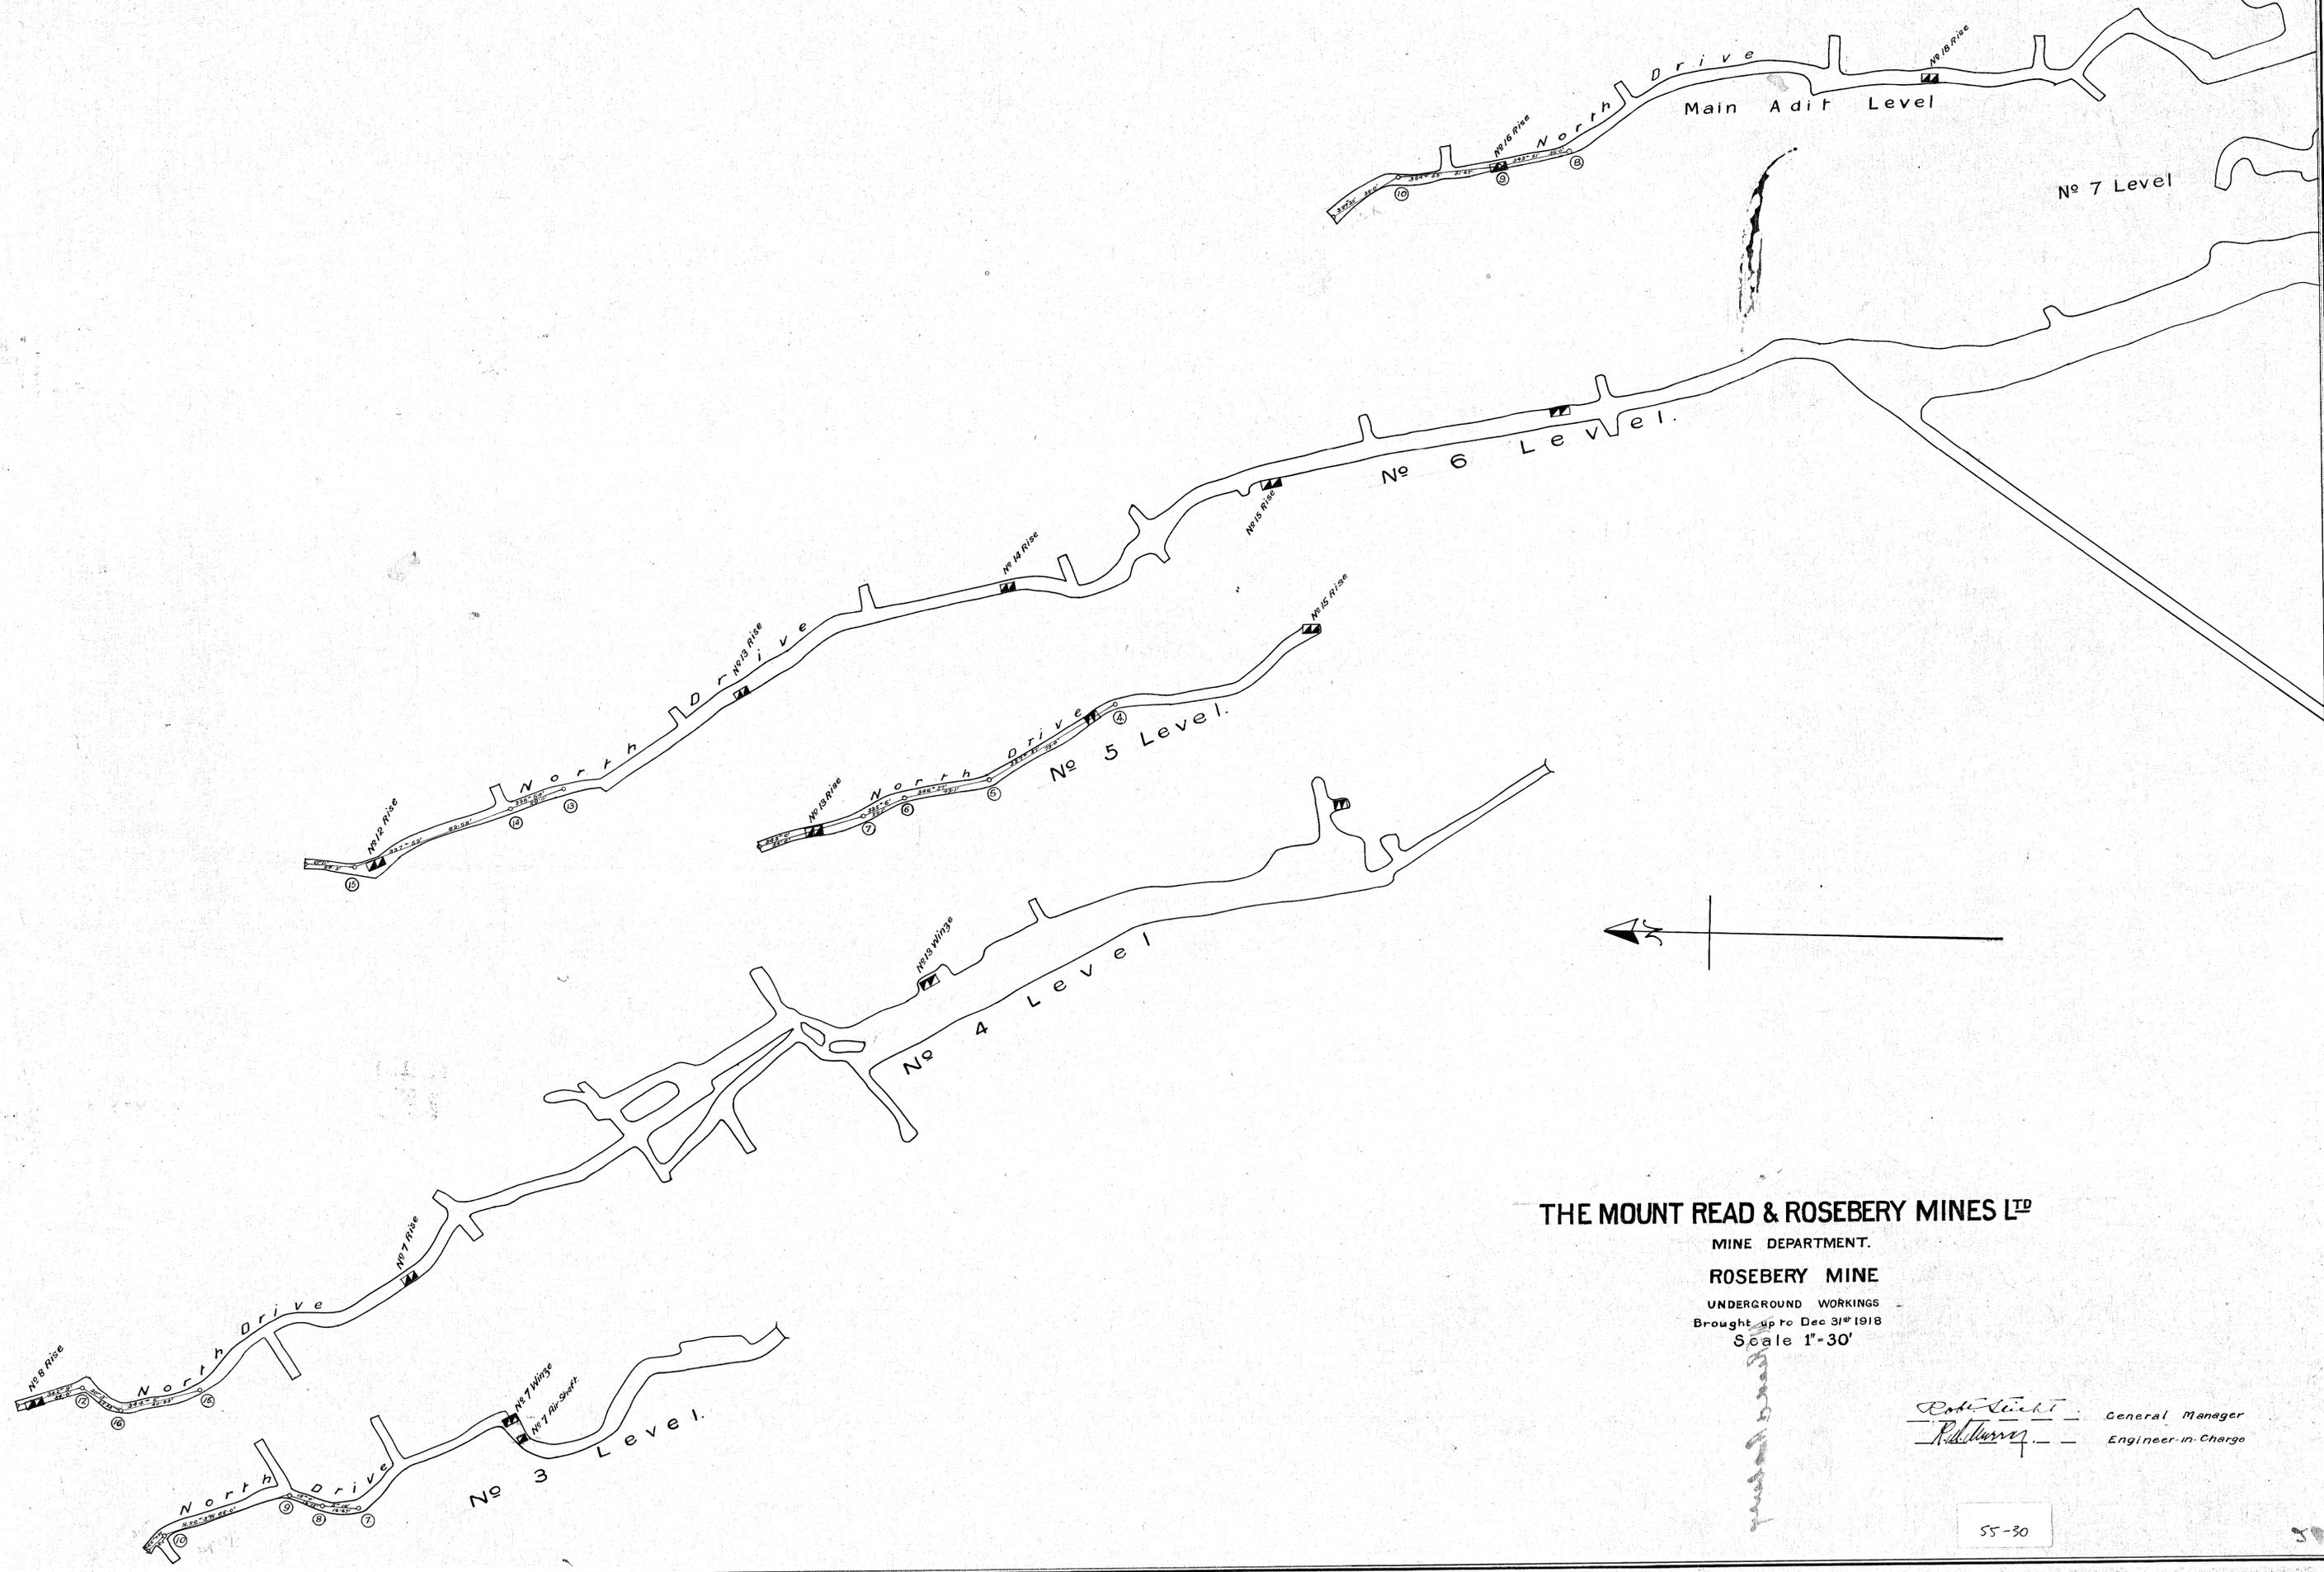

5 cm

THE MOUNT READ & ROSEBERY MINES LTD

MINE DEPARTMENT.

ROSEBERY MINE

UNDERGROUND WORKINGS
Brought up to Dec 31st 1918

Scale 1"=30'

Robert Licht General Manager
Robert Murray Engineer-in-Charge

55-30

5