

55-37

ELECTROLYTIC ZINC COMPANY OF AUSTRALASIA LTD.

HERCULES MINE

No 5a Level

SCALE 40 FEET TO 1 INCH

J. M. Foster 1955
J. M. Foster 1954
A. Pearson 1953
Edmund 1951
C. J. ... 1949
L. J. ... 1946
L. J. ... 1946


Work done from [] to [] shown in red

Drawing and tracing by F.G. Burns 16-9-26

A. G. ...
- Chief Surveyor
G. Banker Mine Manager

Brought up to 31st Dec 1928
Brought up to 31st Dec 1929 A.P.

"	"	"	1930	L.P.
"	"	"	1936	L.P.
"	"	"	1937	L.P.
"	"	"	1938	L.P.
"	"	"	1939	L.P.
"	"	"	1940	L.P.
"	"	"	1941	L.P.
"	"	"	1942	L.P.
"	"	"	1943	L.P.
"	"	"	1944	L.P.
"	"	"	1945	L.P.
"	"	"	1946	L.P.
"	"	"	1947	L.P.
"	"	"	1948	L.P.
"	"	"	1949	L.P.
"	"	"	1951	L.P.
"	"	"	1953	L.M.
"	"	"	1954	L.M.
"	"	"	1955	L.M.

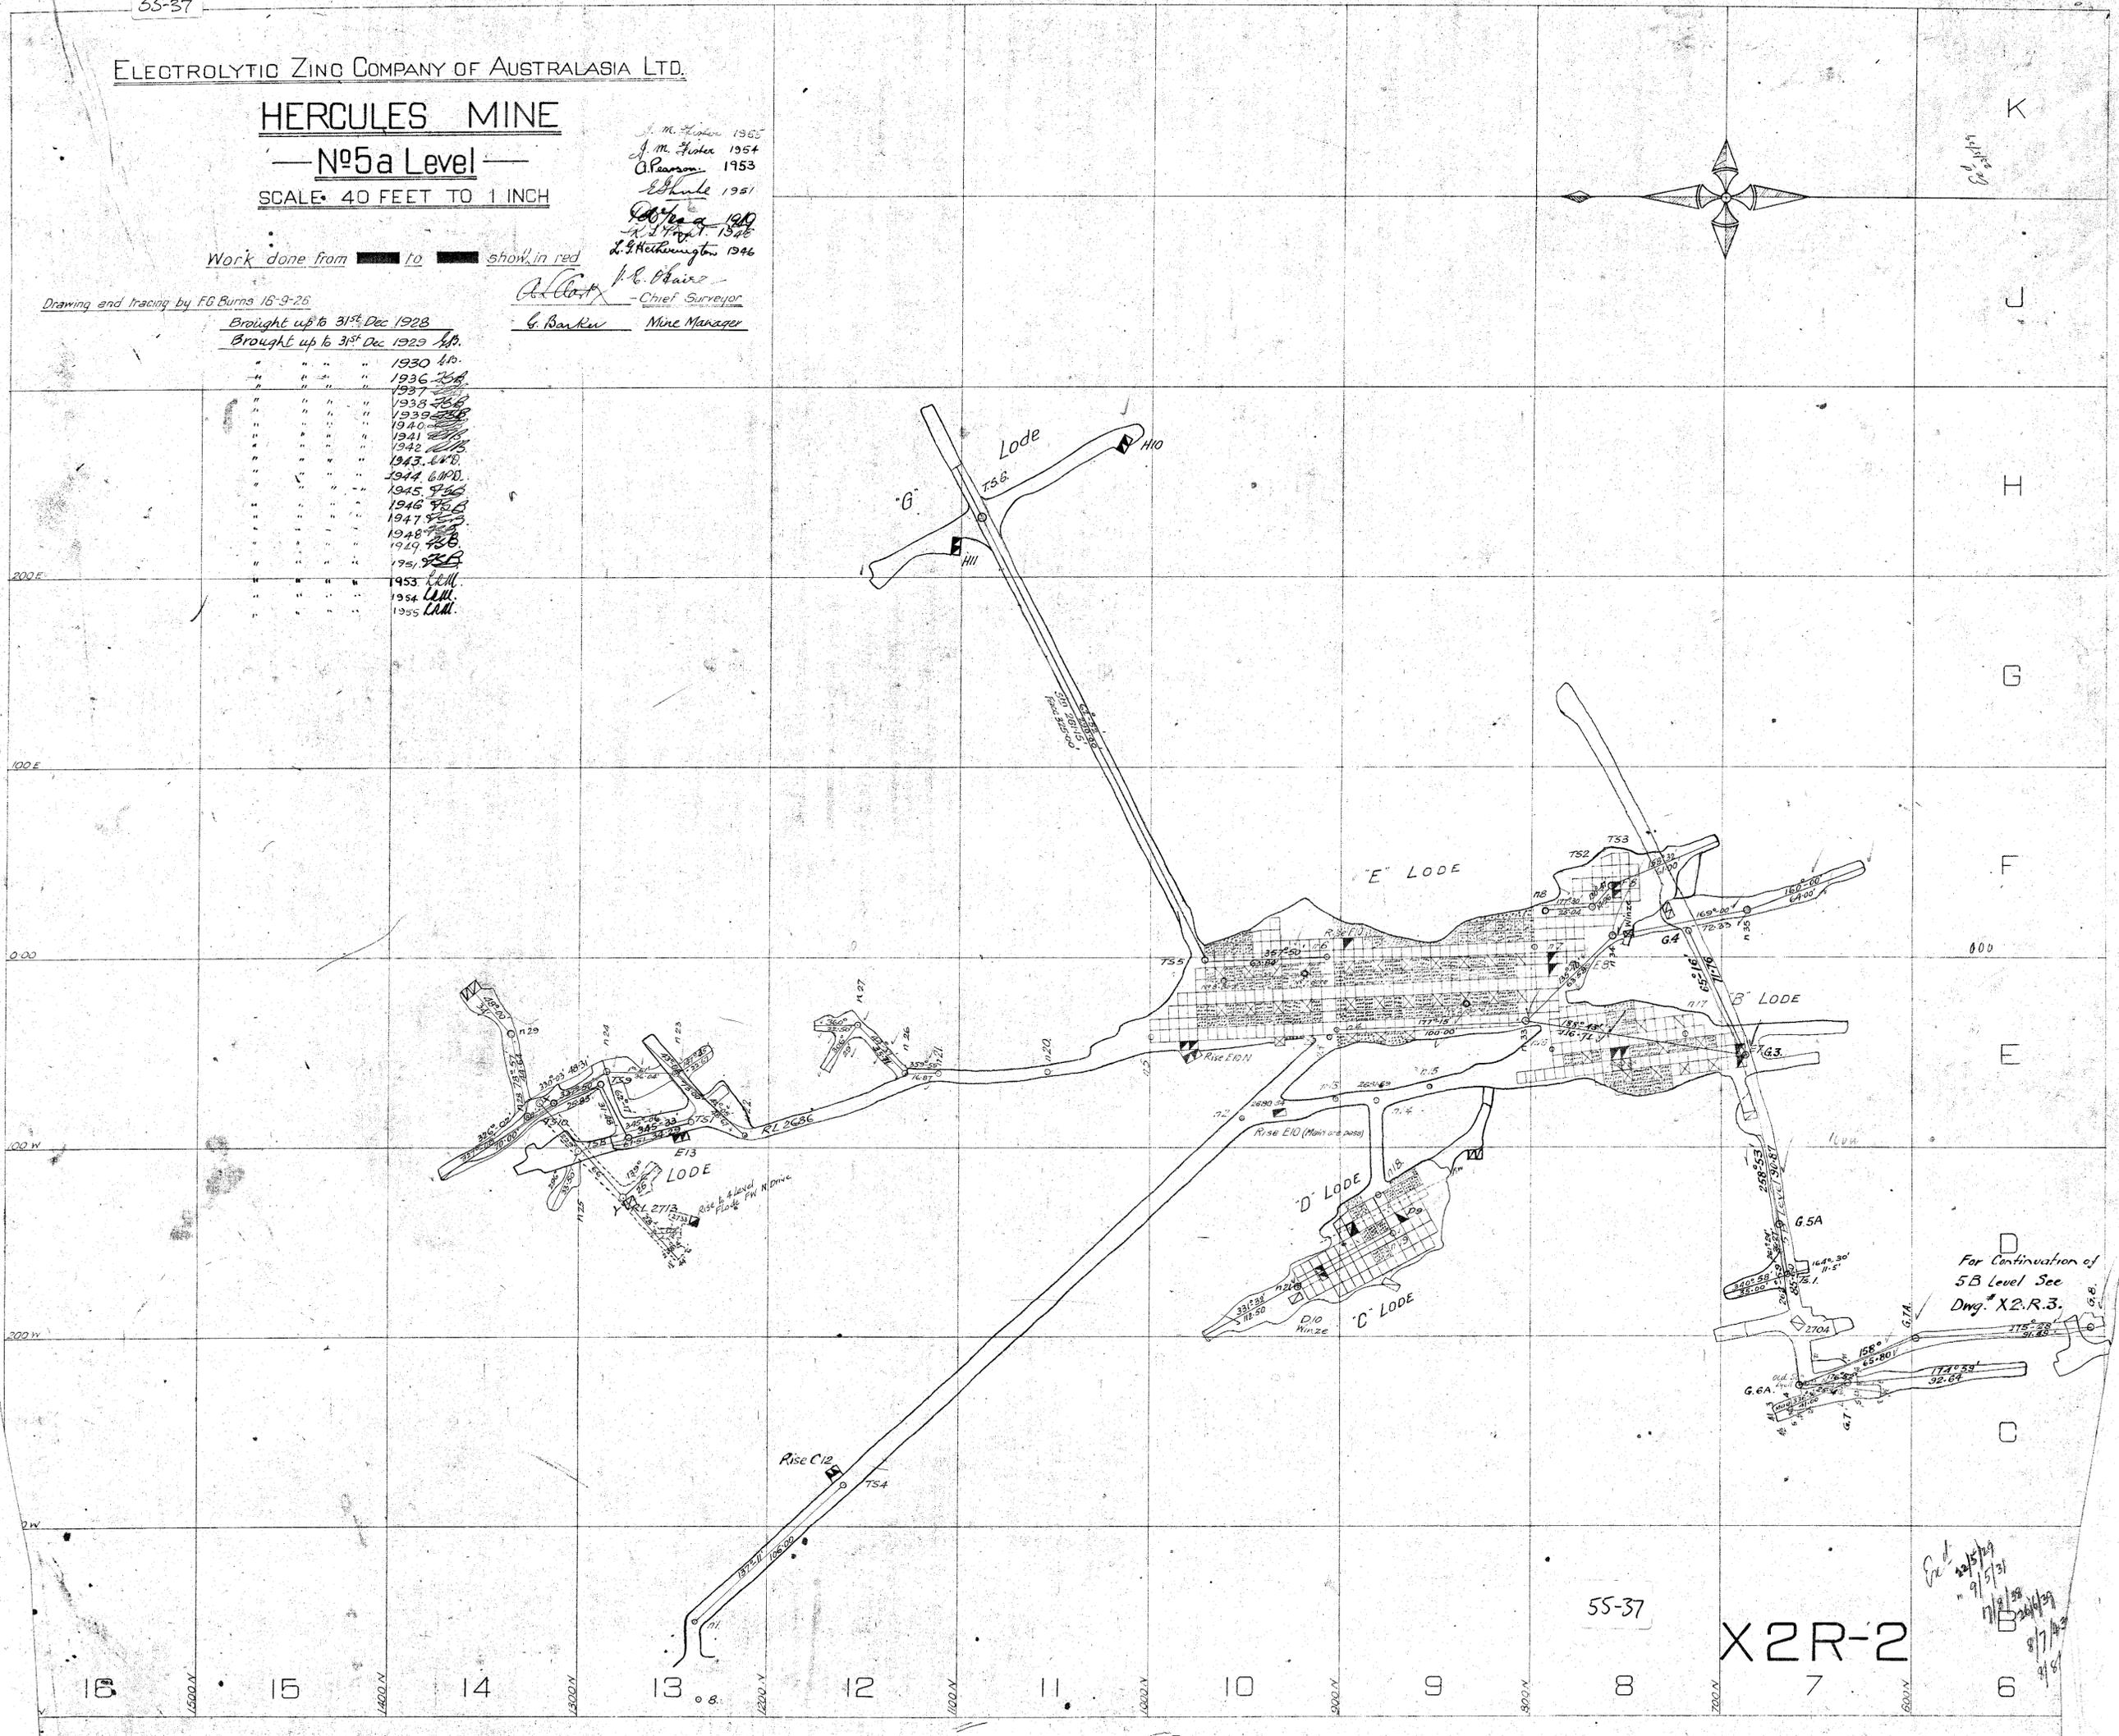

For Continuation of
5B Level See
Dwg. X2.R.3.

55-37

X2R-2

Handwritten notes and signatures:
9/15/51
9/17/51
9/18/51