

ELECTROLYTIC ZINC COMPANY OF AUSTRALASIA LTD

HERCULES MINE

No 5 Level also No 6 & 6a Levels.

SCALE 40 FEET TO 1 INCH

1934

Brought up to 31st Dec 1929.


Work done from 1930 to 1934 shown in red.

Brought up to 31st Dec 1934.

Brought up to 31st Dec 1935.

New Plan showing drive to Mt Read Mine + junction with plan No X2R-12

Brought up to:- Mine Manager Chief Surveyor
31st December 1953
31st December 1952

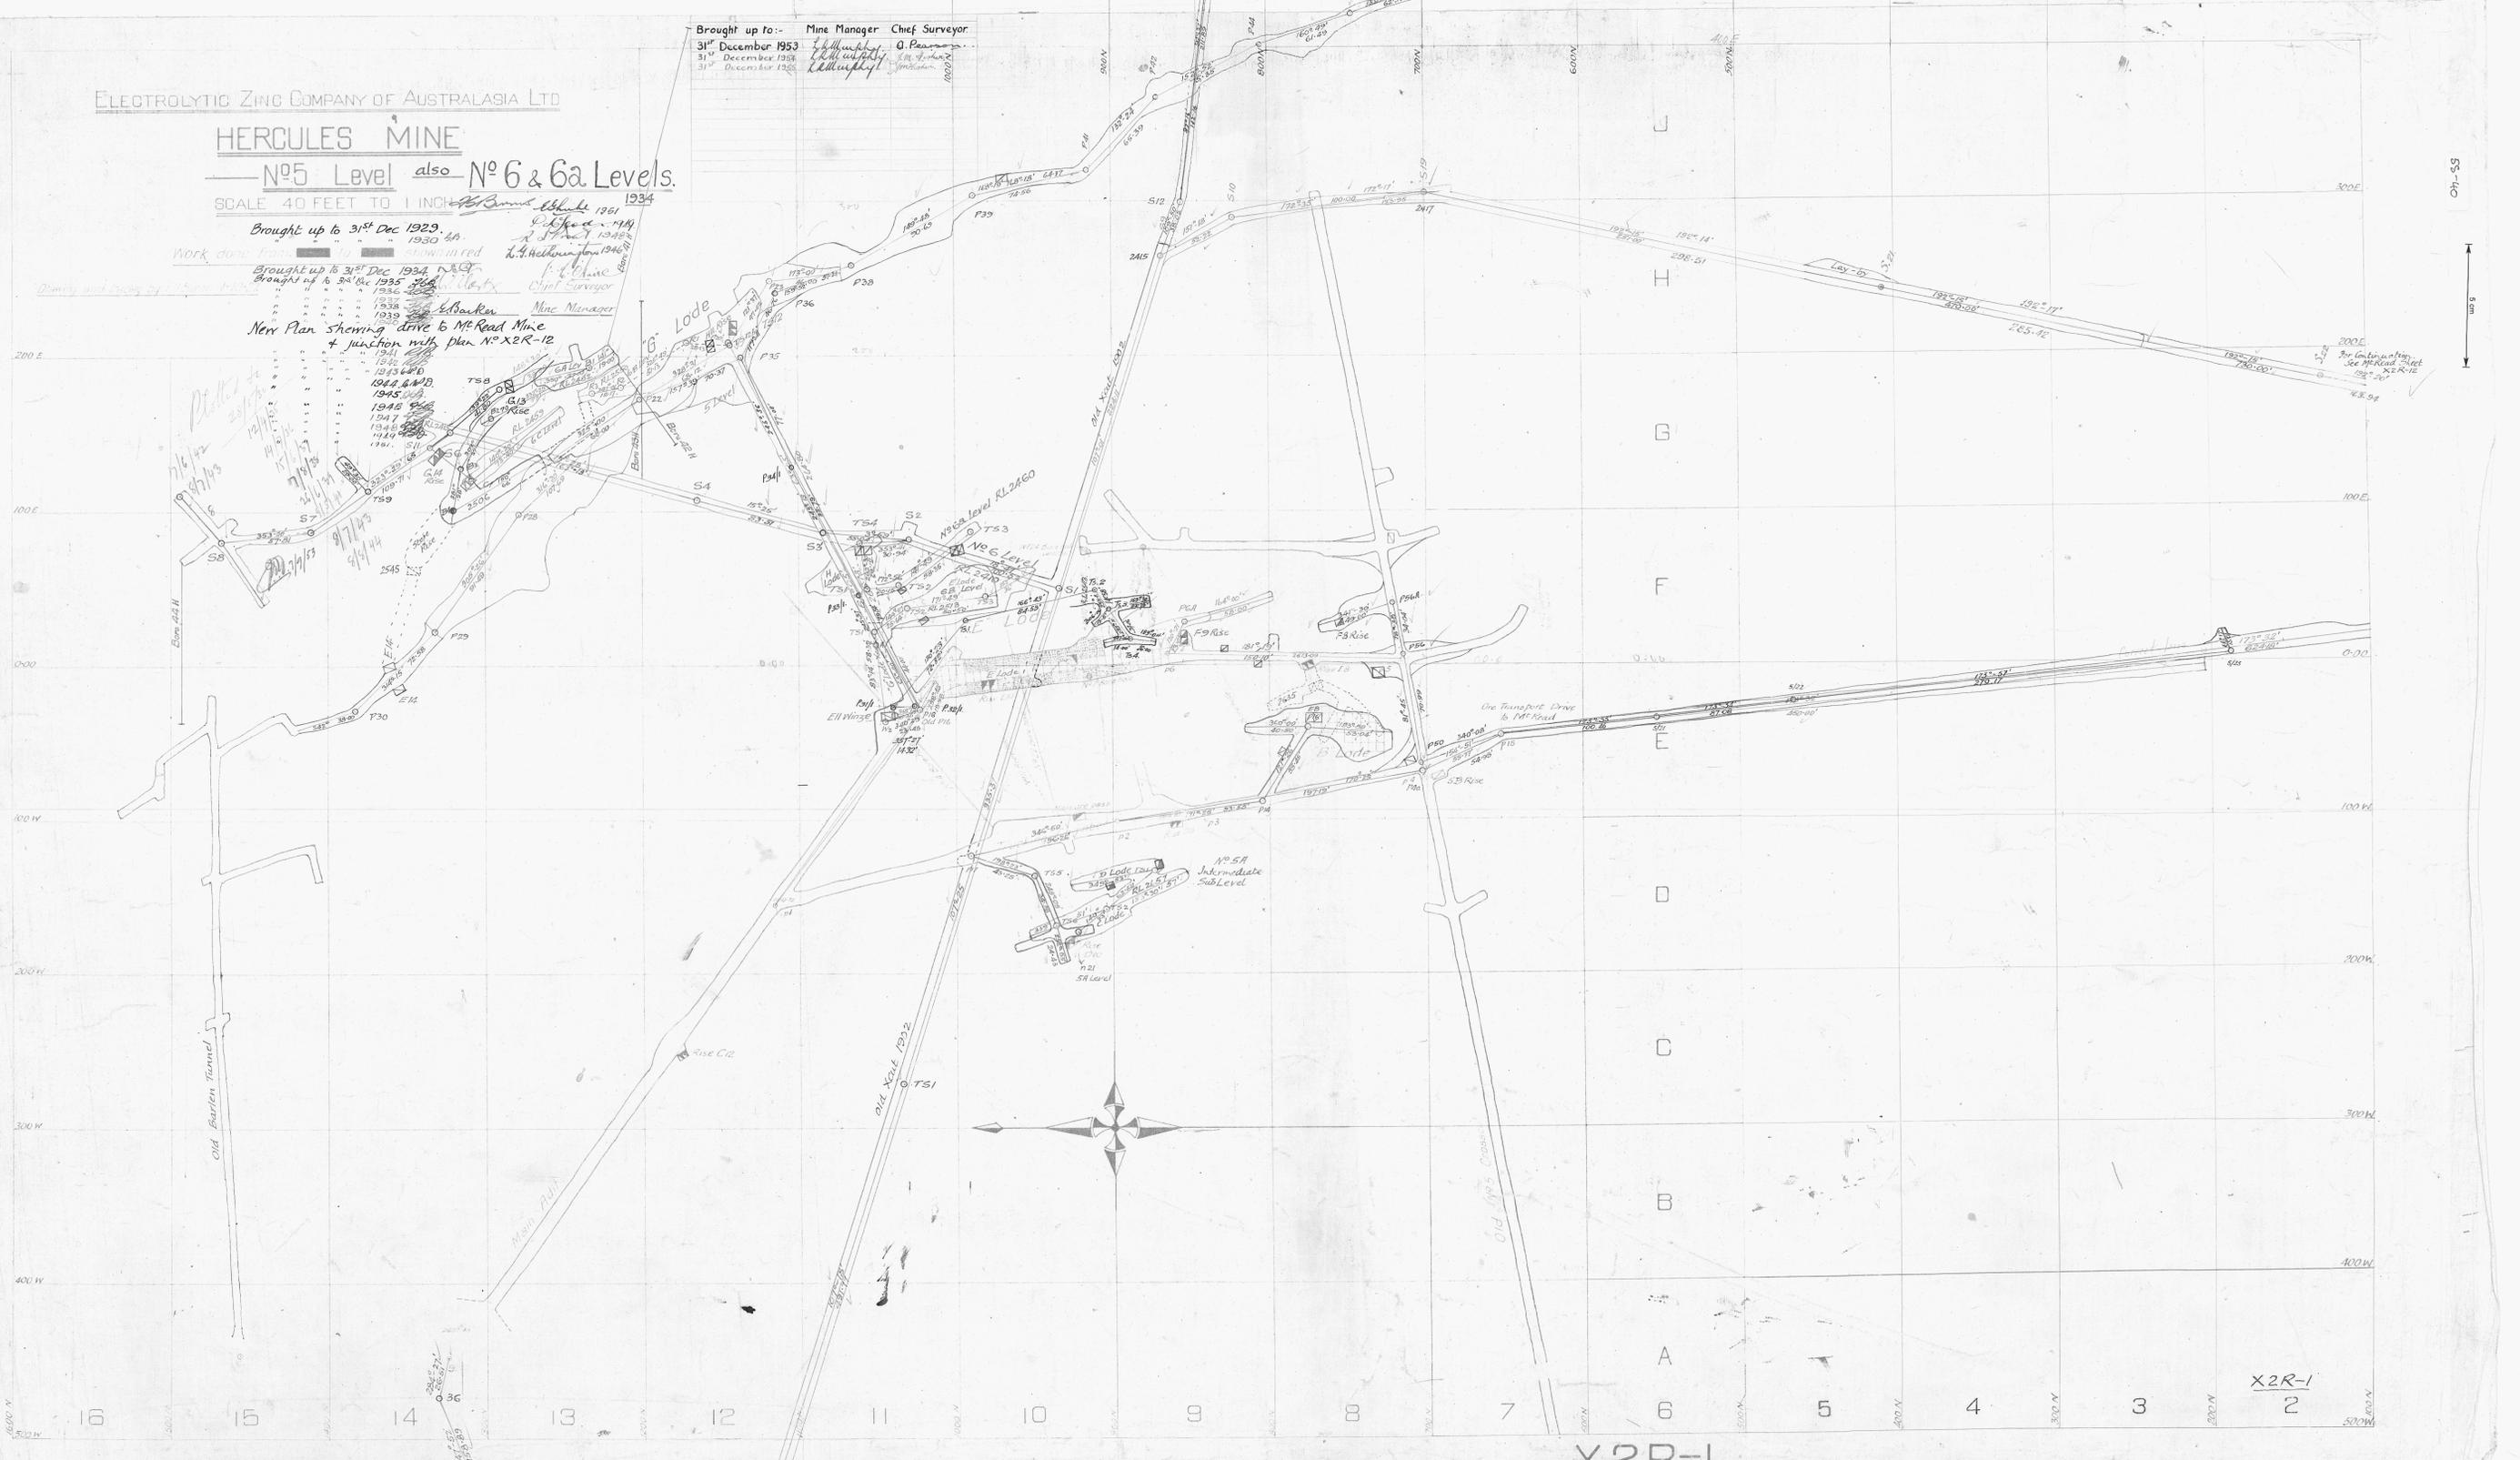

011-55
5m

X2R-1
2

X2R-1