


4/16 E Stope

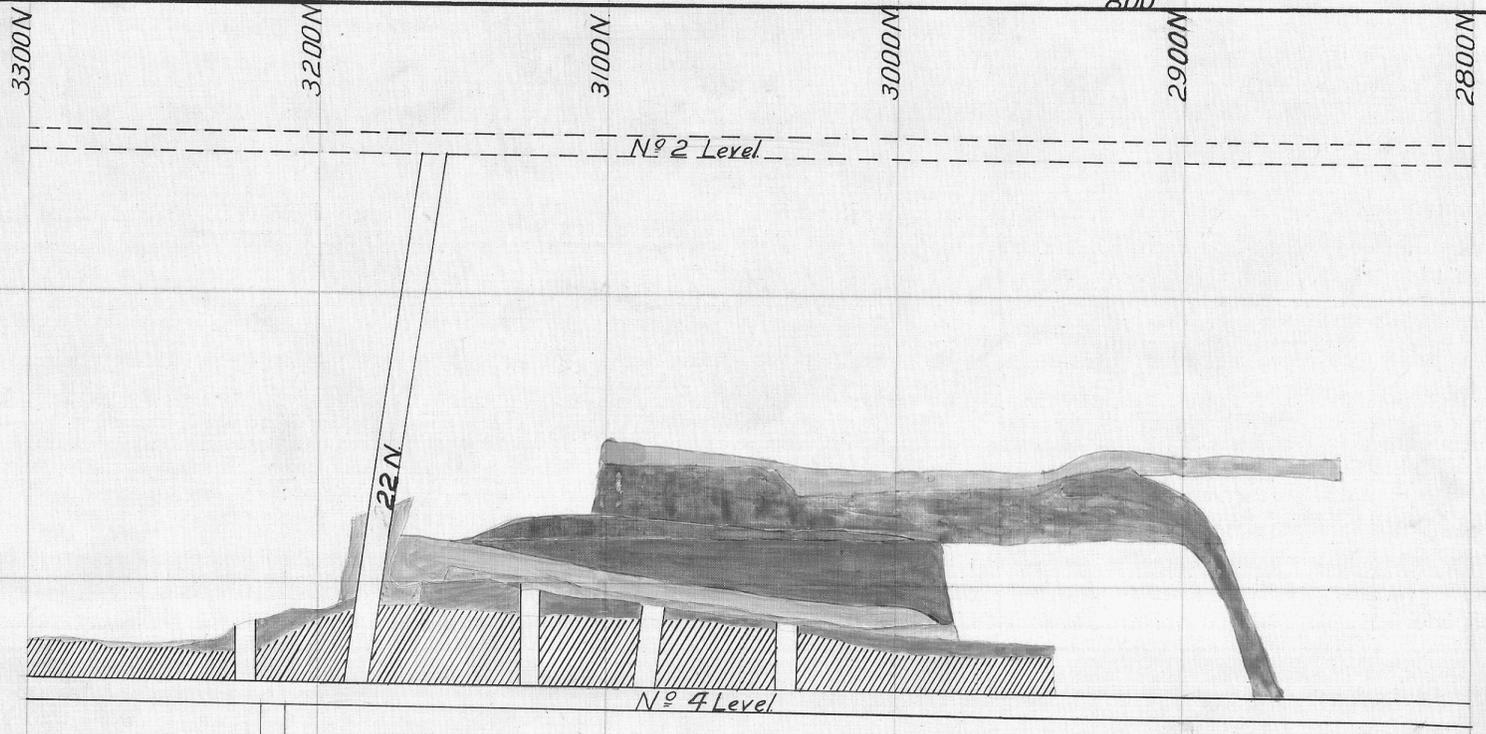

N° 6 Level

4/22 N+S Stopes

5 cm

55-41

Brought up to -	Colour	Mine Manager	Mine Surveyor
31 st Dec 1954	■	L. Murphy	J. M. Fisher
31 st " 1955	■	L. Murphy	J. M. Fisher

Brought up to Date	Colour	Mine Manager	Surveyor
31 Dec 1946	■	H. Burns	L. P. Worthington
" " 1947	■	H. Burns	L. P. Worthington
" " 1948	■	H. Burns	R. Trout
" " 1949	■	H. Burns	E. B. L.
" " 1951	■	H. Burns	E. B. L.
" " 1953	■	L. Murphy	A. Pearson

ELECTROLYTIC ZINC COMPANY
OF AUSTRALASIA LTD.
HERCULES MINE ROSEBERY

Scale: 1" = 40' Date:

Survey by PLAN No.
Geology by SHEET No.