

ELECTROLYTIC ZINC COY. OF AUSTRALASIA LTD.

HERCULES MINE


NO 4 LEVEL

SCALE 1IN.=40FT.

Work done from [] to [] shown in red
Drawing and Tacing by E.D. Dune 7-9-22

Brought up to 31st Dec 1923 48.
Brought up to 31st Dec 1928.
Brought up to 31st Dec 1930 48.
Brought up to 31st Dec 1936 48.
Brought up to 31st Dec 1937 48.
" " " " 1938 48.
" " " " 1939 48.
" " " " 1940 48.
" " " " 1941 48.
" " " " 1942 48.
" " " " 1943 48.
" " " " 1944 48.
" " " " 1945 48.
" " " " 1946 48.
" " " " 1947 48.
" " " " 1948 48.
" " " " 1949 48.
" " " " 1950 48.
" " " " 1951 48.
" " " " 1952 48.
" " " " 1953 48.

A. Pearson 1953
E. D. Dune 1951
S. Parker 1929
R. S. Hunt 1948
L. S. Hutchinson 1946
K. B. Hume
Chief Surveyor
S. Parker
Mine Manager

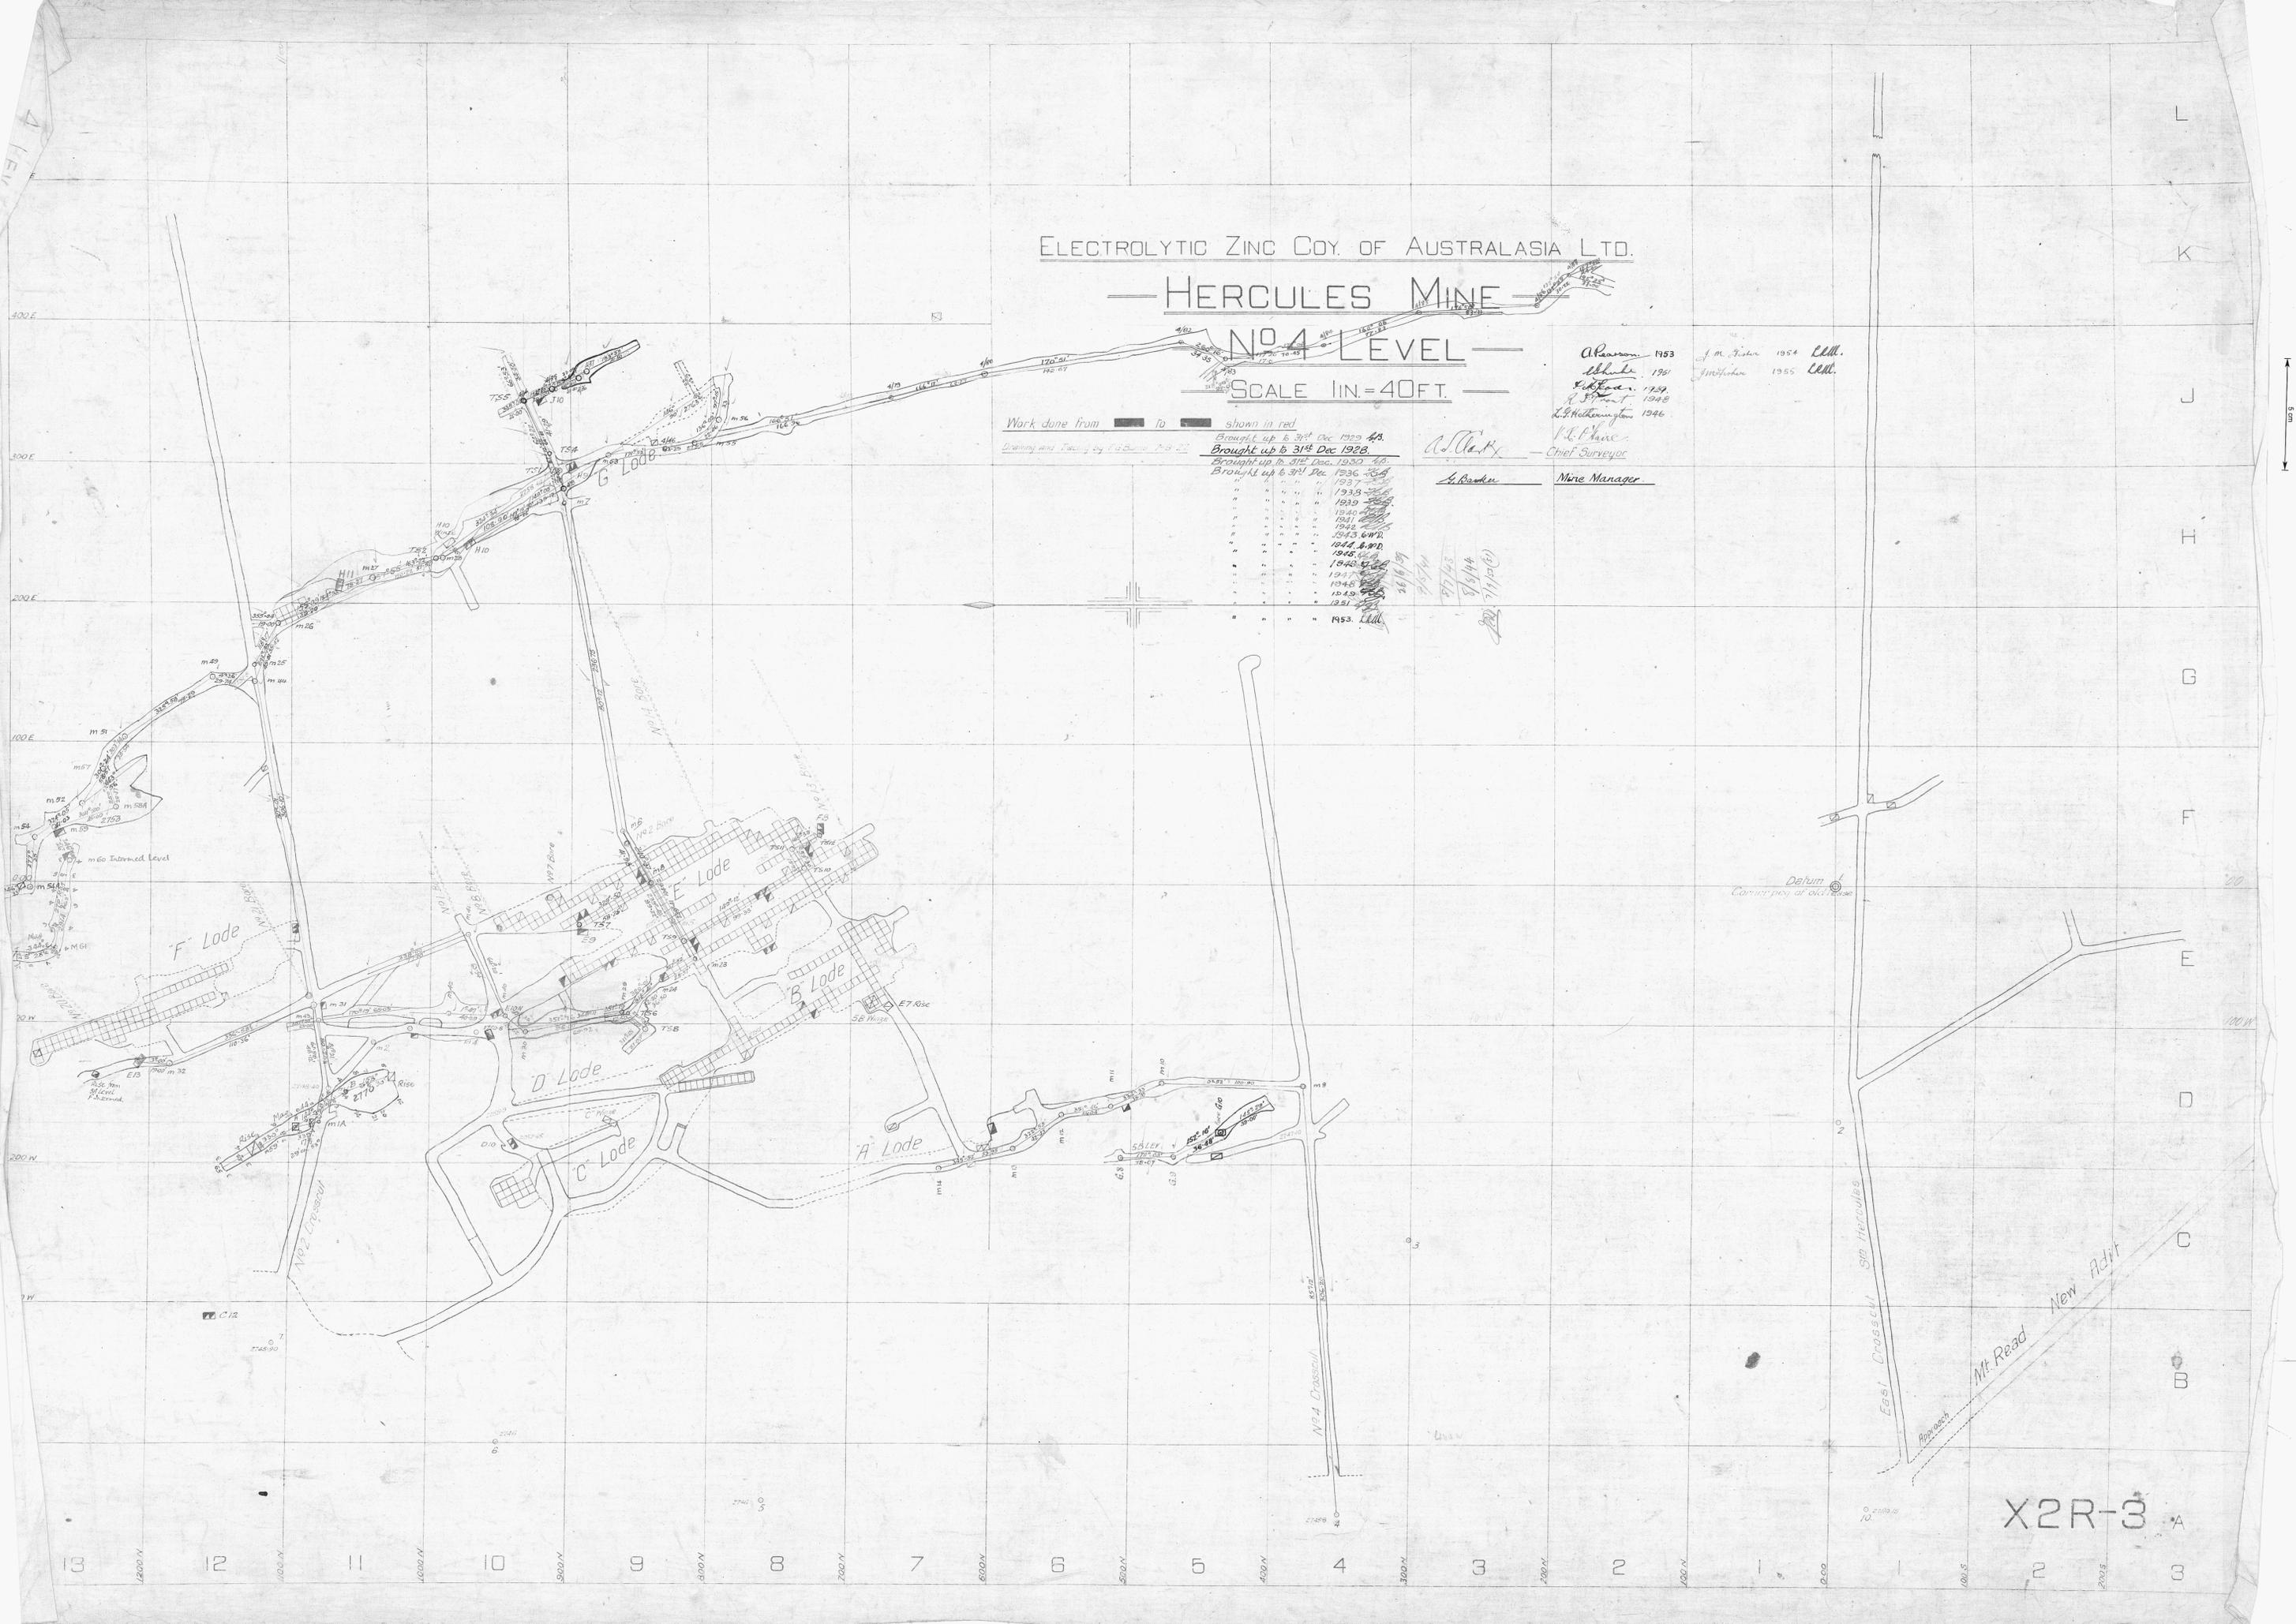

X2R-3

SC-42