


SS-48

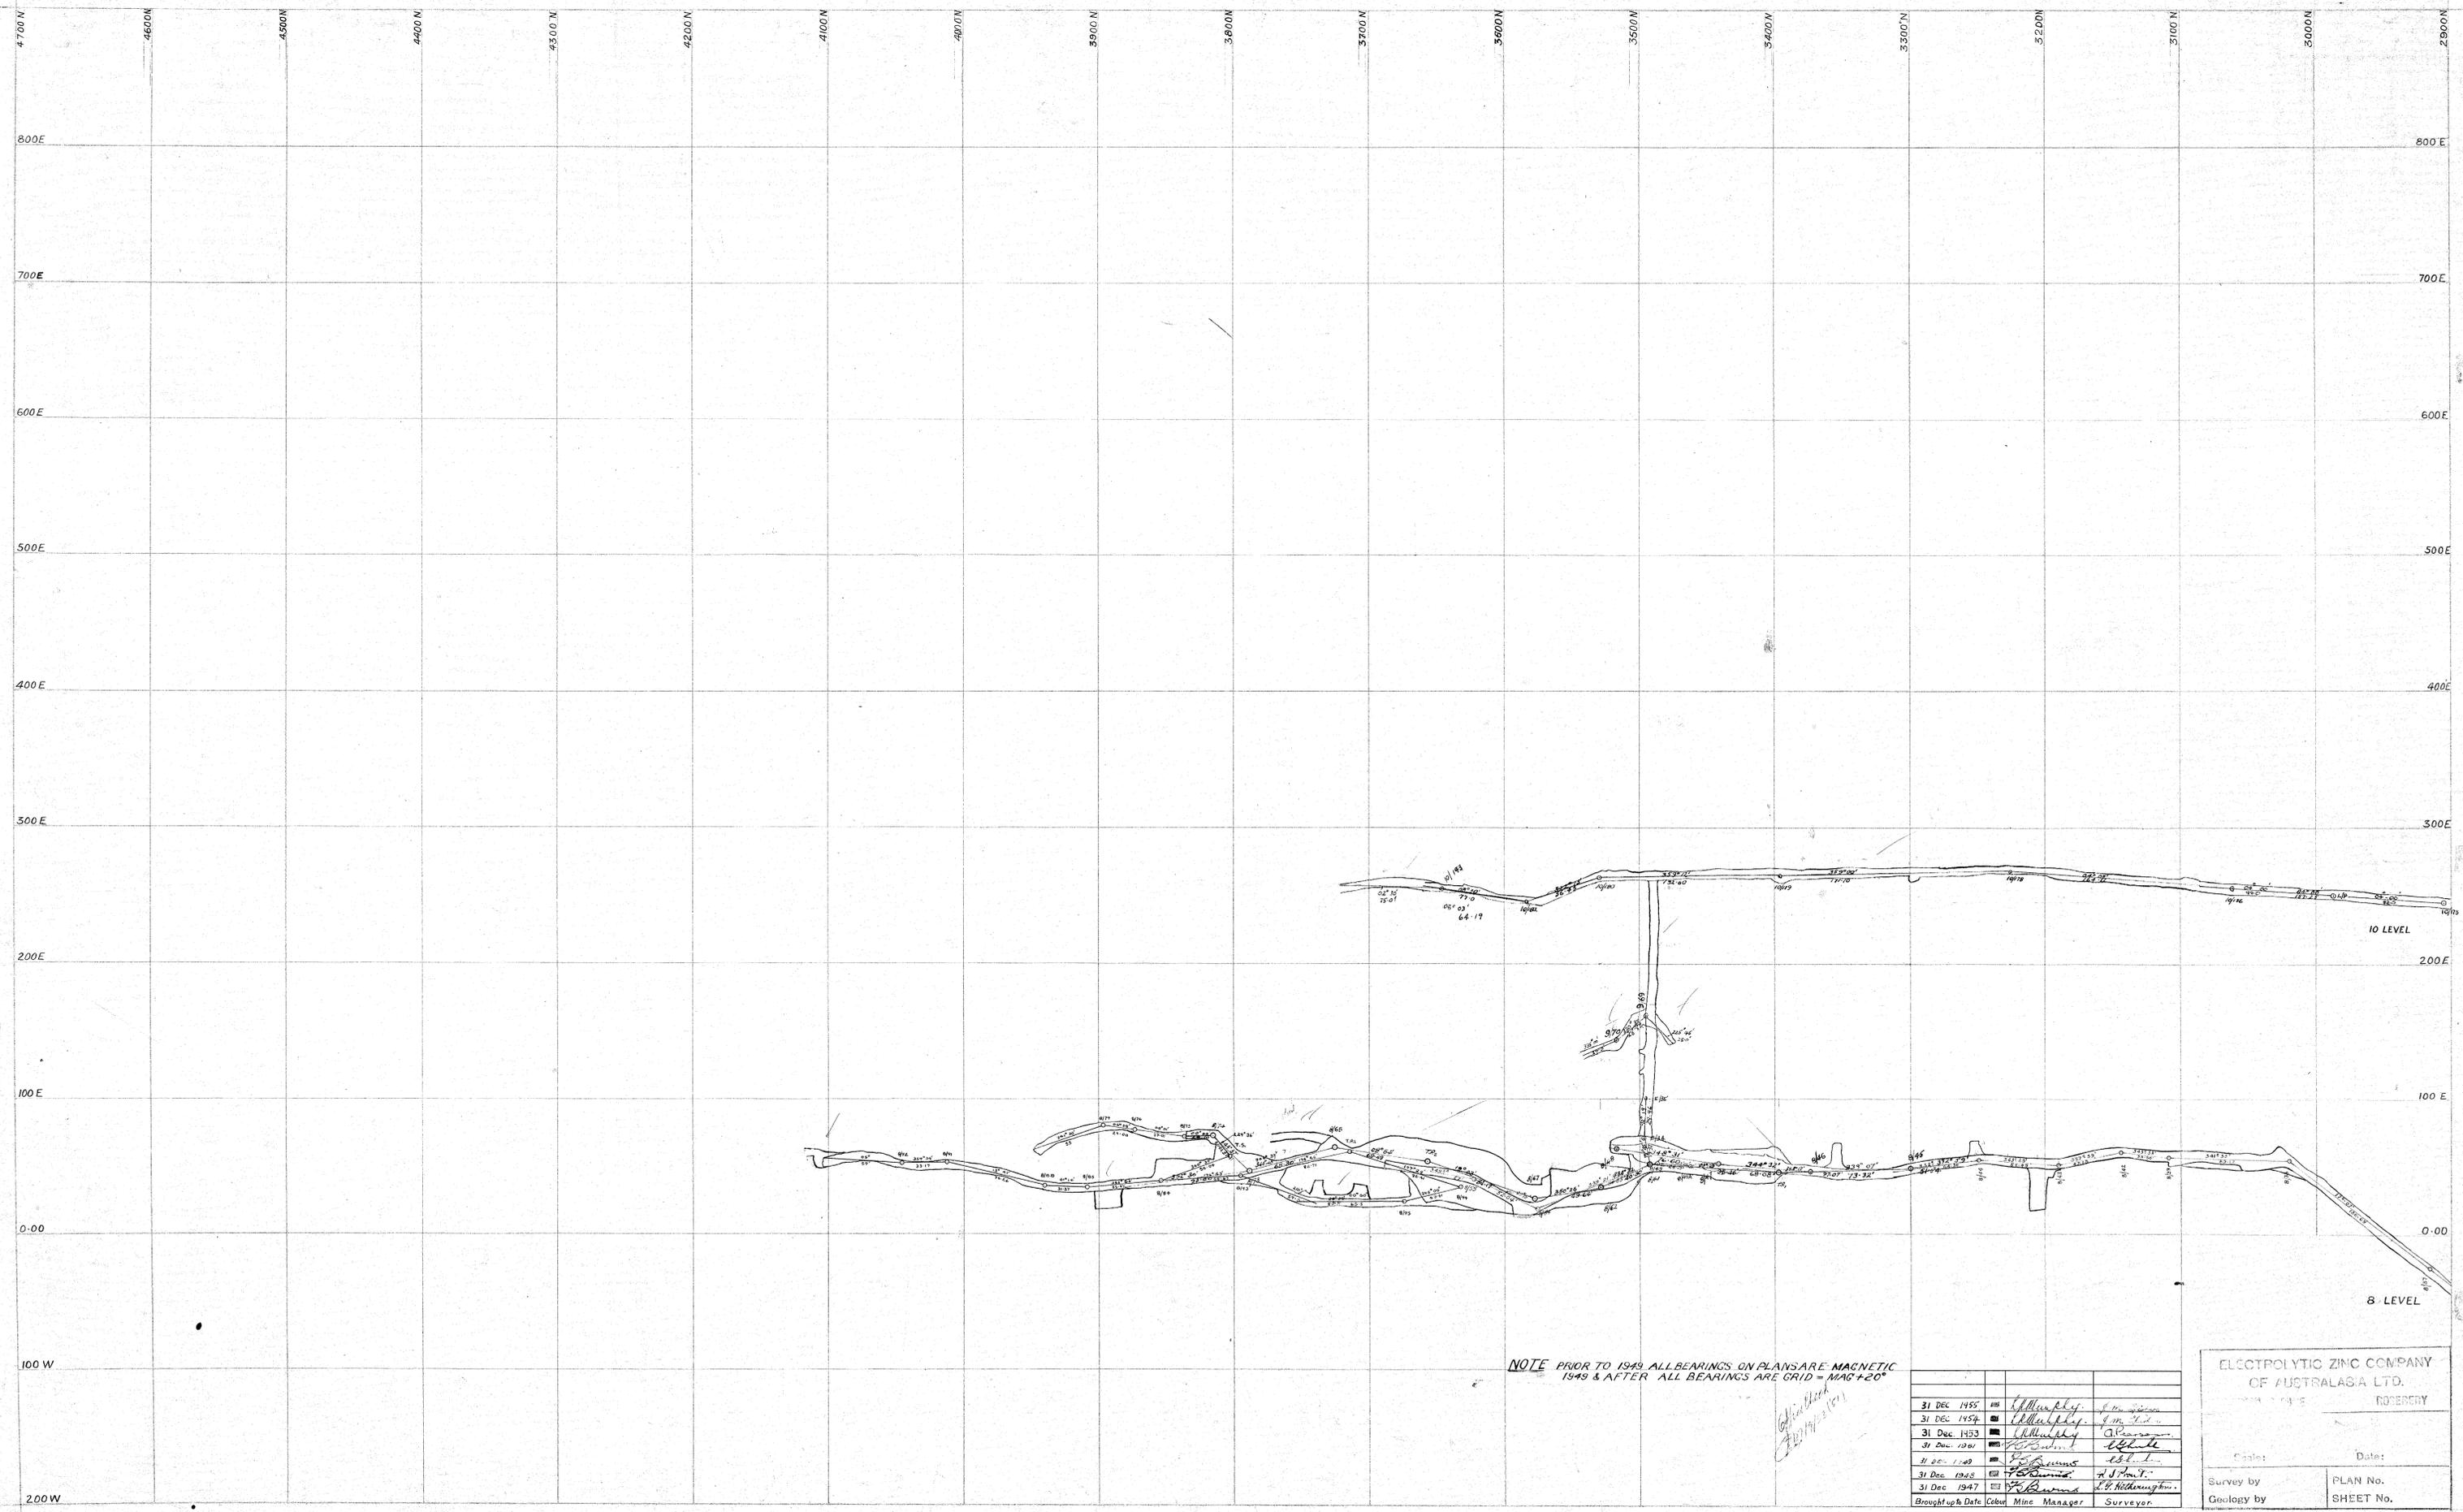

55-48

NOTE PRIOR TO 1949 ALL BEARINGS ON PLANS ARE MAGNETIC
 1949 & AFTER ALL BEARINGS ARE GRID - MAG + 20

31 Dec 1955	W. Murphy	Surveyor
31 Dec 1954	W. Murphy	Surveyor
31 Dec 1953	W. Murphy	Surveyor
31 Dec 1951	W. Murphy	Surveyor
31 Dec 1949	W. Murphy	Surveyor
31 Dec 1948	W. Murphy	Surveyor
31 Dec 1947	W. Murphy	Surveyor
Brought up to Date	Coburn	Mine Manager
		Surveyor

ELECTROLYTIC ZINC COMPANY
 OF AUSTRALASIA LTD.
 ROSEBERY

Scale: _____ Date: _____

Survey by _____ PLAN No. _____
 Geology by _____ SHEET No. _____