

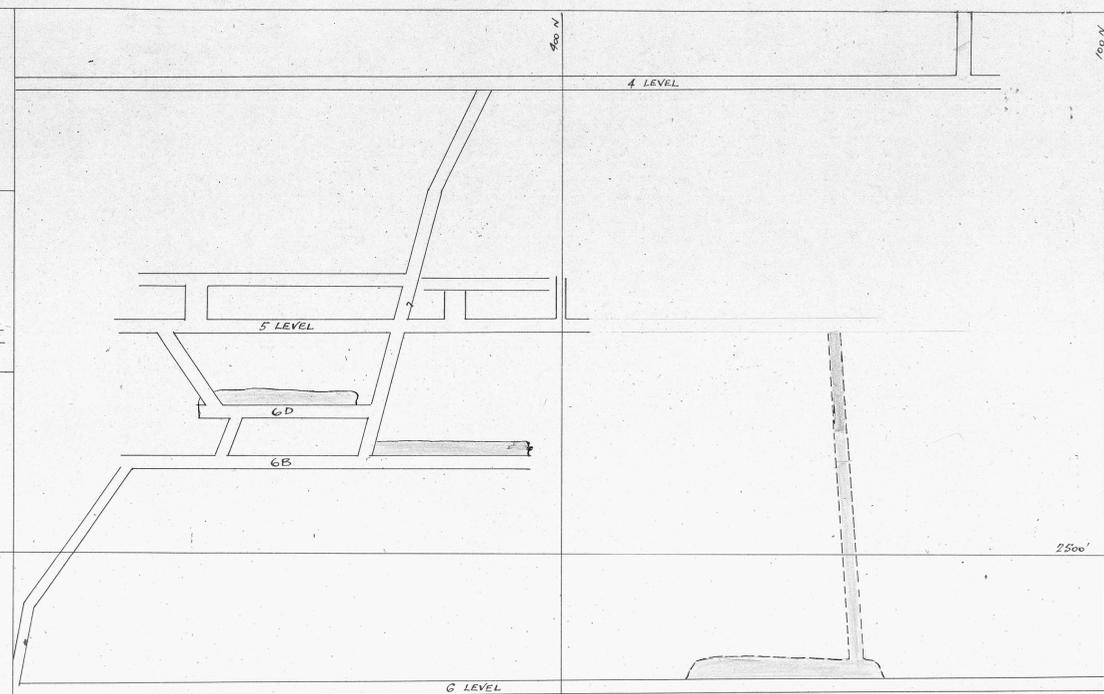


SS-53

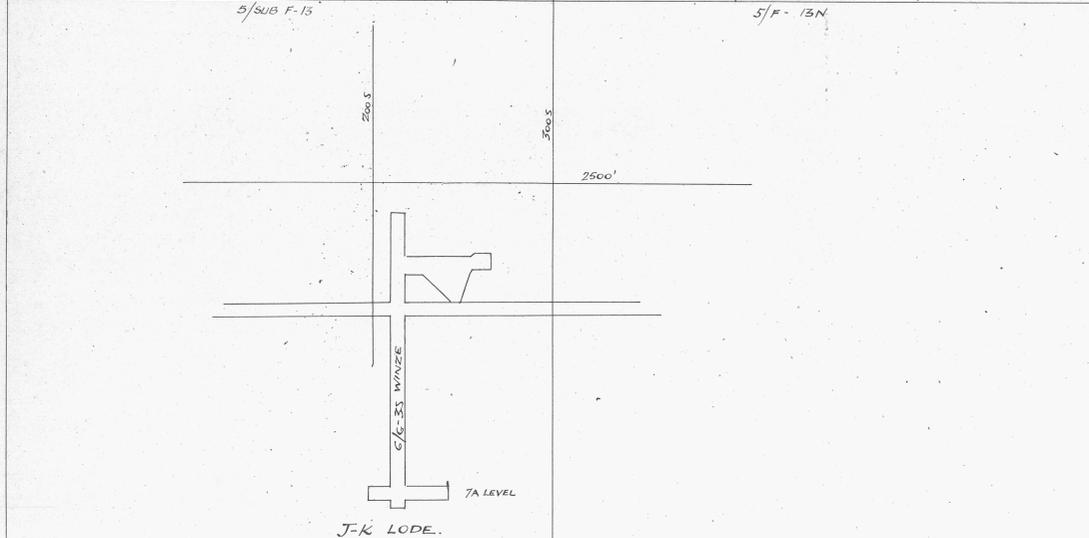

C LODES from (6-4 LEVELS).

SS-53

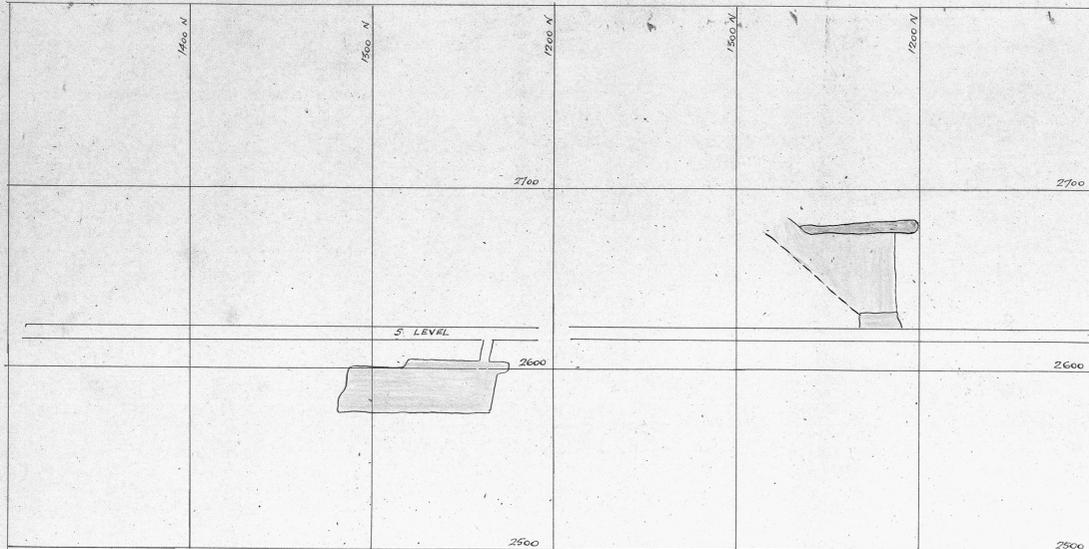

Brought to Date: 31.12.56.

MINE SURVEYOR: *[Signature]*
 MINE MANAGER: *[Signature]*

NOTE: NEW WORK IN RED.

LONG. PROJ.
 (SPECIAL SHEET)
 1" = 40 FT. MINES DEPT.
 PLAN.
 12.3.57