


55-55



55-55

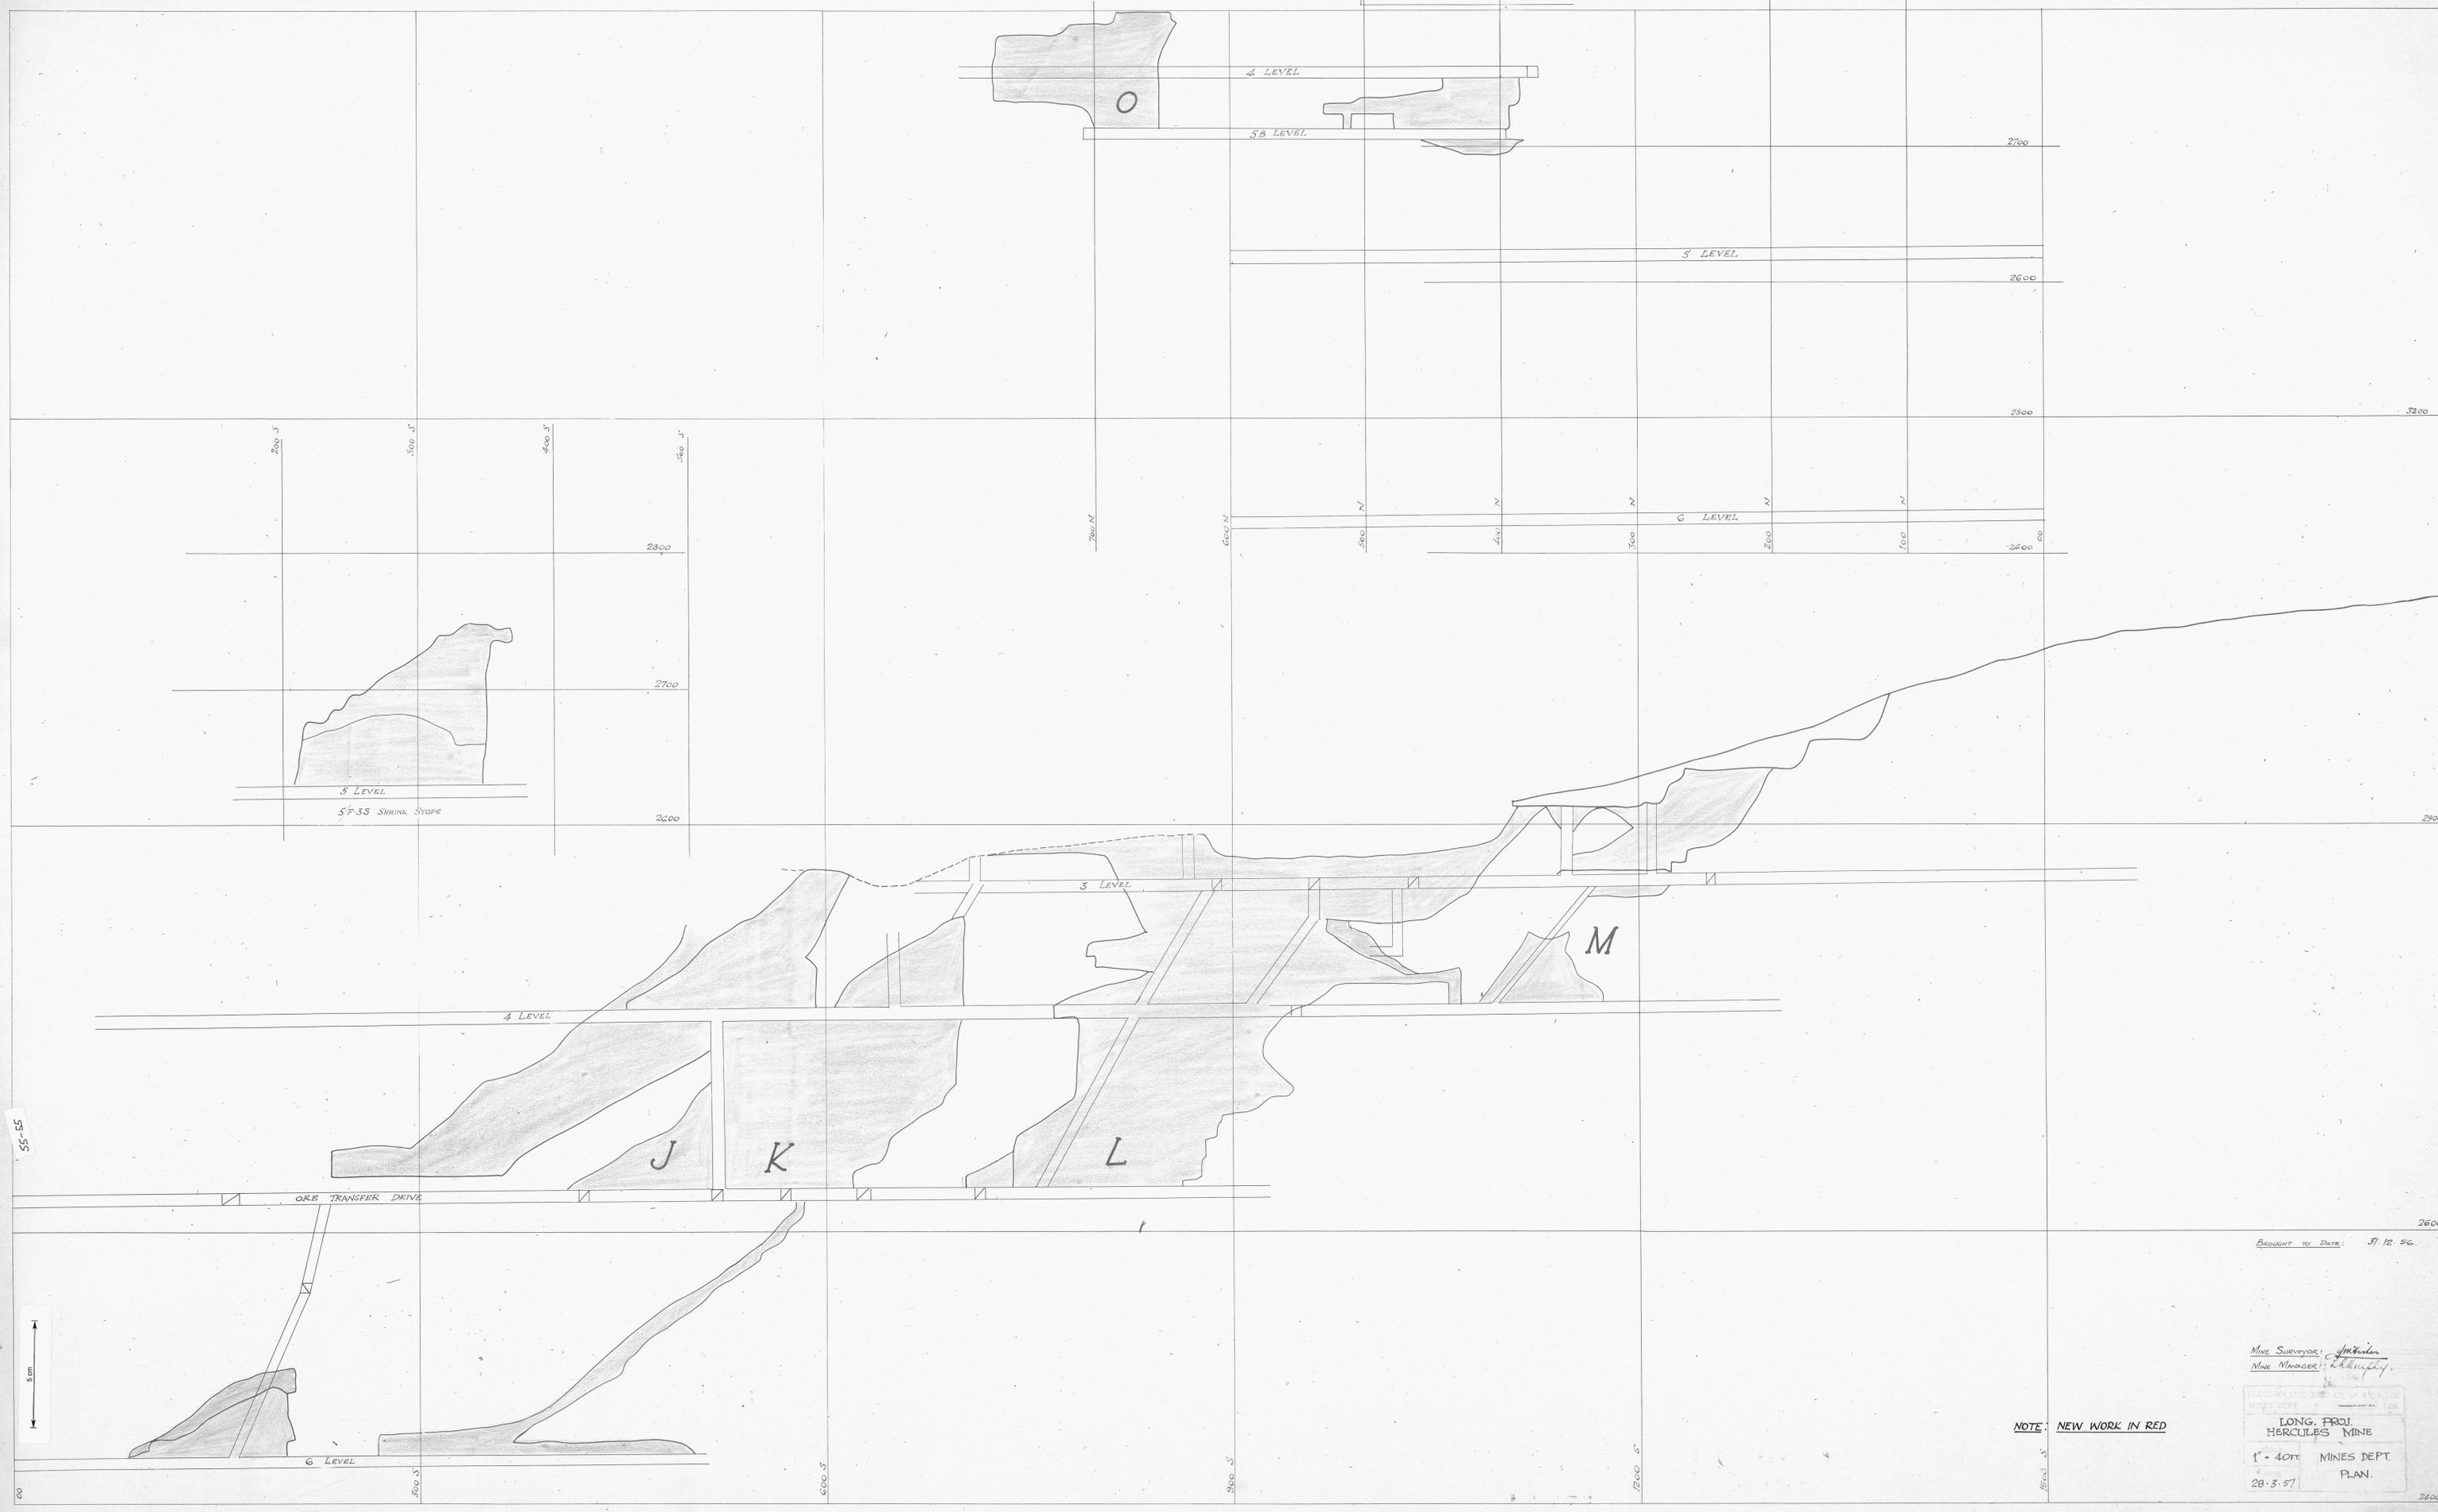

EXCUTTED TO DATE: 3/12/56

MINE SURVEYOR: *[Signature]*
 MINE MANAGER: *[Signature]*
 ELECTRICIAN: *[Signature]*
 LONG PROJ. HERCULES MINE
 1" = 40' MINE DEPT.
 28-3-57 PLAN.

NOTE: NEW WORK IN RED

2800'