


55-56

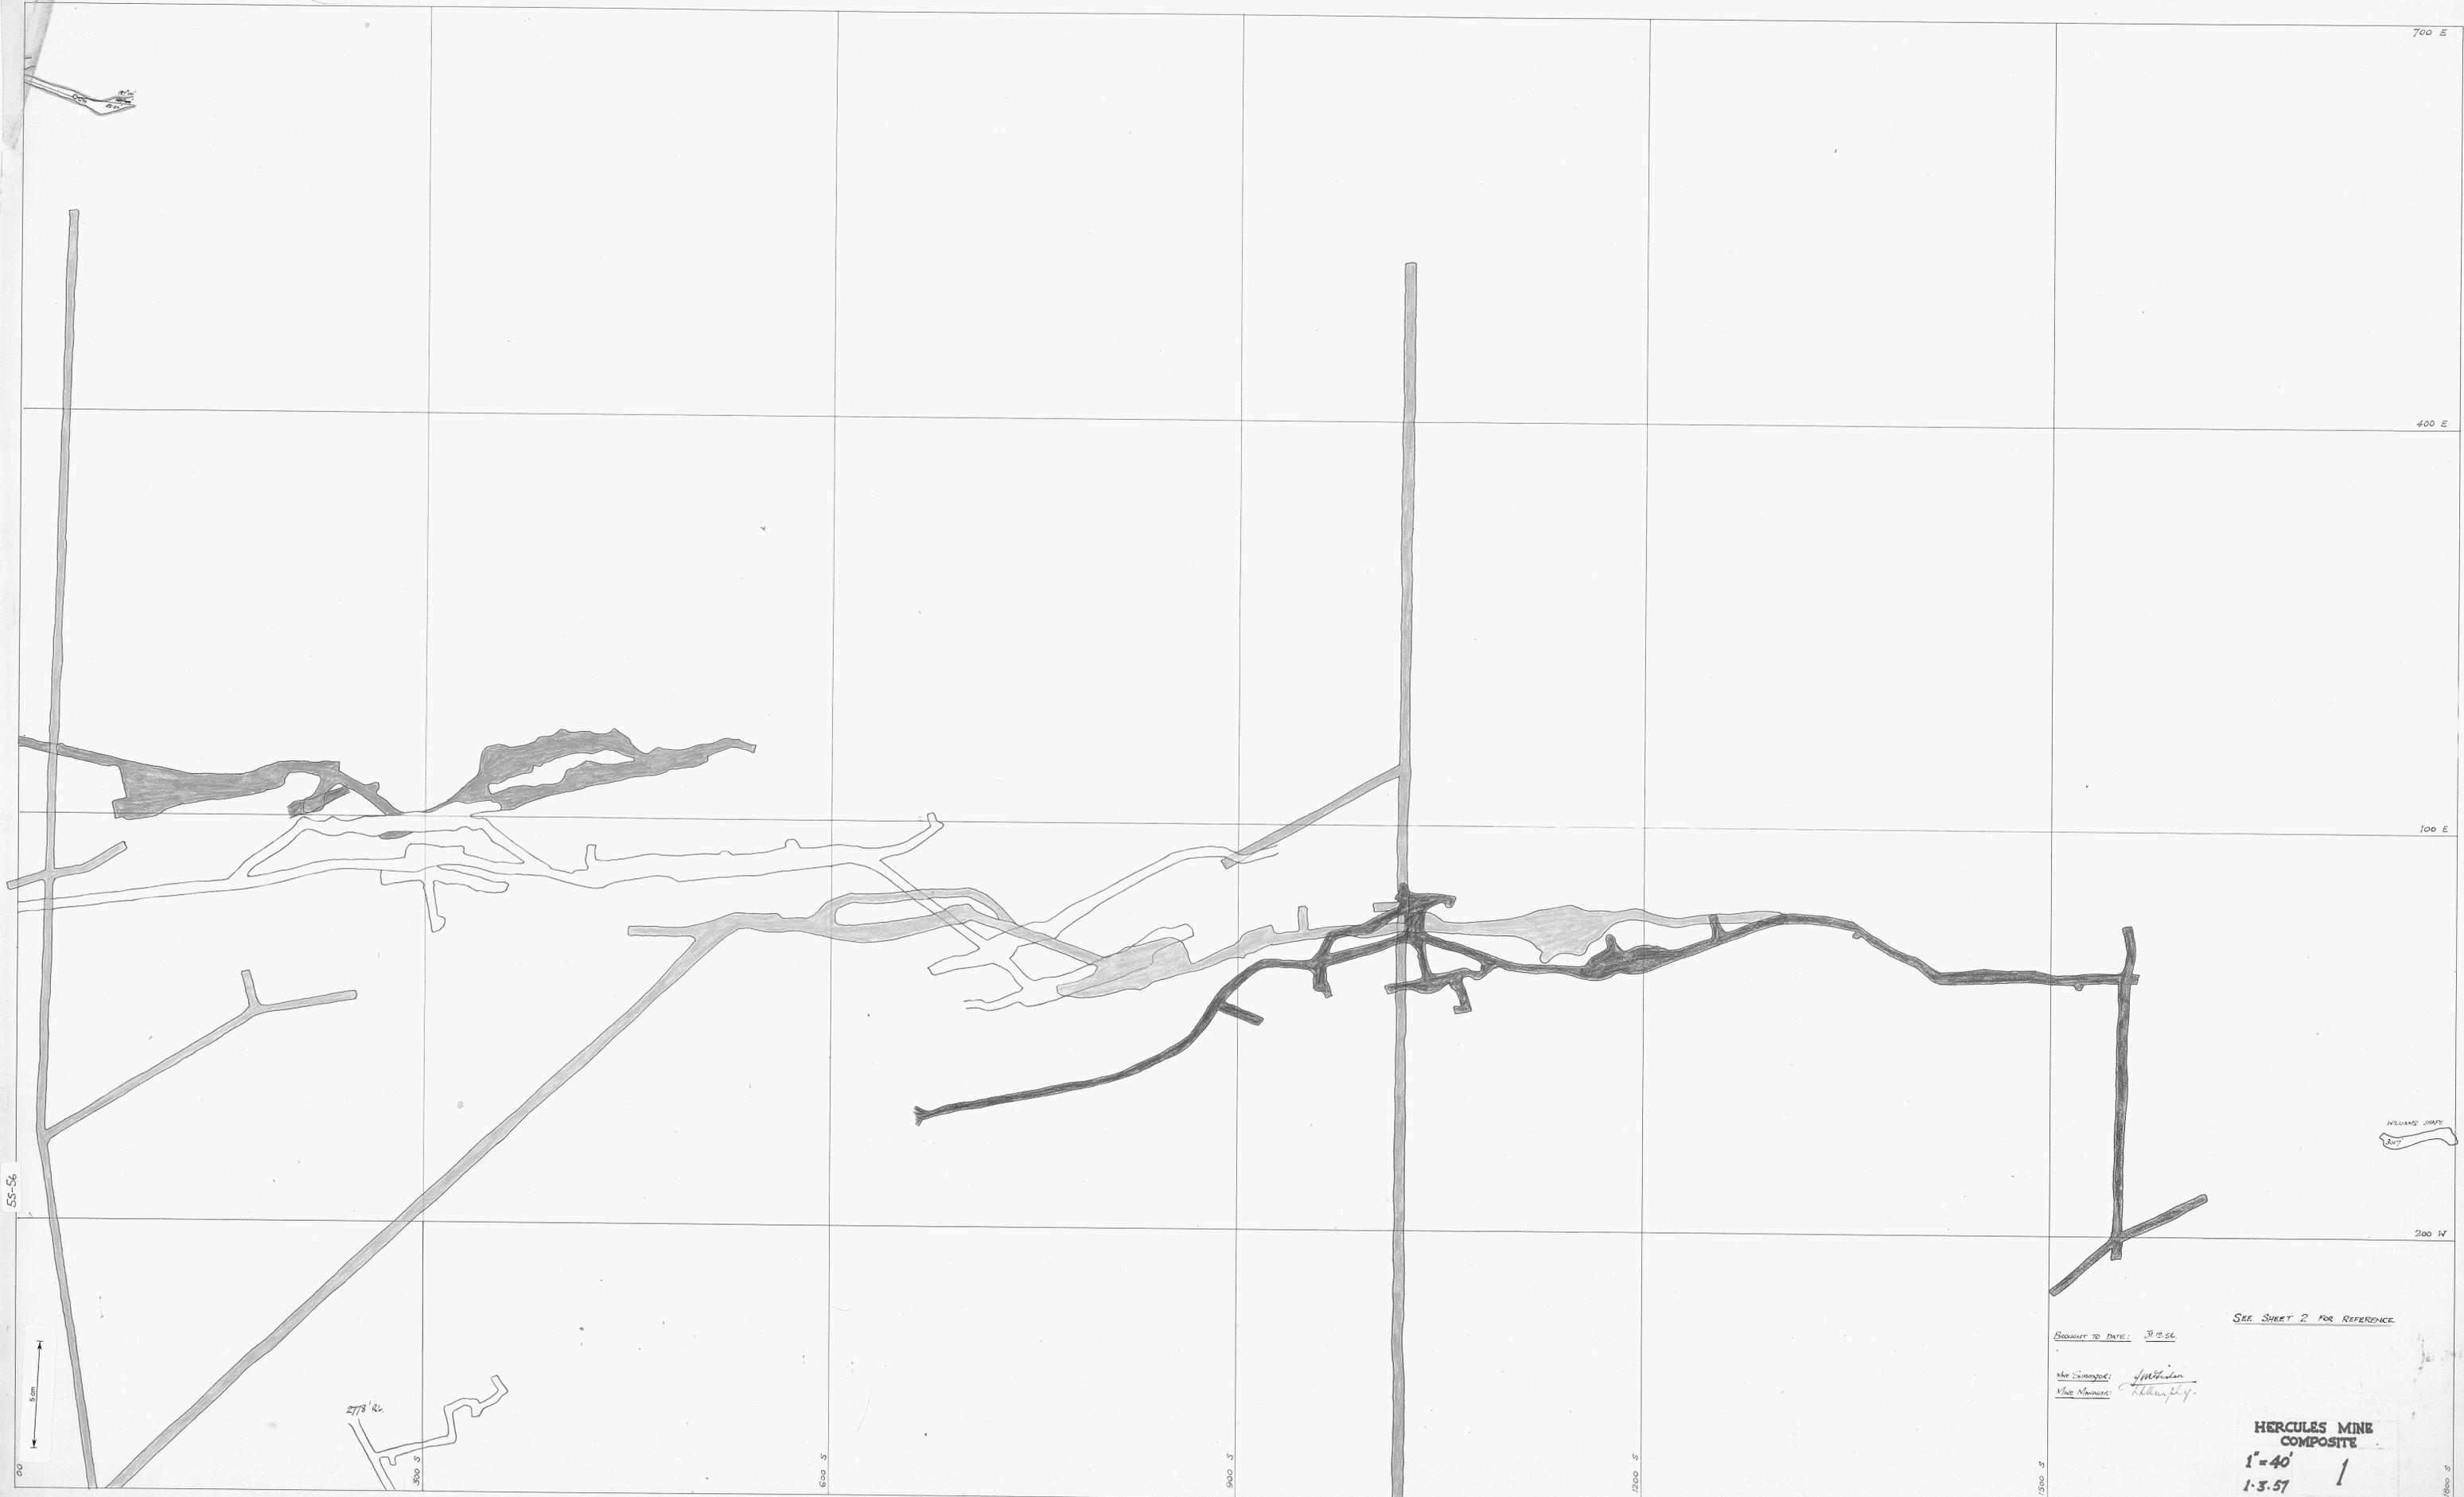

55-56

50  
50  
50

2773' 42"

500 S

600 S

900 S

1200 S

1500 S

BRINGED TO DATE: 11/12/56

SEE SHEET 2 FOR REFERENCE

Min. Surveyor: J. P. ...  
Min. Engineer: ...

HERCULES MINE  
COMPOSITE  
1" = 40'  
1-3-57

WILLIAMS SHAFT