


55-57

55-57

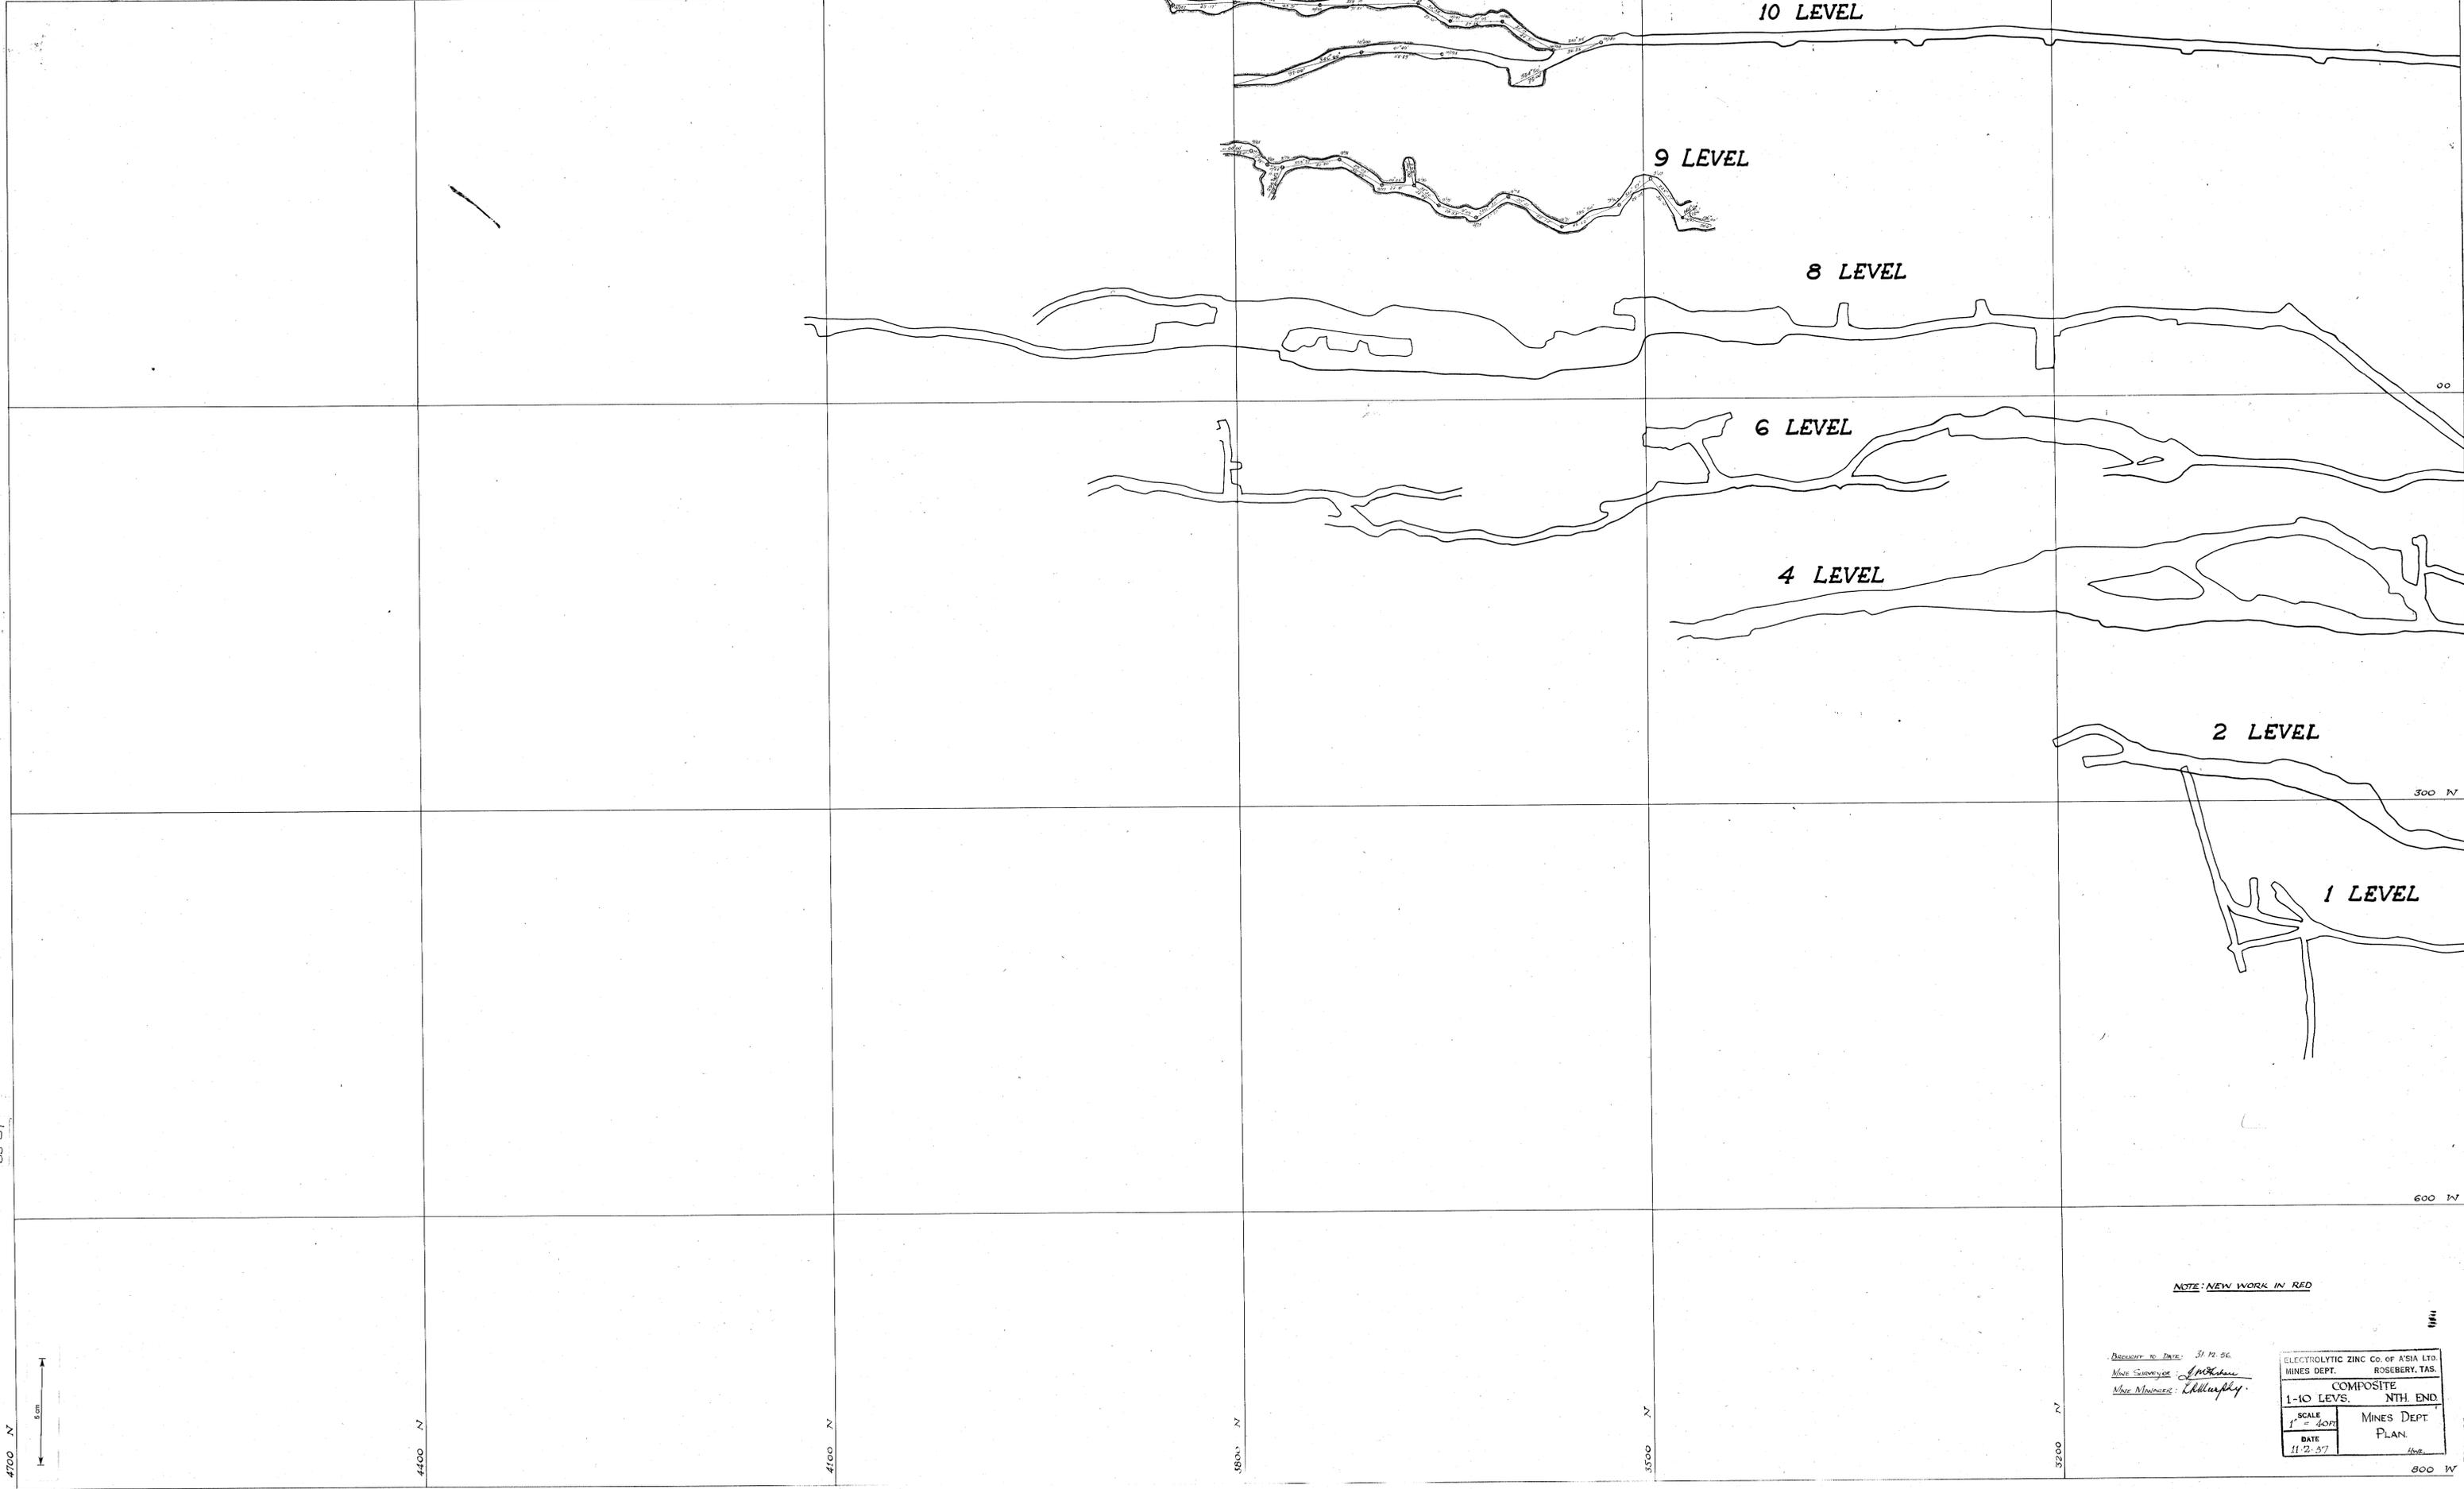

10 LEVEL

9 LEVEL

8 LEVEL

6 LEVEL

4 LEVEL

2 LEVEL

1 LEVEL



NOTE: NEW WORK IN RED

PREPARED BY DATE: 31.12.56
 Mine Surveyor: *[Signature]*
 Mine Manager: *[Signature]*

ELECTROLYTIC ZINC CO. OF ASIA LTD.	
MINES DEPT. ROSEBERY, TAS.	
COMPOSITE	
1-10 LEVS.	NTH. END.
SCALE 1" = 40M	MINES DEPT PLAN.
DATE 11.2.57	

4700 N

4400 N

4100 N

3800 N

3500 N

3200 N

800 W

300 E