

55-60

1400 E

1200 E

900 E

600 E

55-60

2500 N

2500 N


2000 N

2000 N

1700 N

1400 N

300 E

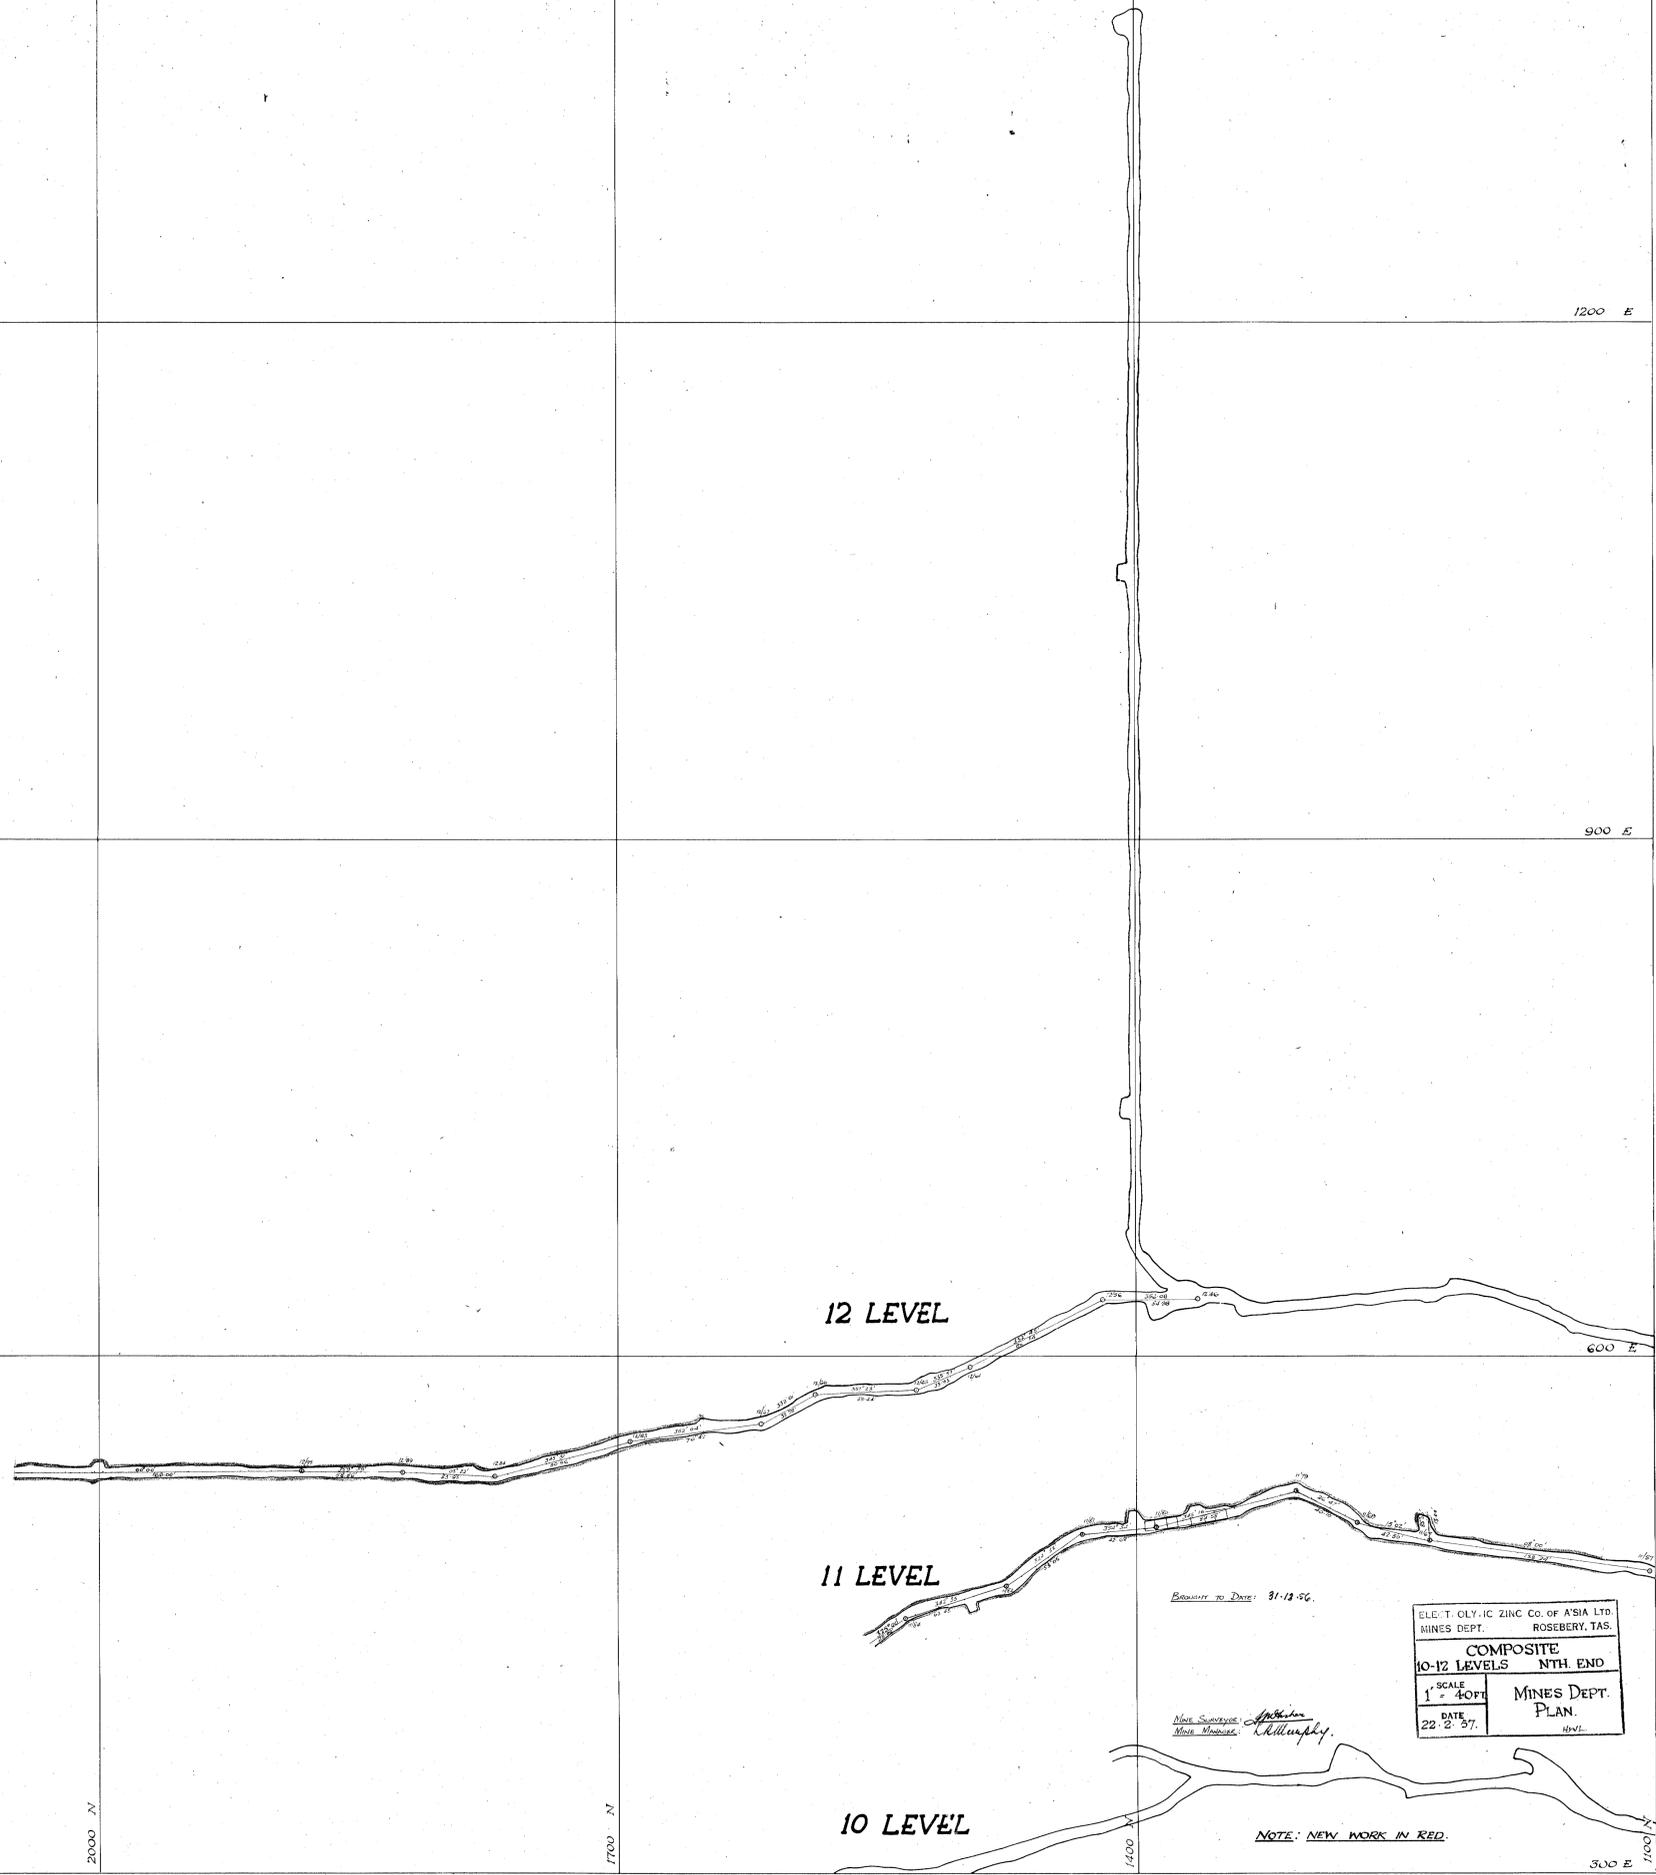

12 LEVEL

11 LEVEL

10 LEVEL

Boundary to Date: 31-12-56.

Miner Supervisor: *Spencer*
Miner: *McCarthy*

ELECTROLIC ZINC CO. OF A'SIA LTD.	
MINES DEPT. ROSEBERY, TAS.	
COMPOSITE	
10-12 LEVELS NTH. END	
SCALE	MINES DEPT.
1" = 40'	PLAN.
DATE	
22.2.57.	

NOTE: NEW WORK IN RED.