

SS-62


1400 E

1200 E

900 E

600 E

300 E

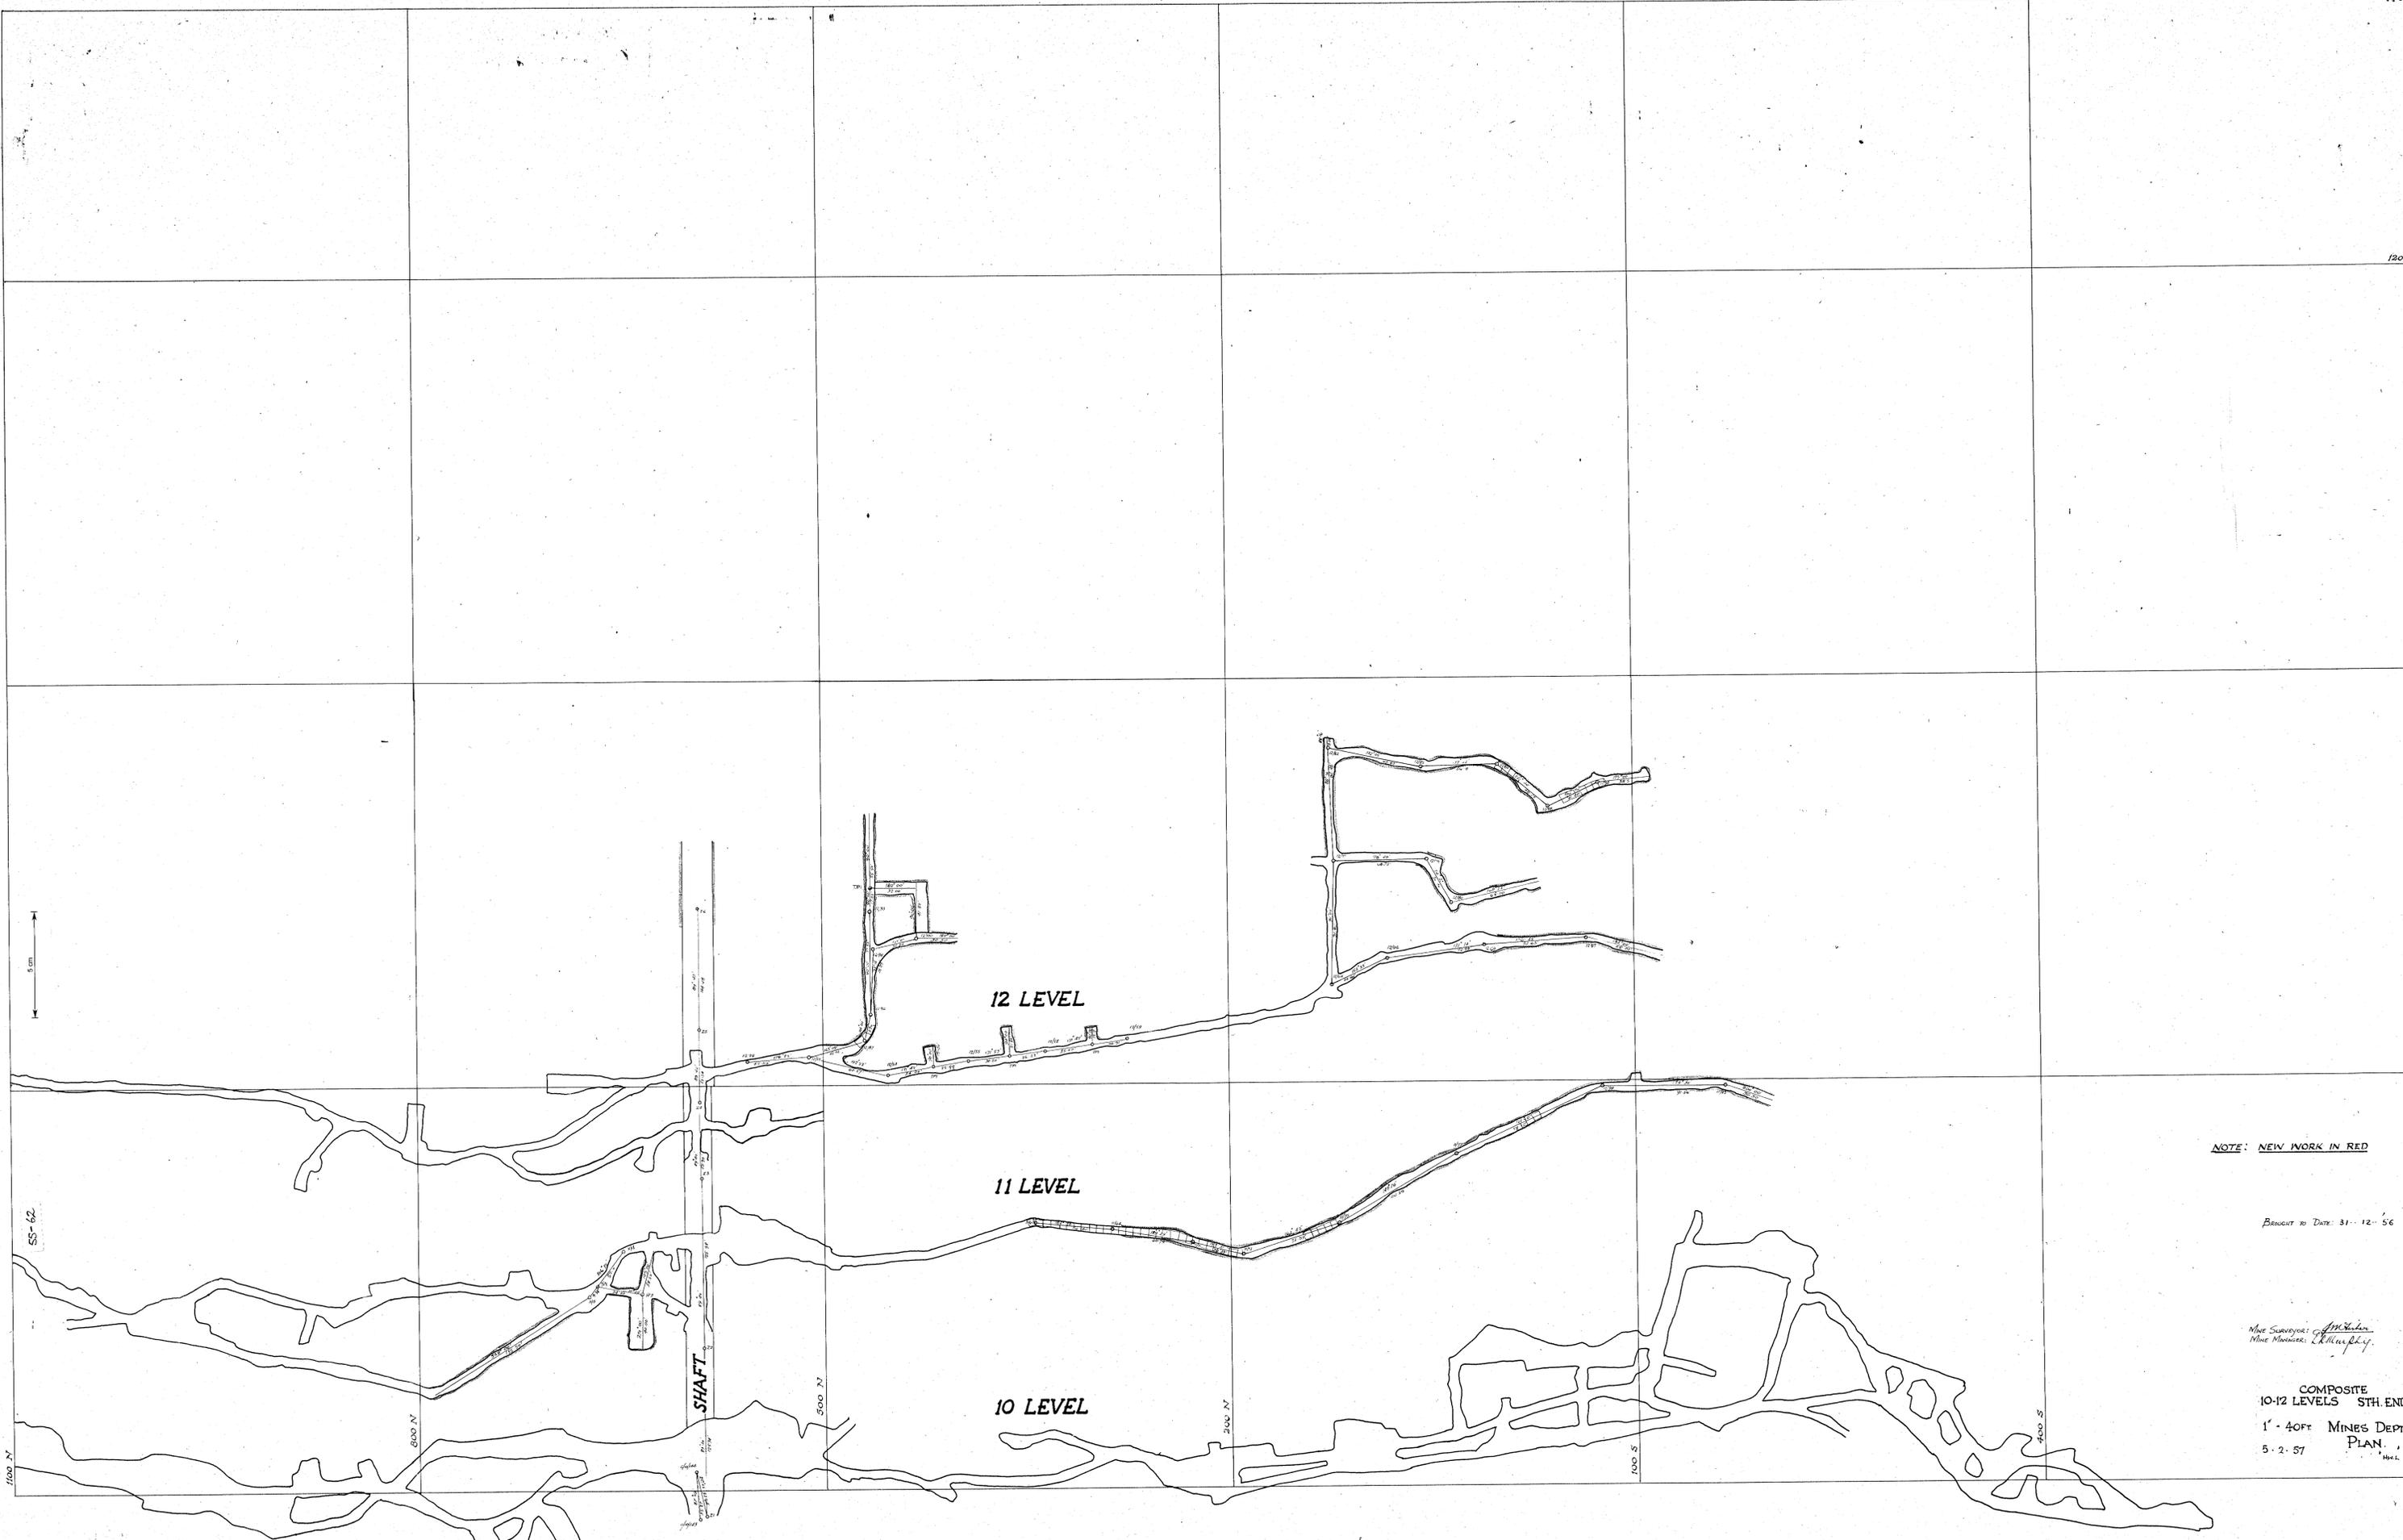

12 LEVEL

11 LEVEL

10 LEVEL

SHAFT

NOTE: NEW WORK IN RED

Revised to Date: 31-12-56

Mine Surveyor: *[Signature]*
Mine Manager: *[Signature]*

COMPOSITE
10-12 LEVELS STH. END
1" = 40 FT. MINES DEPT.
PLAN
5-2-57

5 cm

SS-62

1000 N

800 N

500 N

200 N

700 S

400 S

300 S