
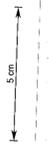


55-67

55-67

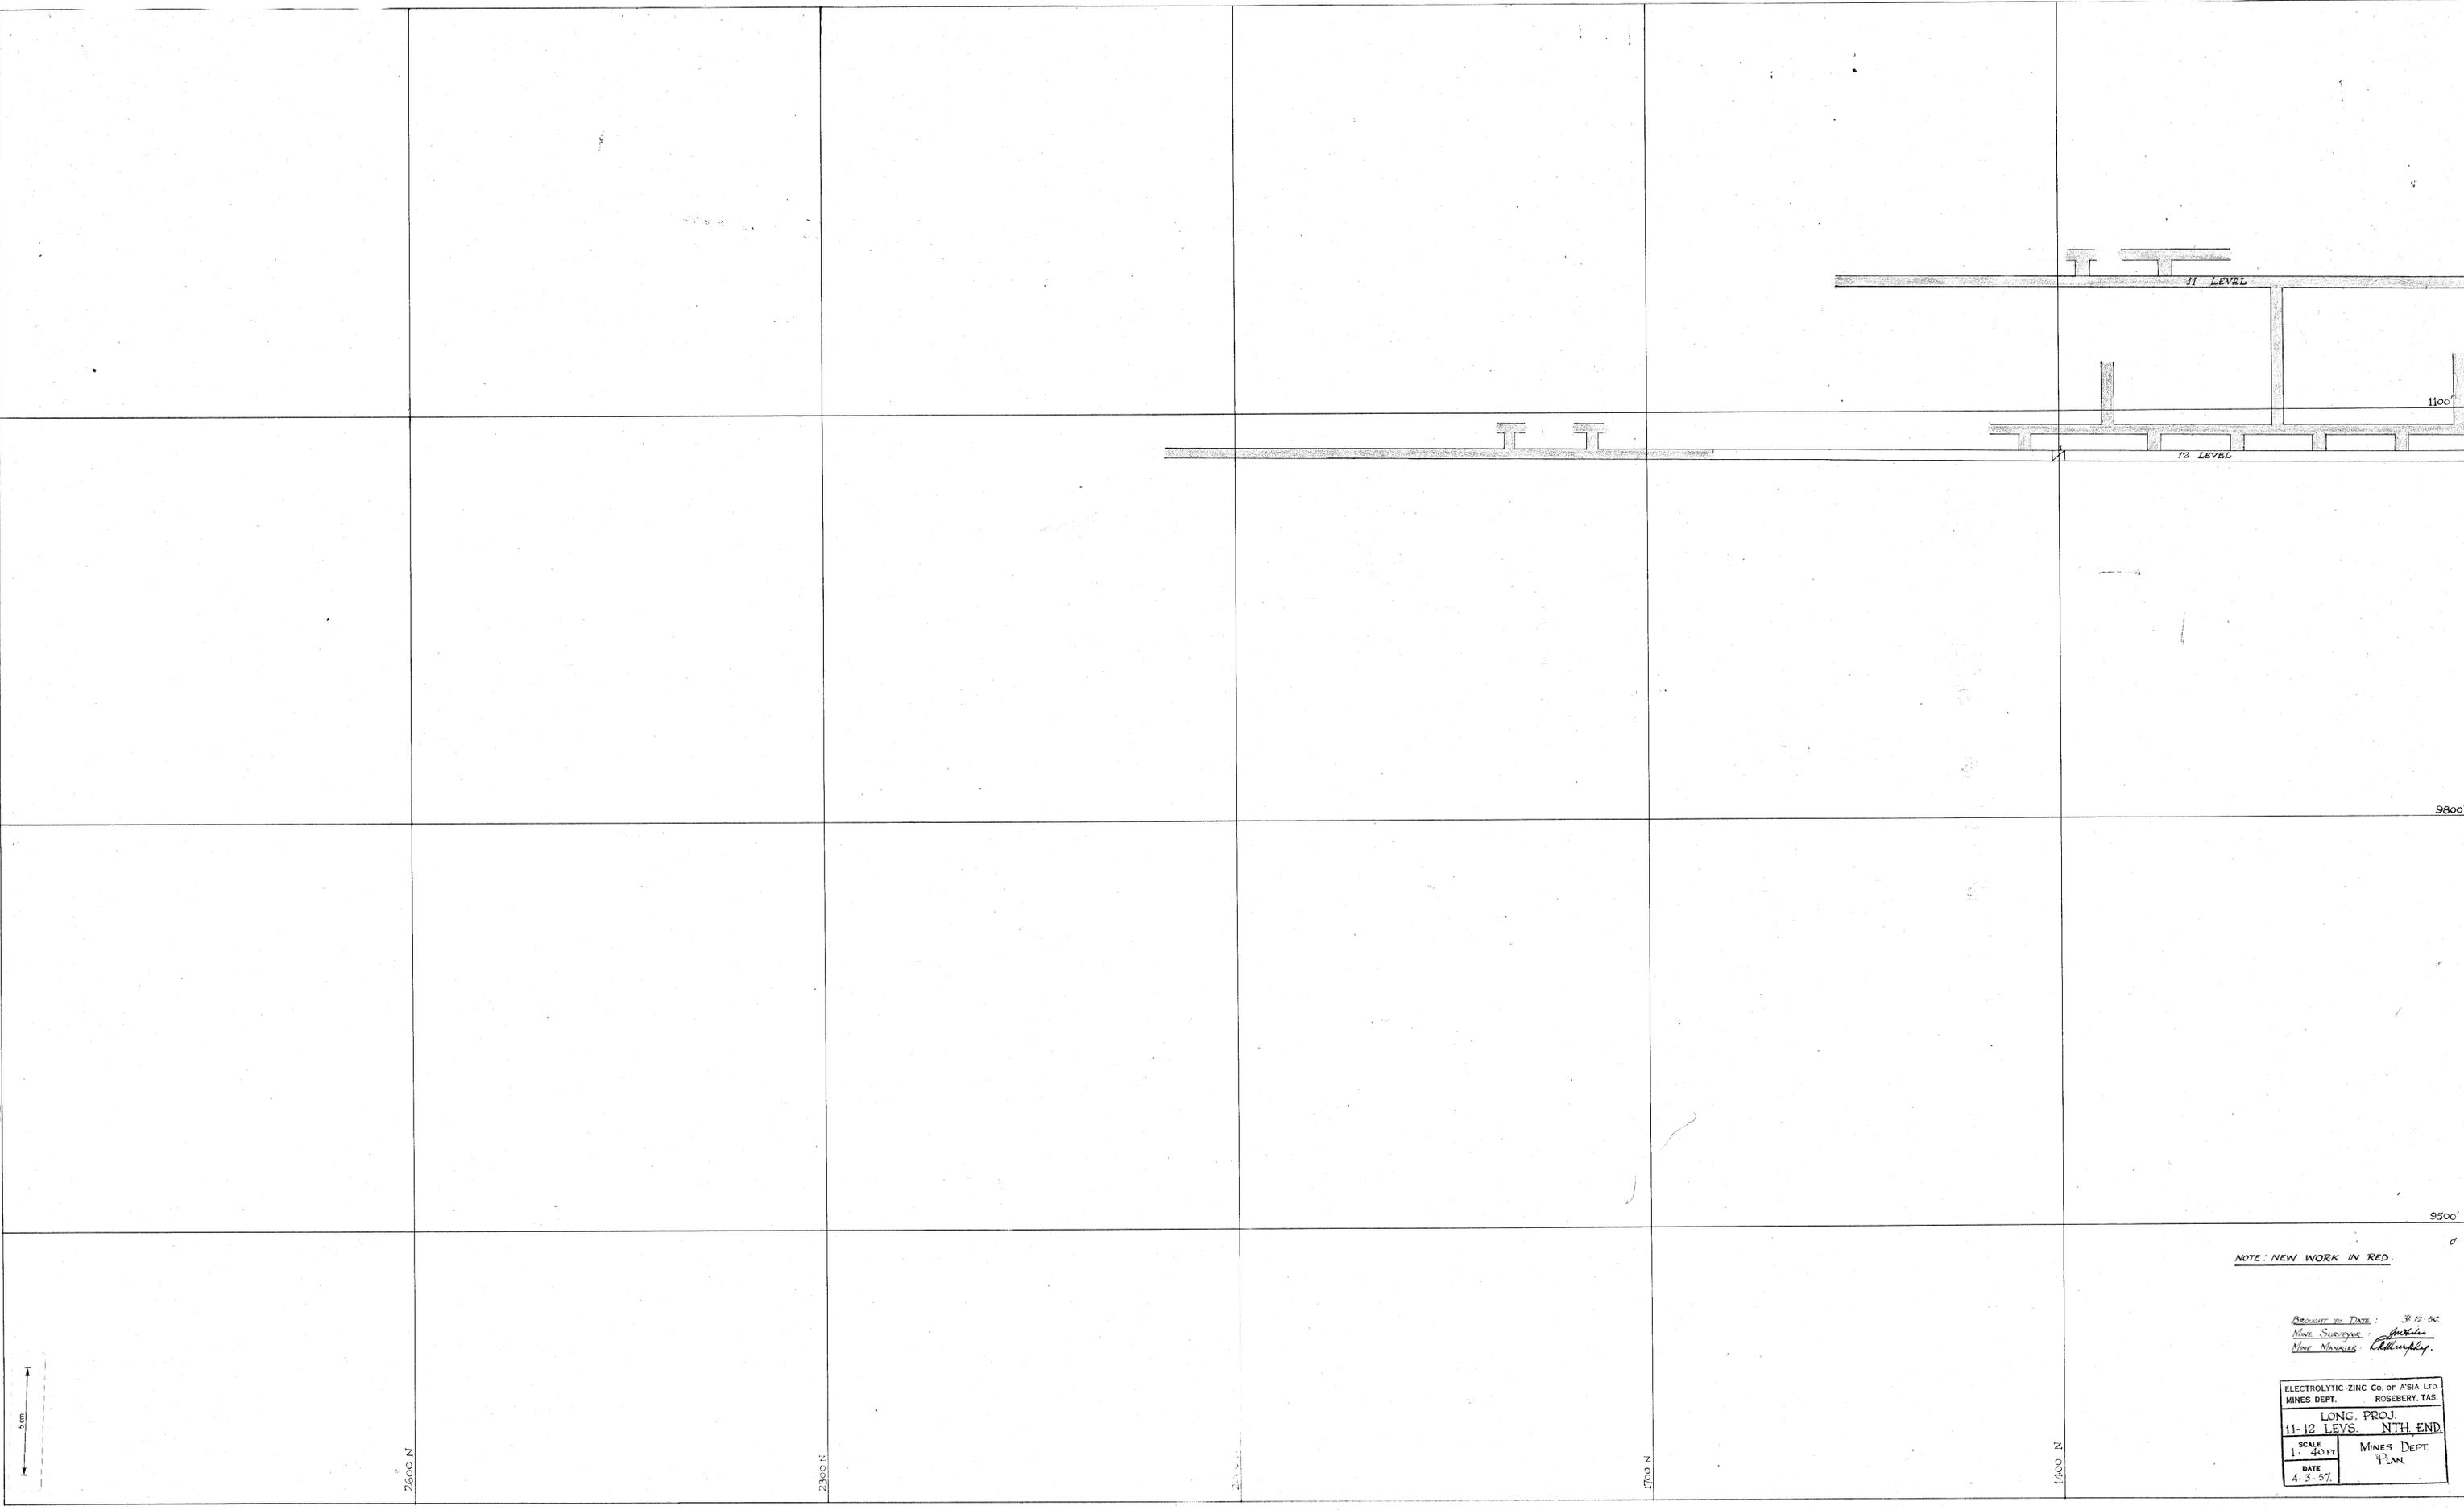

2600 N

2300 N

2000 N

1700 N

1400 N

9800'

9500'

NOTE: NEW WORK IN RED.

Approved by Date: 3/12/57  
 Mine Surveyor: *[Signature]*  
 Mine Manager: *[Signature]*

ELECTROLYTIC ZINC CO. OF ASIA LTD.	
MINES DEPT. ROSEBERY, TAS.	
LONG. PROJ.	
11-12 LEVS. NTH. END.	
SCALE	MINES DEPT.
1" = 40 FT.	PLAN
DATE	
4. 3. 57.	

1100 N