


55-68

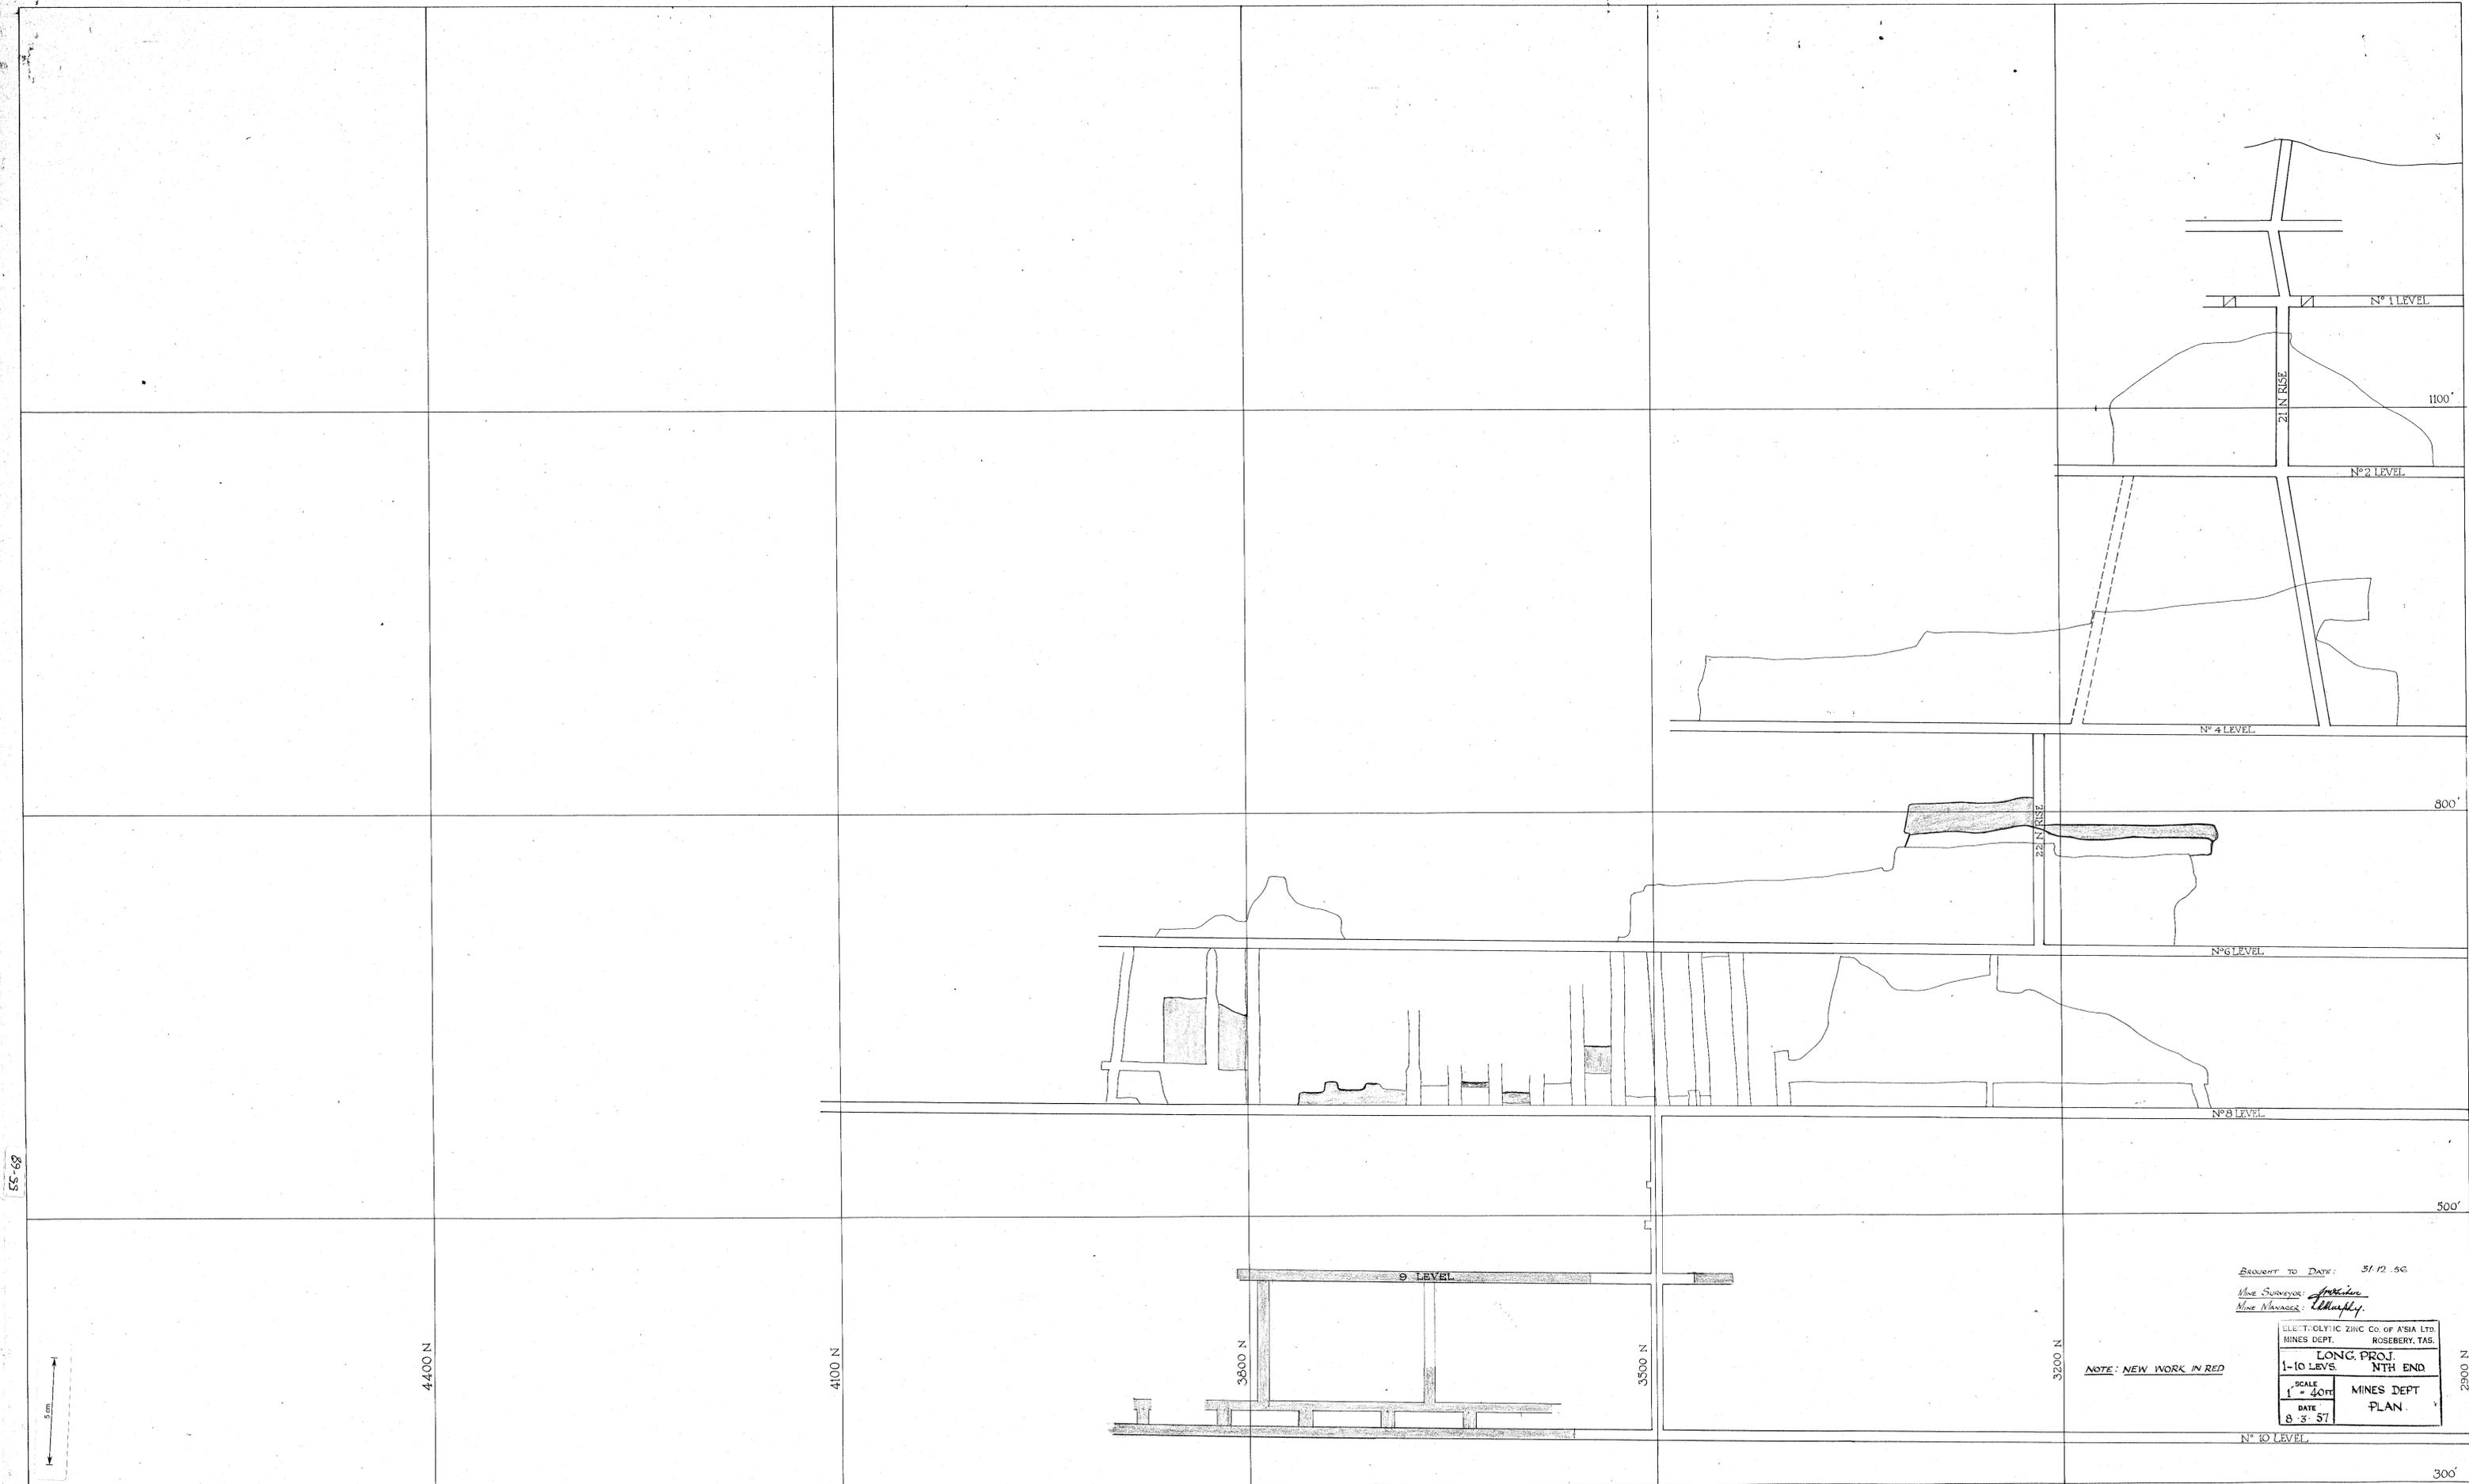

5 cm

4400 N

4100 N

3800 N

3500 N

3200 N

2900 N

No. 1 LEVEL

1100'

No. 2 LEVEL

No. 4 LEVEL

800'

No. 6 LEVEL

No. 8 LEVEL

500'

9 LEVEL

NOTE: NEW WORK IN RED

BROUGHT TO DATE: 31.12.56  
 Mine Surveyor: *Arthur*  
 Mine Manager: *Whalley*

ELECTROLYTIC ZINC CO. OF ASIA LTD.	
MINES DEPT. ROSEBERY, TAS.	
LONG. PROJ.	NTH END
1-10 LEVS.	
SCALE	MINES DEPT
1" = 40 FT	PLAN.
DATE	
8-3-57	

No. 10 LEVEL

300'