

55-69


55-69

BRINGED TO DATE: 31.12.56

Min. Surveyor: *[Signature]*
Min. Assistant: *[Signature]*

ELECTROLYTIC ZINC CO. OF ASIA LTD.	
MINES DEPT. ROSEBERY, TAS.	
LONG. PROJ.	
1-10 LEVS 1100N - 2900N	
SCALE	MINES DEPT.
1" = 40 FT	PLAN
DATE	HWL
27.3.57	

NOTE: NEW WORK IN RED

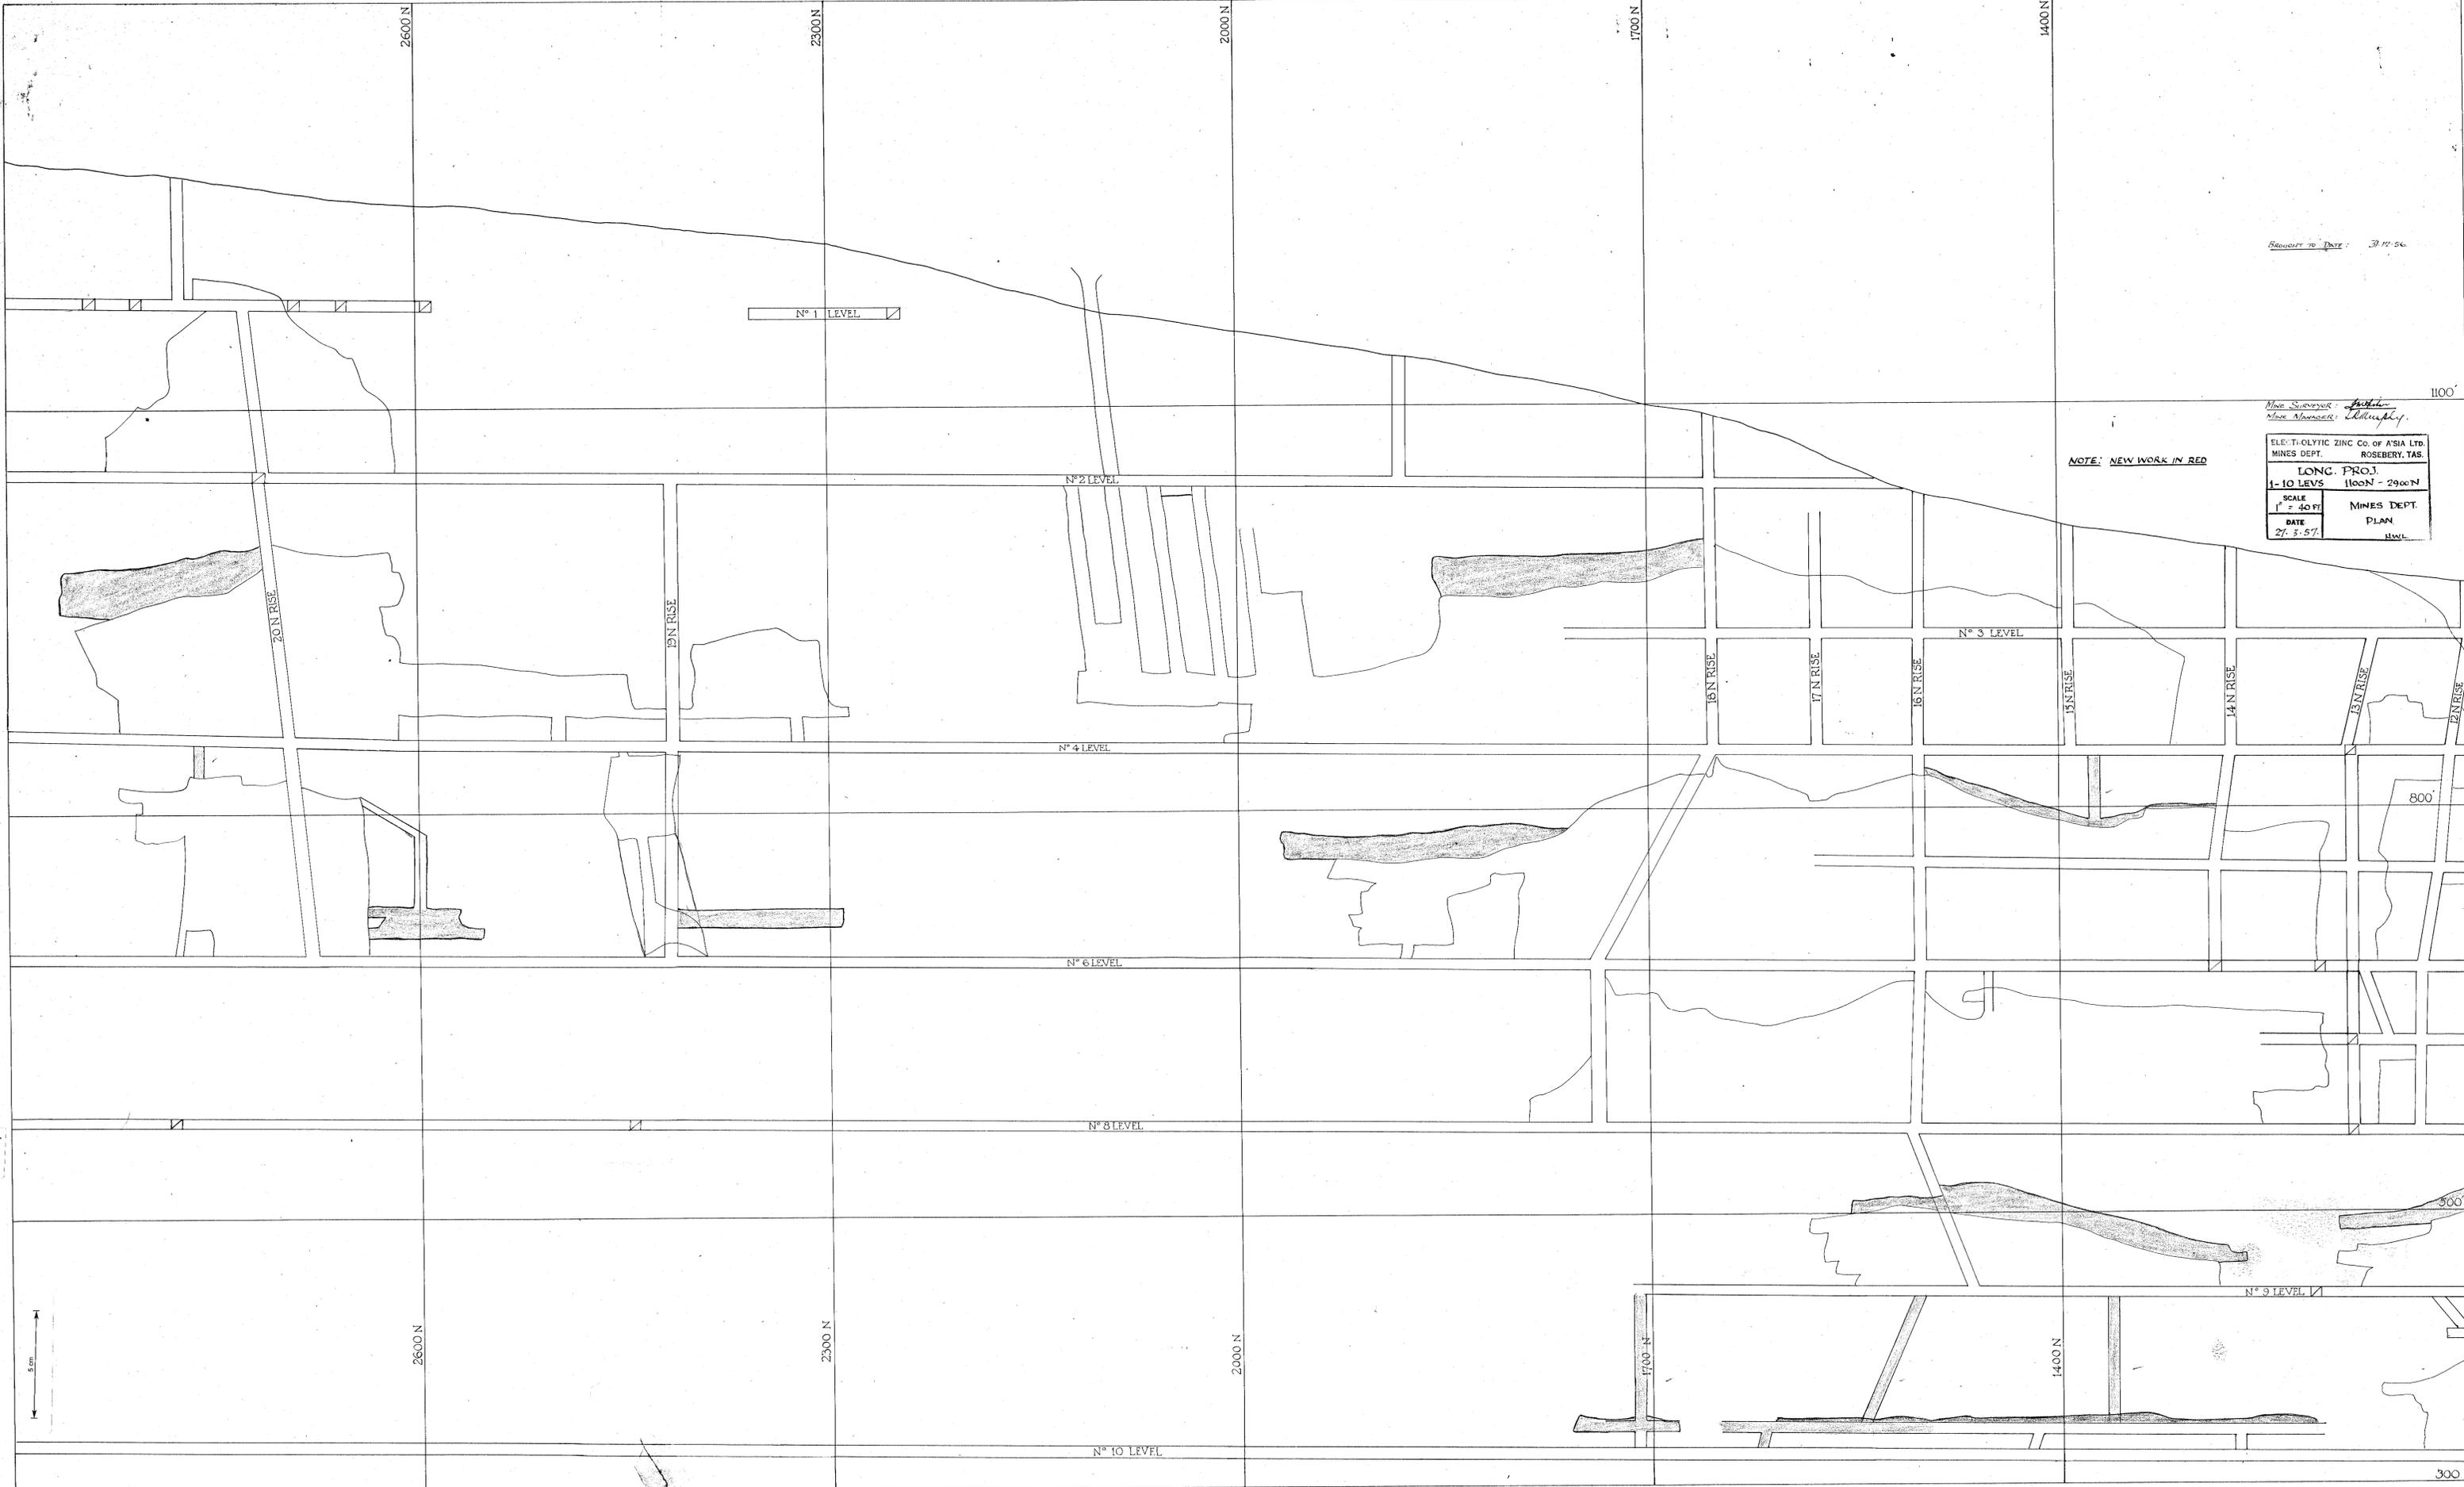

1100

800

500

300