


70 30

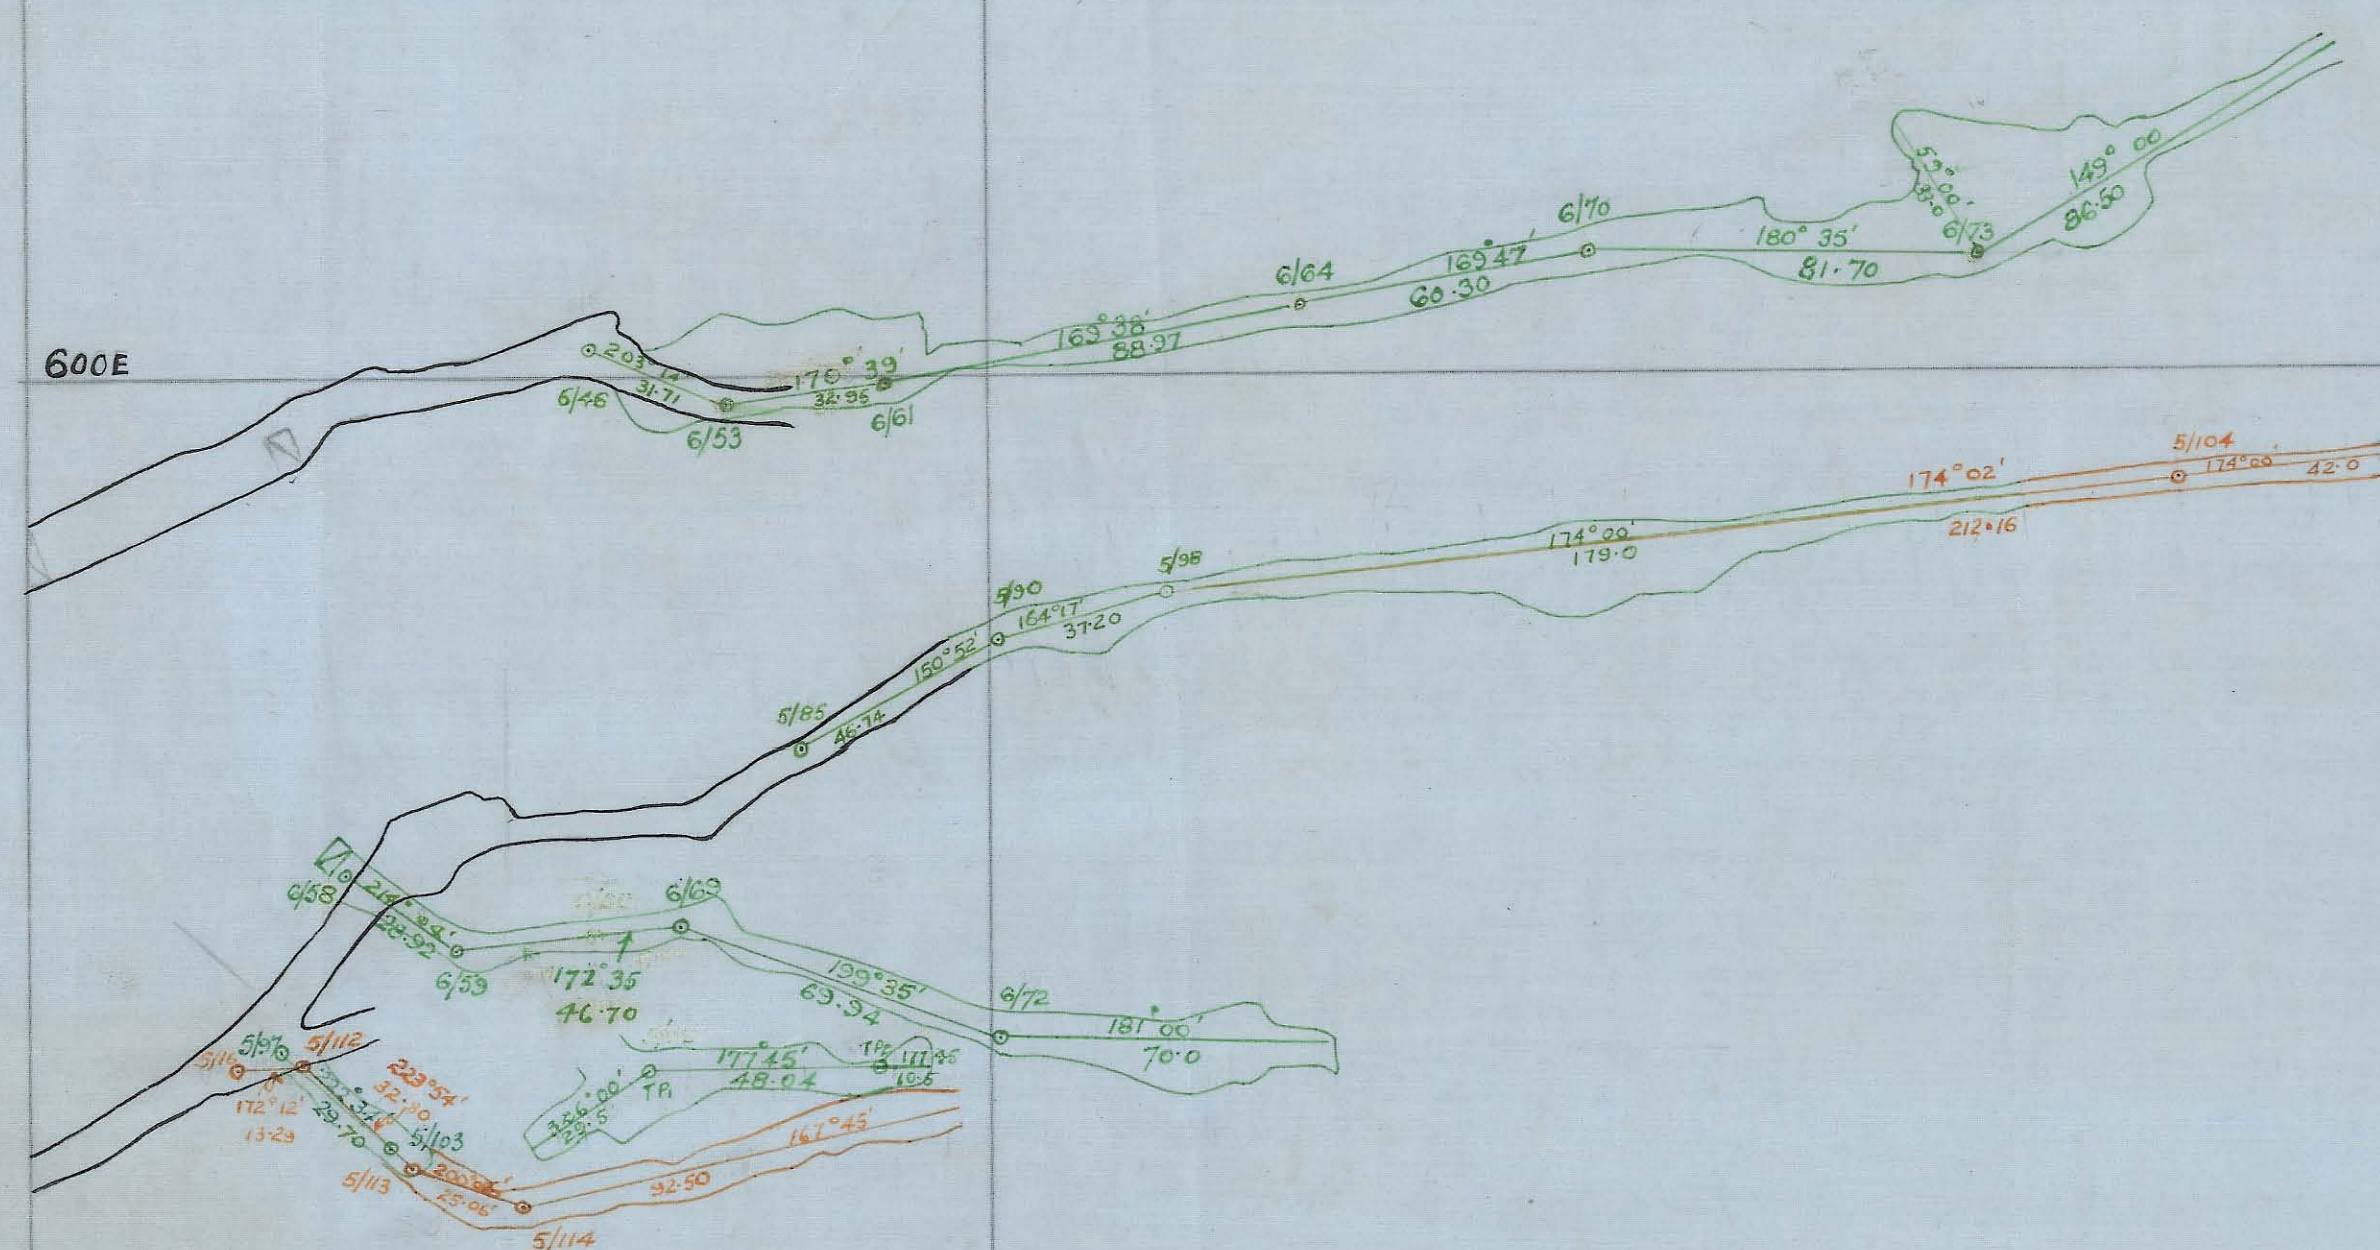

31 st	Dec	1954	■	L. Murphy.	J.M. Fisher
"	"	1955	■	L. Murphy.	J.M. Fisher

ELECTROLYTIC ZINC COMPANY
OF AUSTRALASIA LTD.
HERCULES ANNE ROSEBURY

6,6B,6D & 5 LEVS.

Scale: 1" = 40'

Date _____

Survey by
Geology by

PLAN No.
SHEET No.

27-68

21.200