


5 cm

55-74

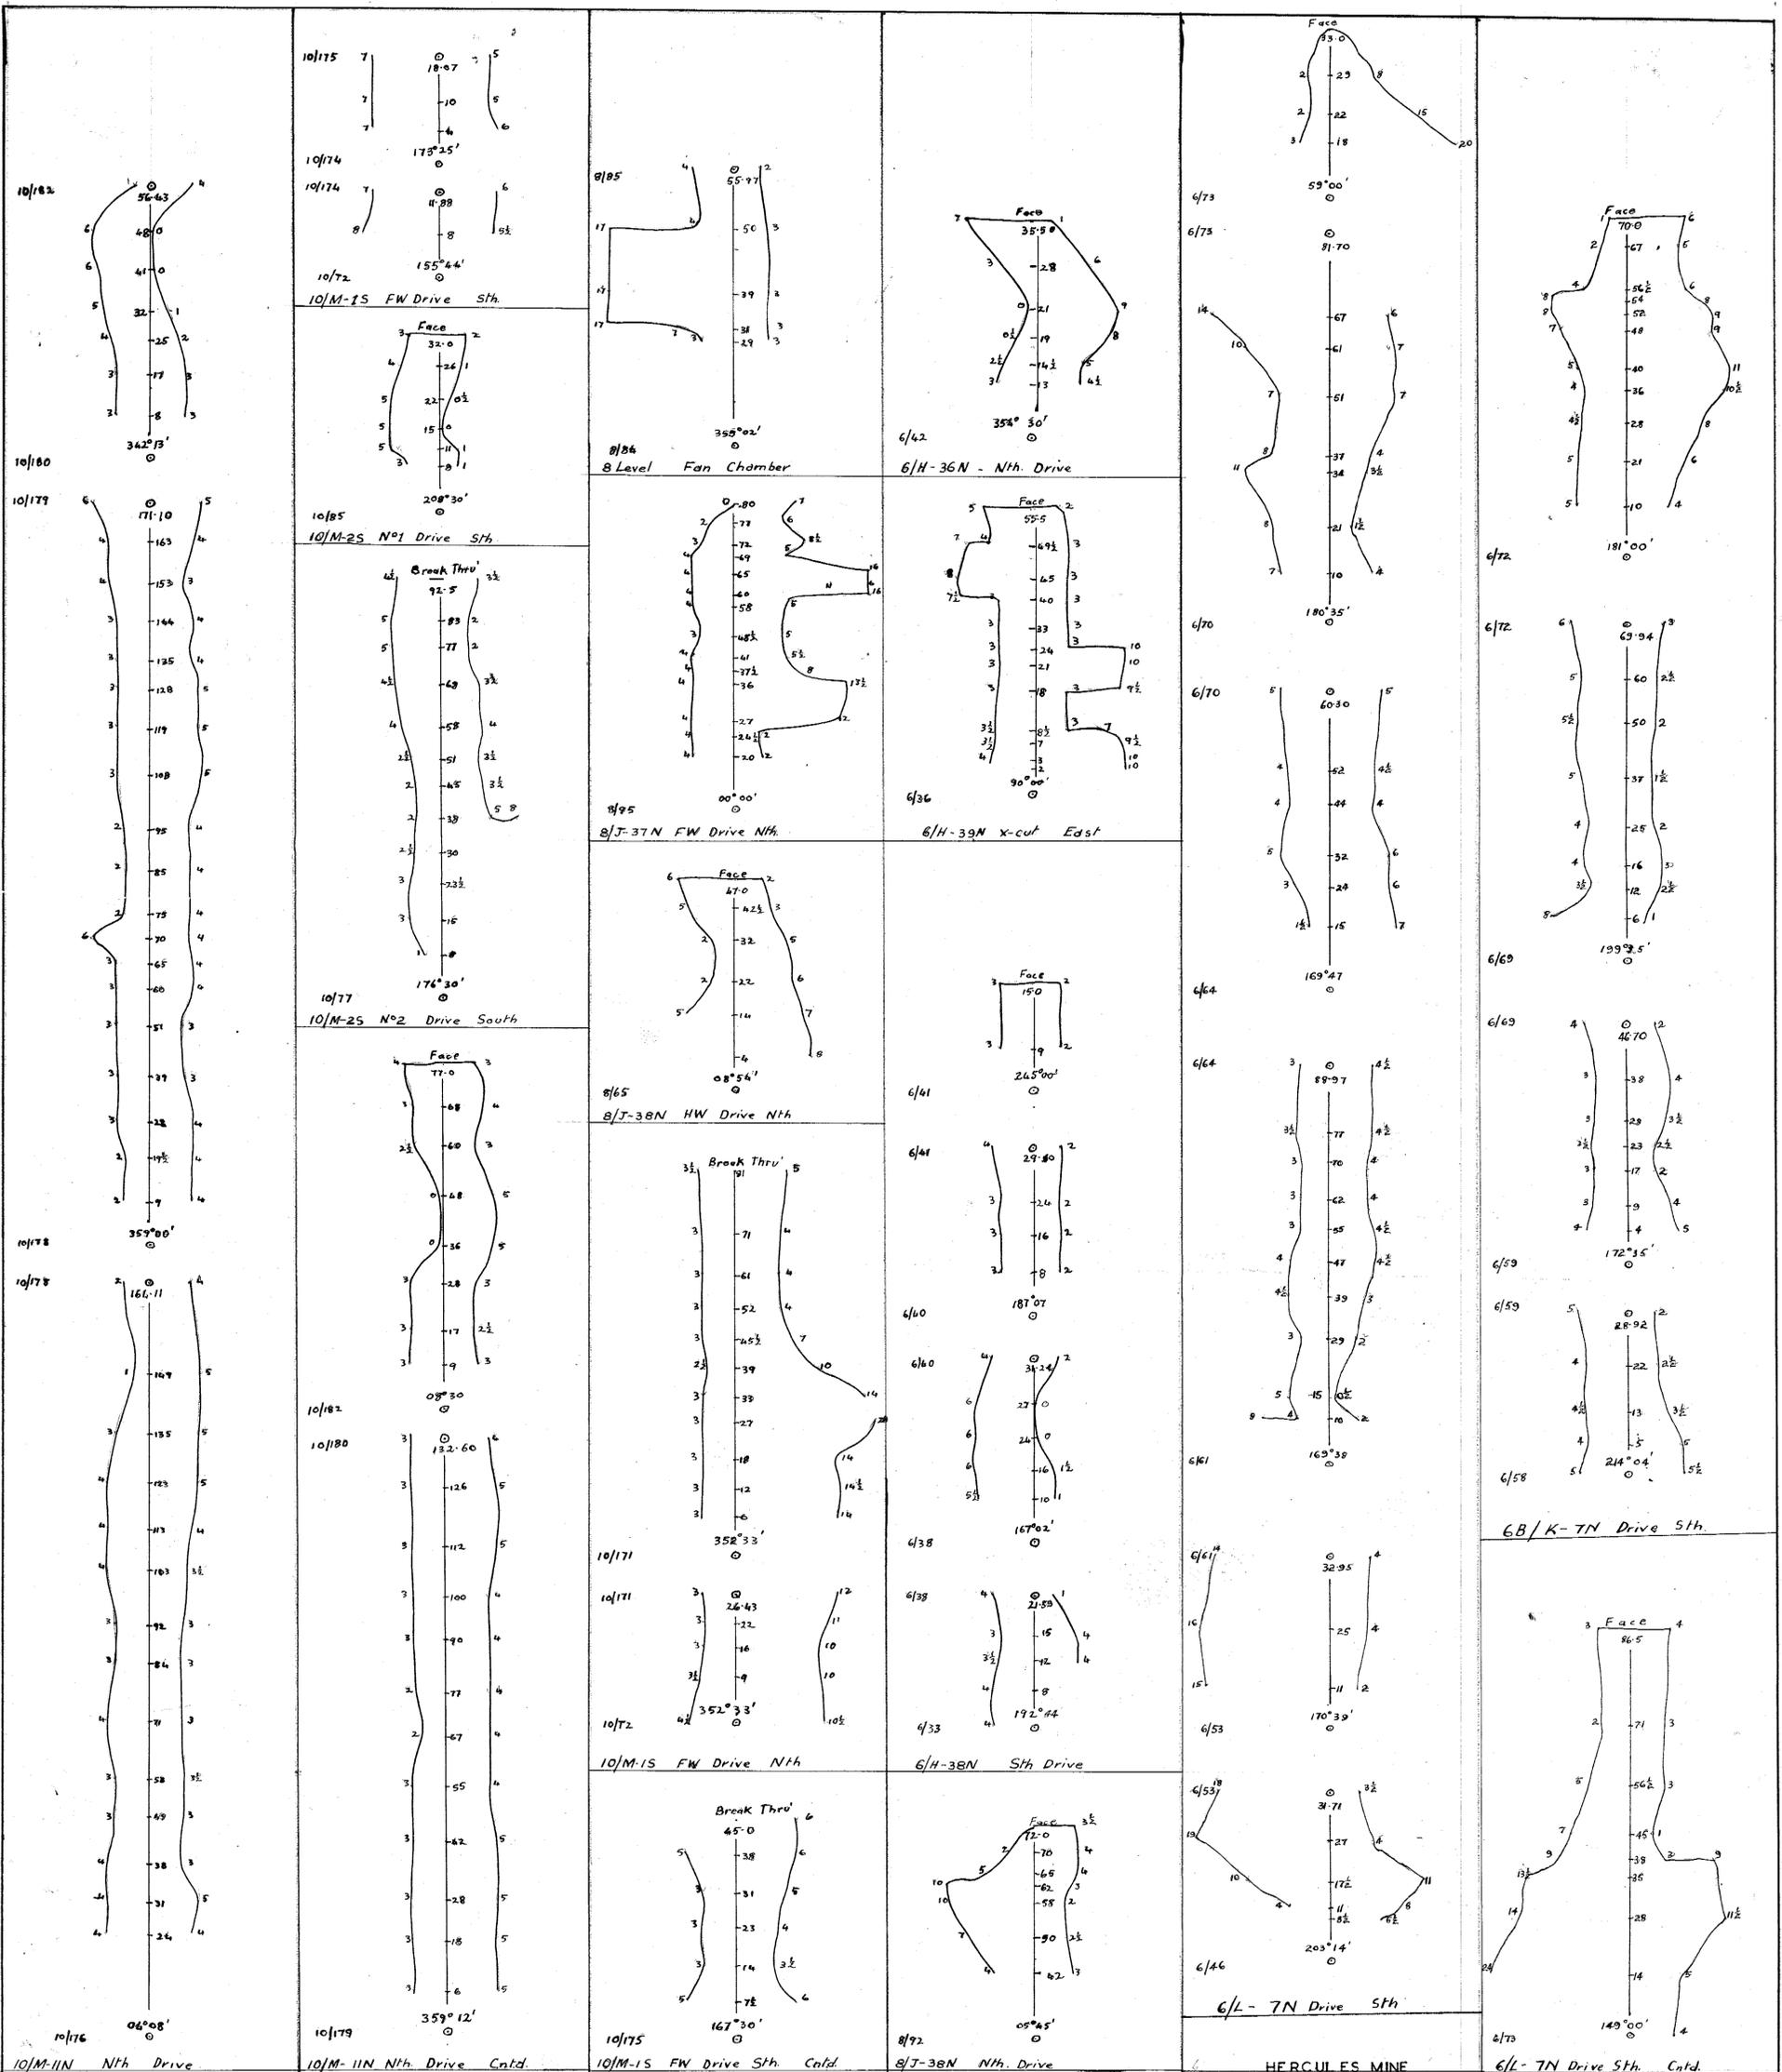

ELECTROLYTIC ZINC COMPANY OF ASIA LTD.
ROSEBERRY & HERCULES MINES
FIELD NOTES.

MINE MANAGER *Ed Murphy*
 MINE SURVEYOR *J. M. Fisher*

BROUGHT UP TO 31ST DEC. 1954
 WATTS MICROPTIC THEODOLITE B50