

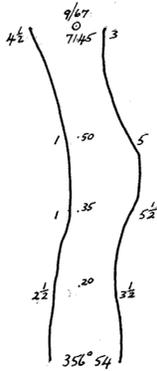
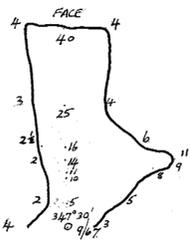



10 LEV. CHARGING STN.

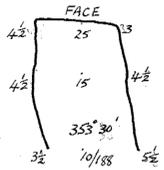


9K-16N DRIVE NTH

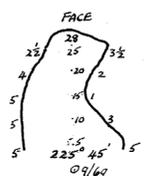


9K 36 DRIVE STH

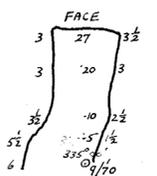


9K 36N DRIVE NTH

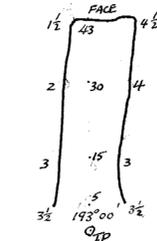

10M-2S H/W DRIVE STH

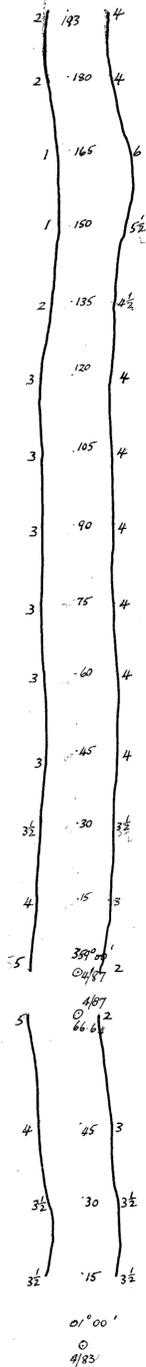


4E-16N DRIVE NTH

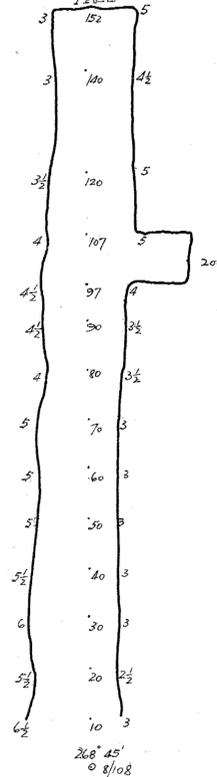


8J-8N X-CUT WEST

10/L-17N F/W DRIVE NTH

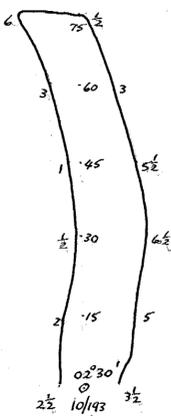

10MN-11N DRIVE NTH

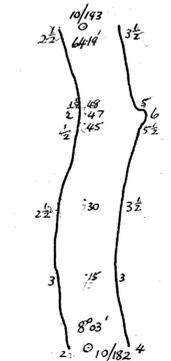

ELECTROLYTIC ZINC CO. OF ASIA LTD.

ROSEBERY and HERCULES MINES

FIELD NOTES

MINE MANAGER : *R. Murphy*
MINE SURVEYOR : *J. M. Fisher*

BROUGHT UP TO 31 DEC 1955