


SS-78

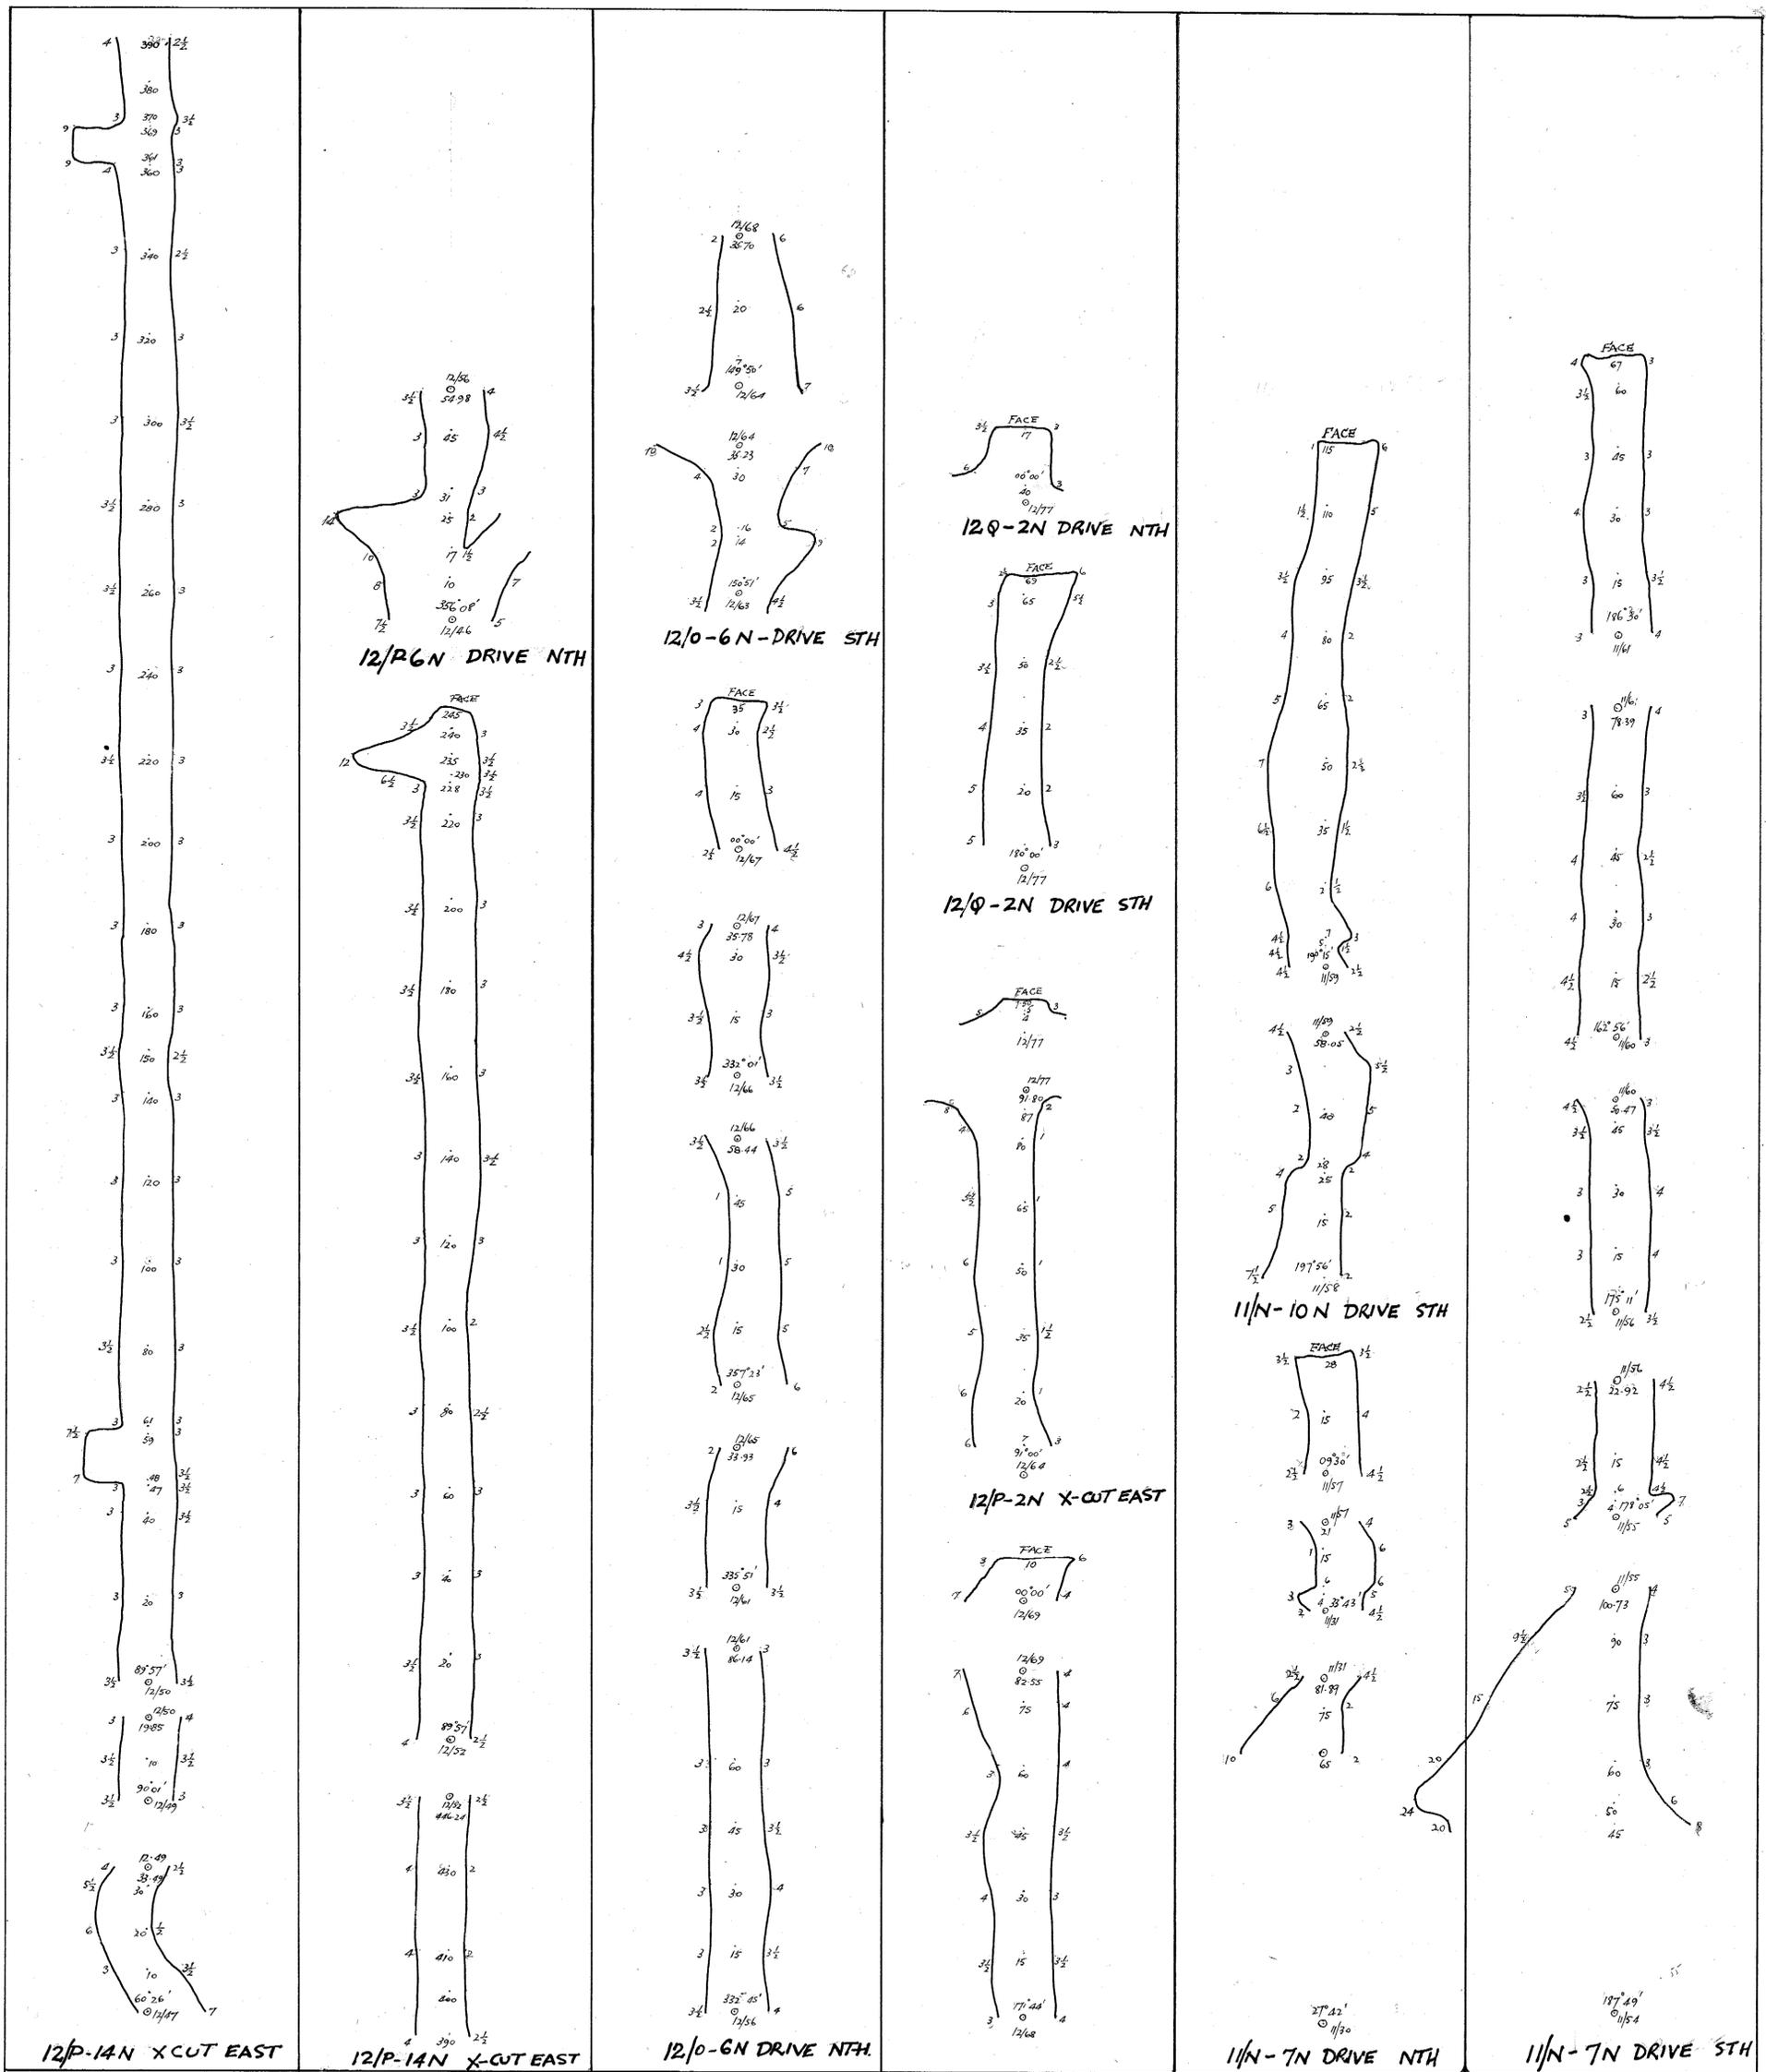

ELECTROLYTIC ZINC COMPANY OF ASIA LTD.
ROSEBERY & HERCULES MINES
FIELD NOTES

MINE MANAGER *W. Murphy*
 MINE SURVEYOR *J. M. Forbes*

BROUGHT UP TO 31st DEC 1955
 WATTS MICROPTIC THEODOLITE B50