


55-79

55-79

5 cm

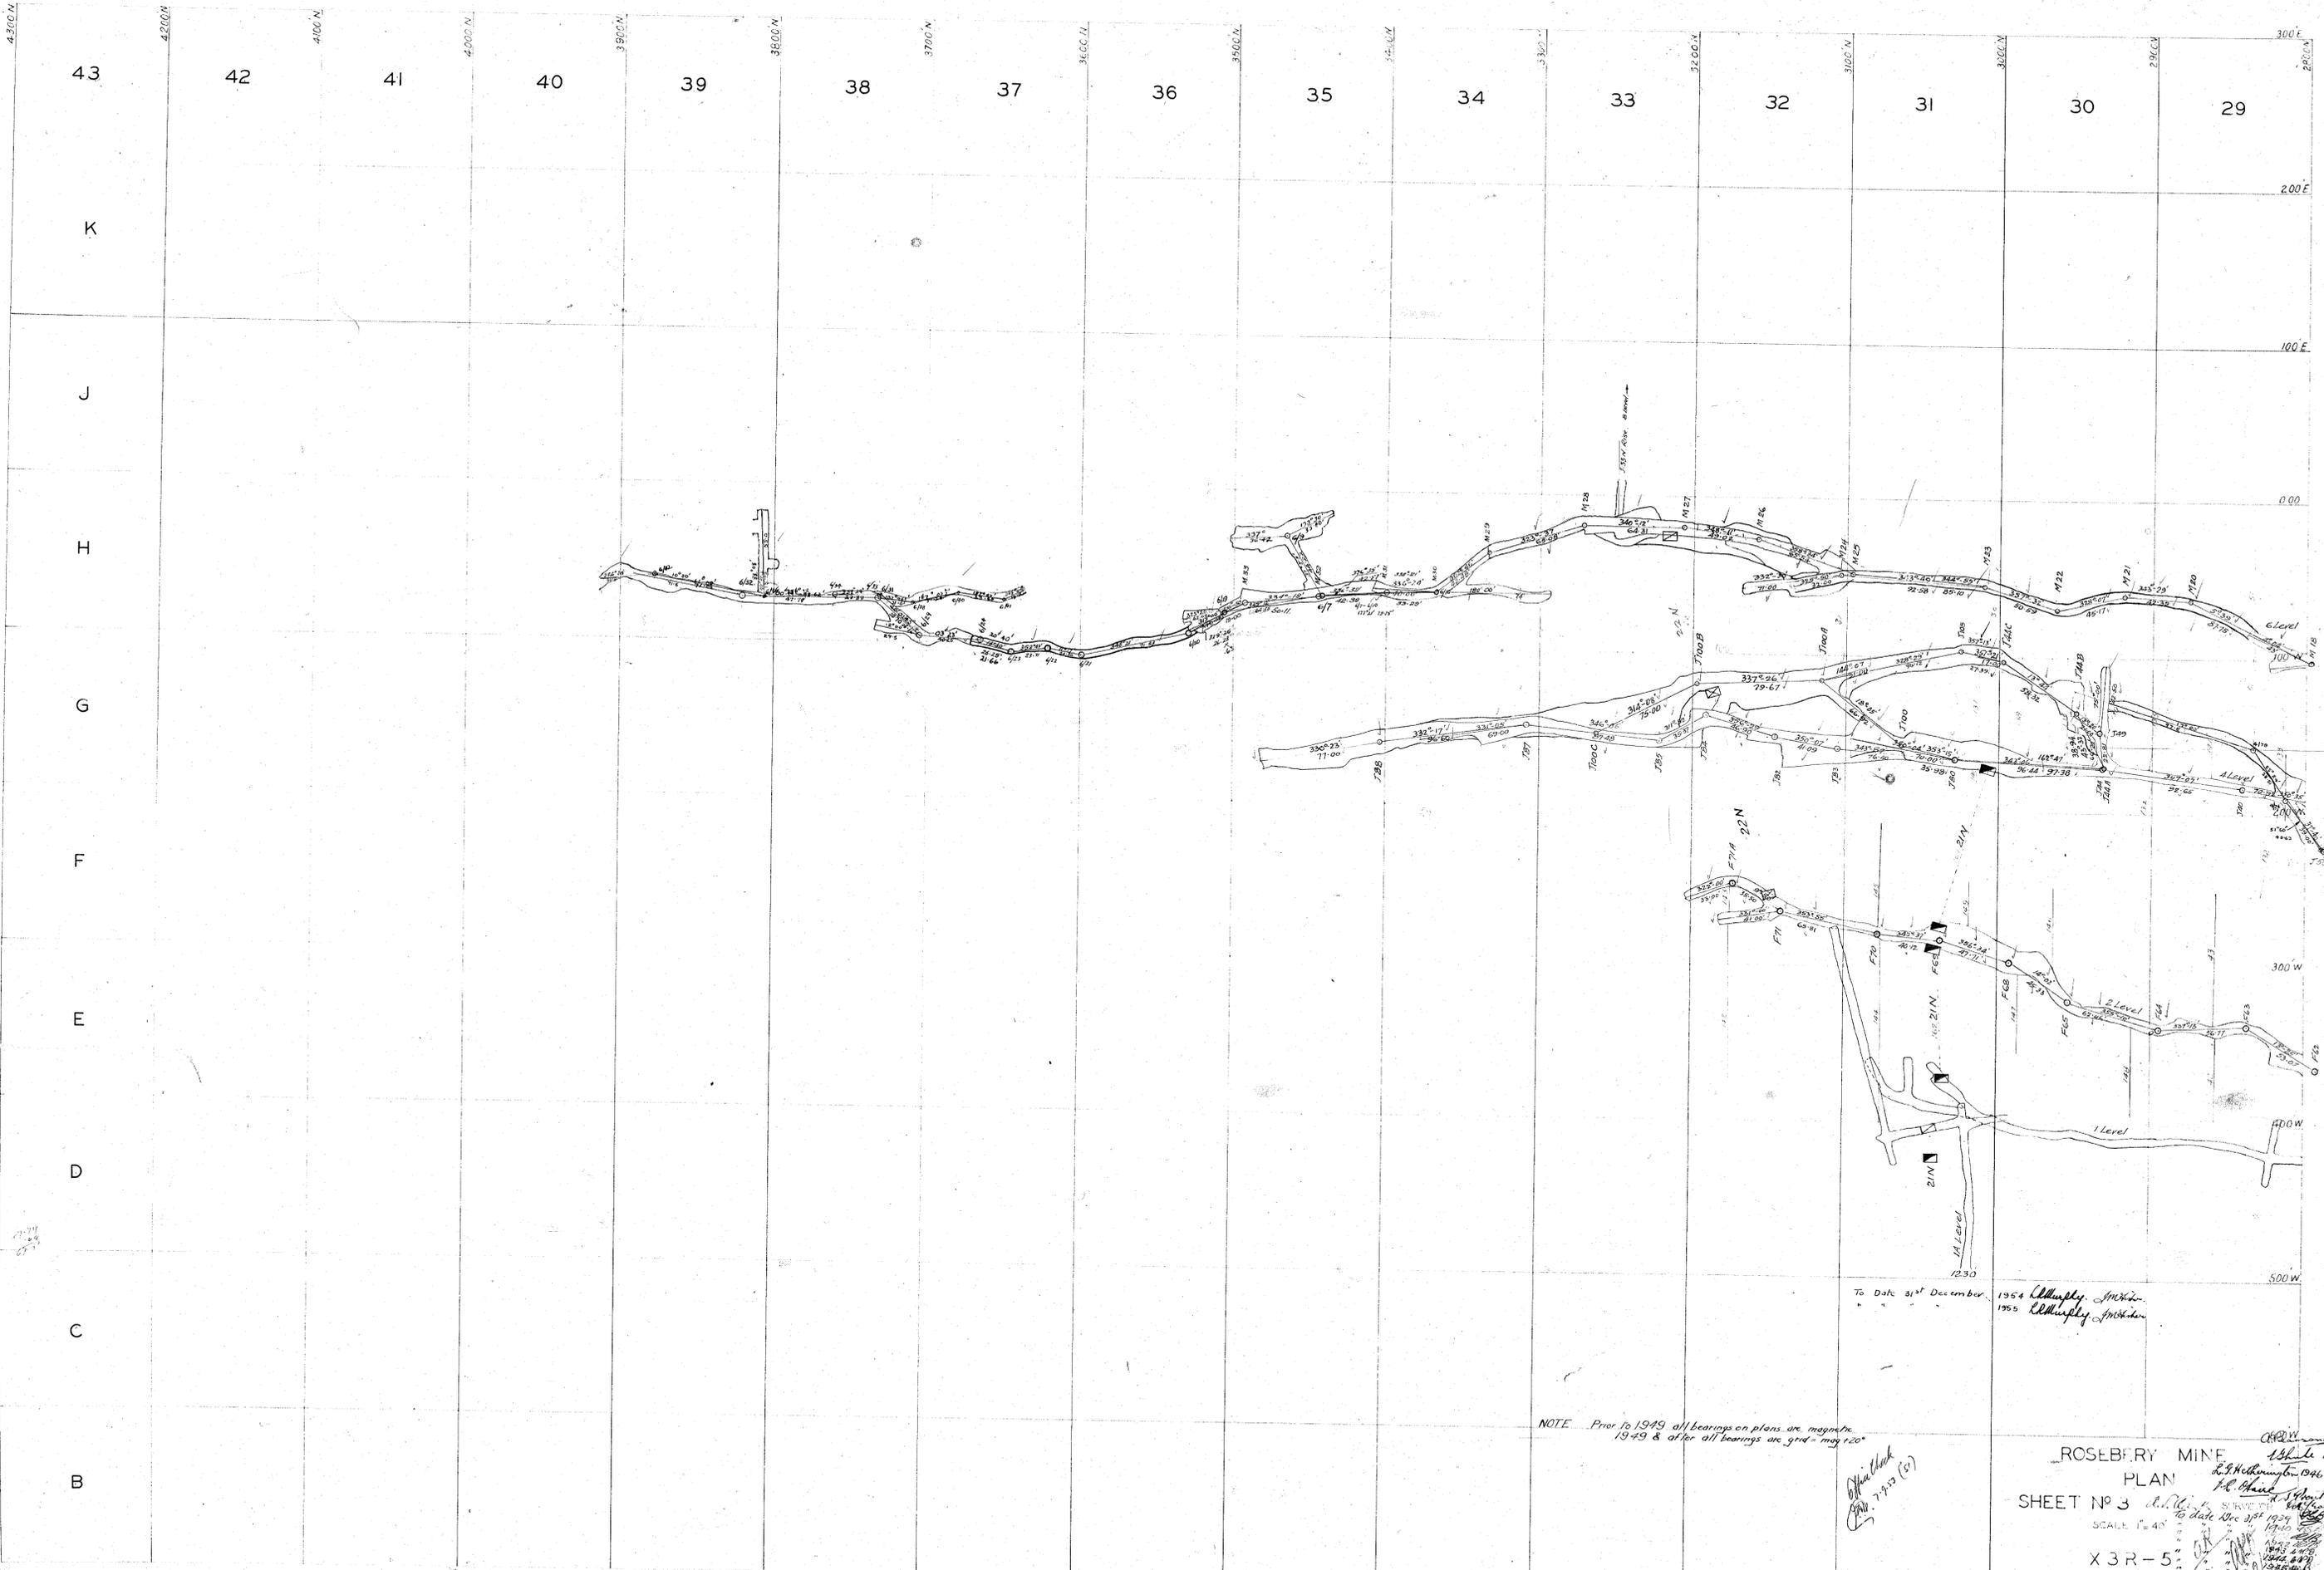

To Date 31st December, 1954 *Albany, S.M.A.*
 1955 *Albany, S.M.A.*

NOTE Prior to 1949 all bearings on plans are magnetic
 1949 & after all bearings are grid magnetic

*Official Plan
 No. 7-113 (5)*

ROSEBERY MINE
 PLAN
 SHEET No 3
 SCALE 1" = 40'
 X 3 R - 5

1953
1954
1955
2000