
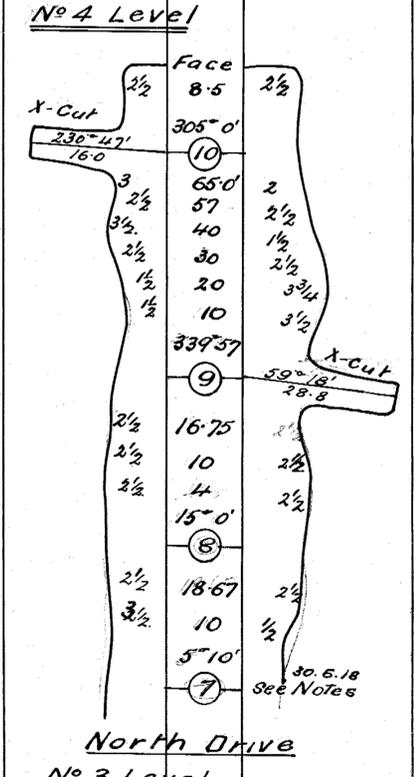
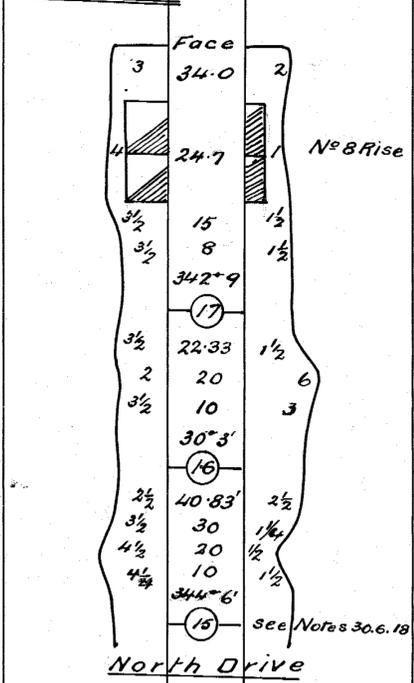
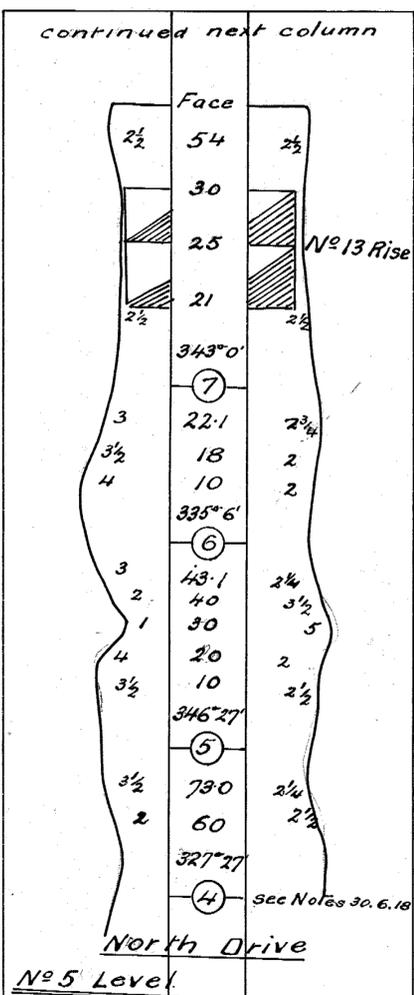


THE MOUNT READ & ROSEBERY MINES LTD



MINE DEPARTMENT

Field Notes of Underground Workings
Instrument used 5" Theodolite




Robt. Light General Manager
R. Murray Engineer-in-Charge

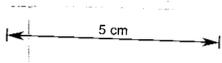

Brought up to 31st Dec 1918
Underground Workings
Rosebery Mine
Field Notes of Survey

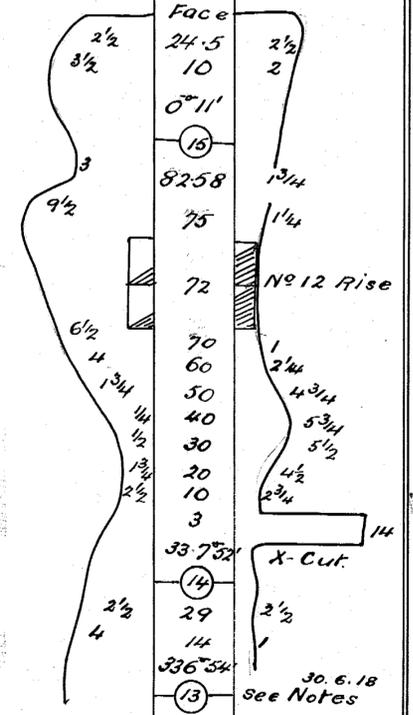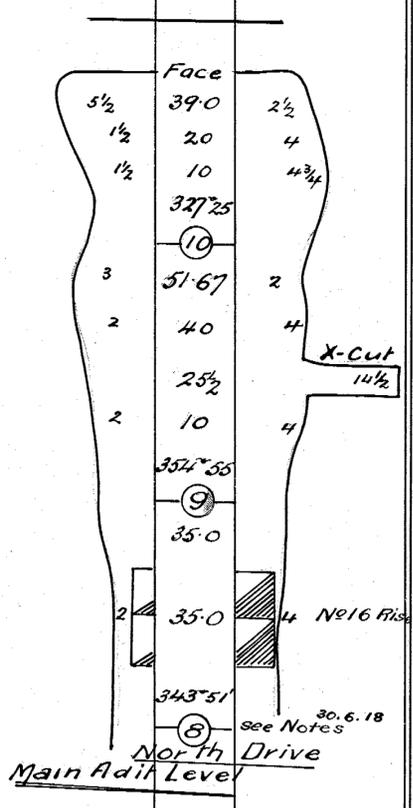

continued from last column
North Drive
No 6 Level
Field Notes of Survey

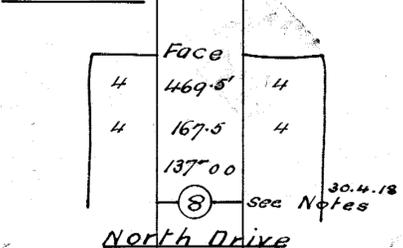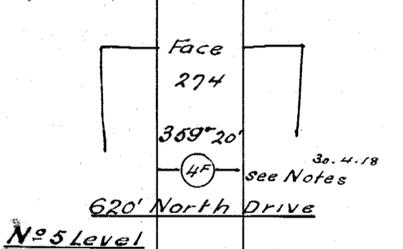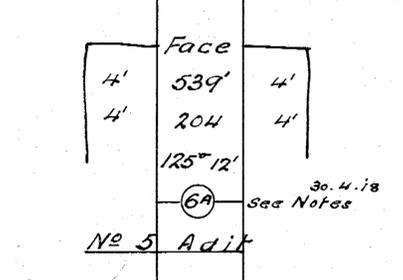

Brought up to 31st Dec 1918
Underground Workings
Hercules Mine
Field Notes of Survey