






THE MOUNT READ & ROSEBERY MINES LTD

Mine Department.

Field Notes of Underground Workings

Robt. Licht General Manager

Instrument used 5" Theodolite.

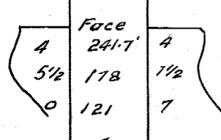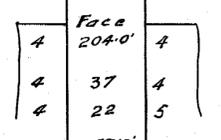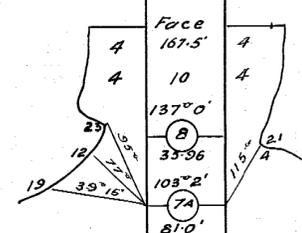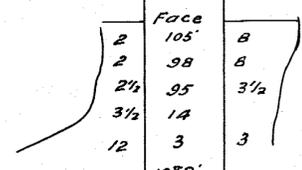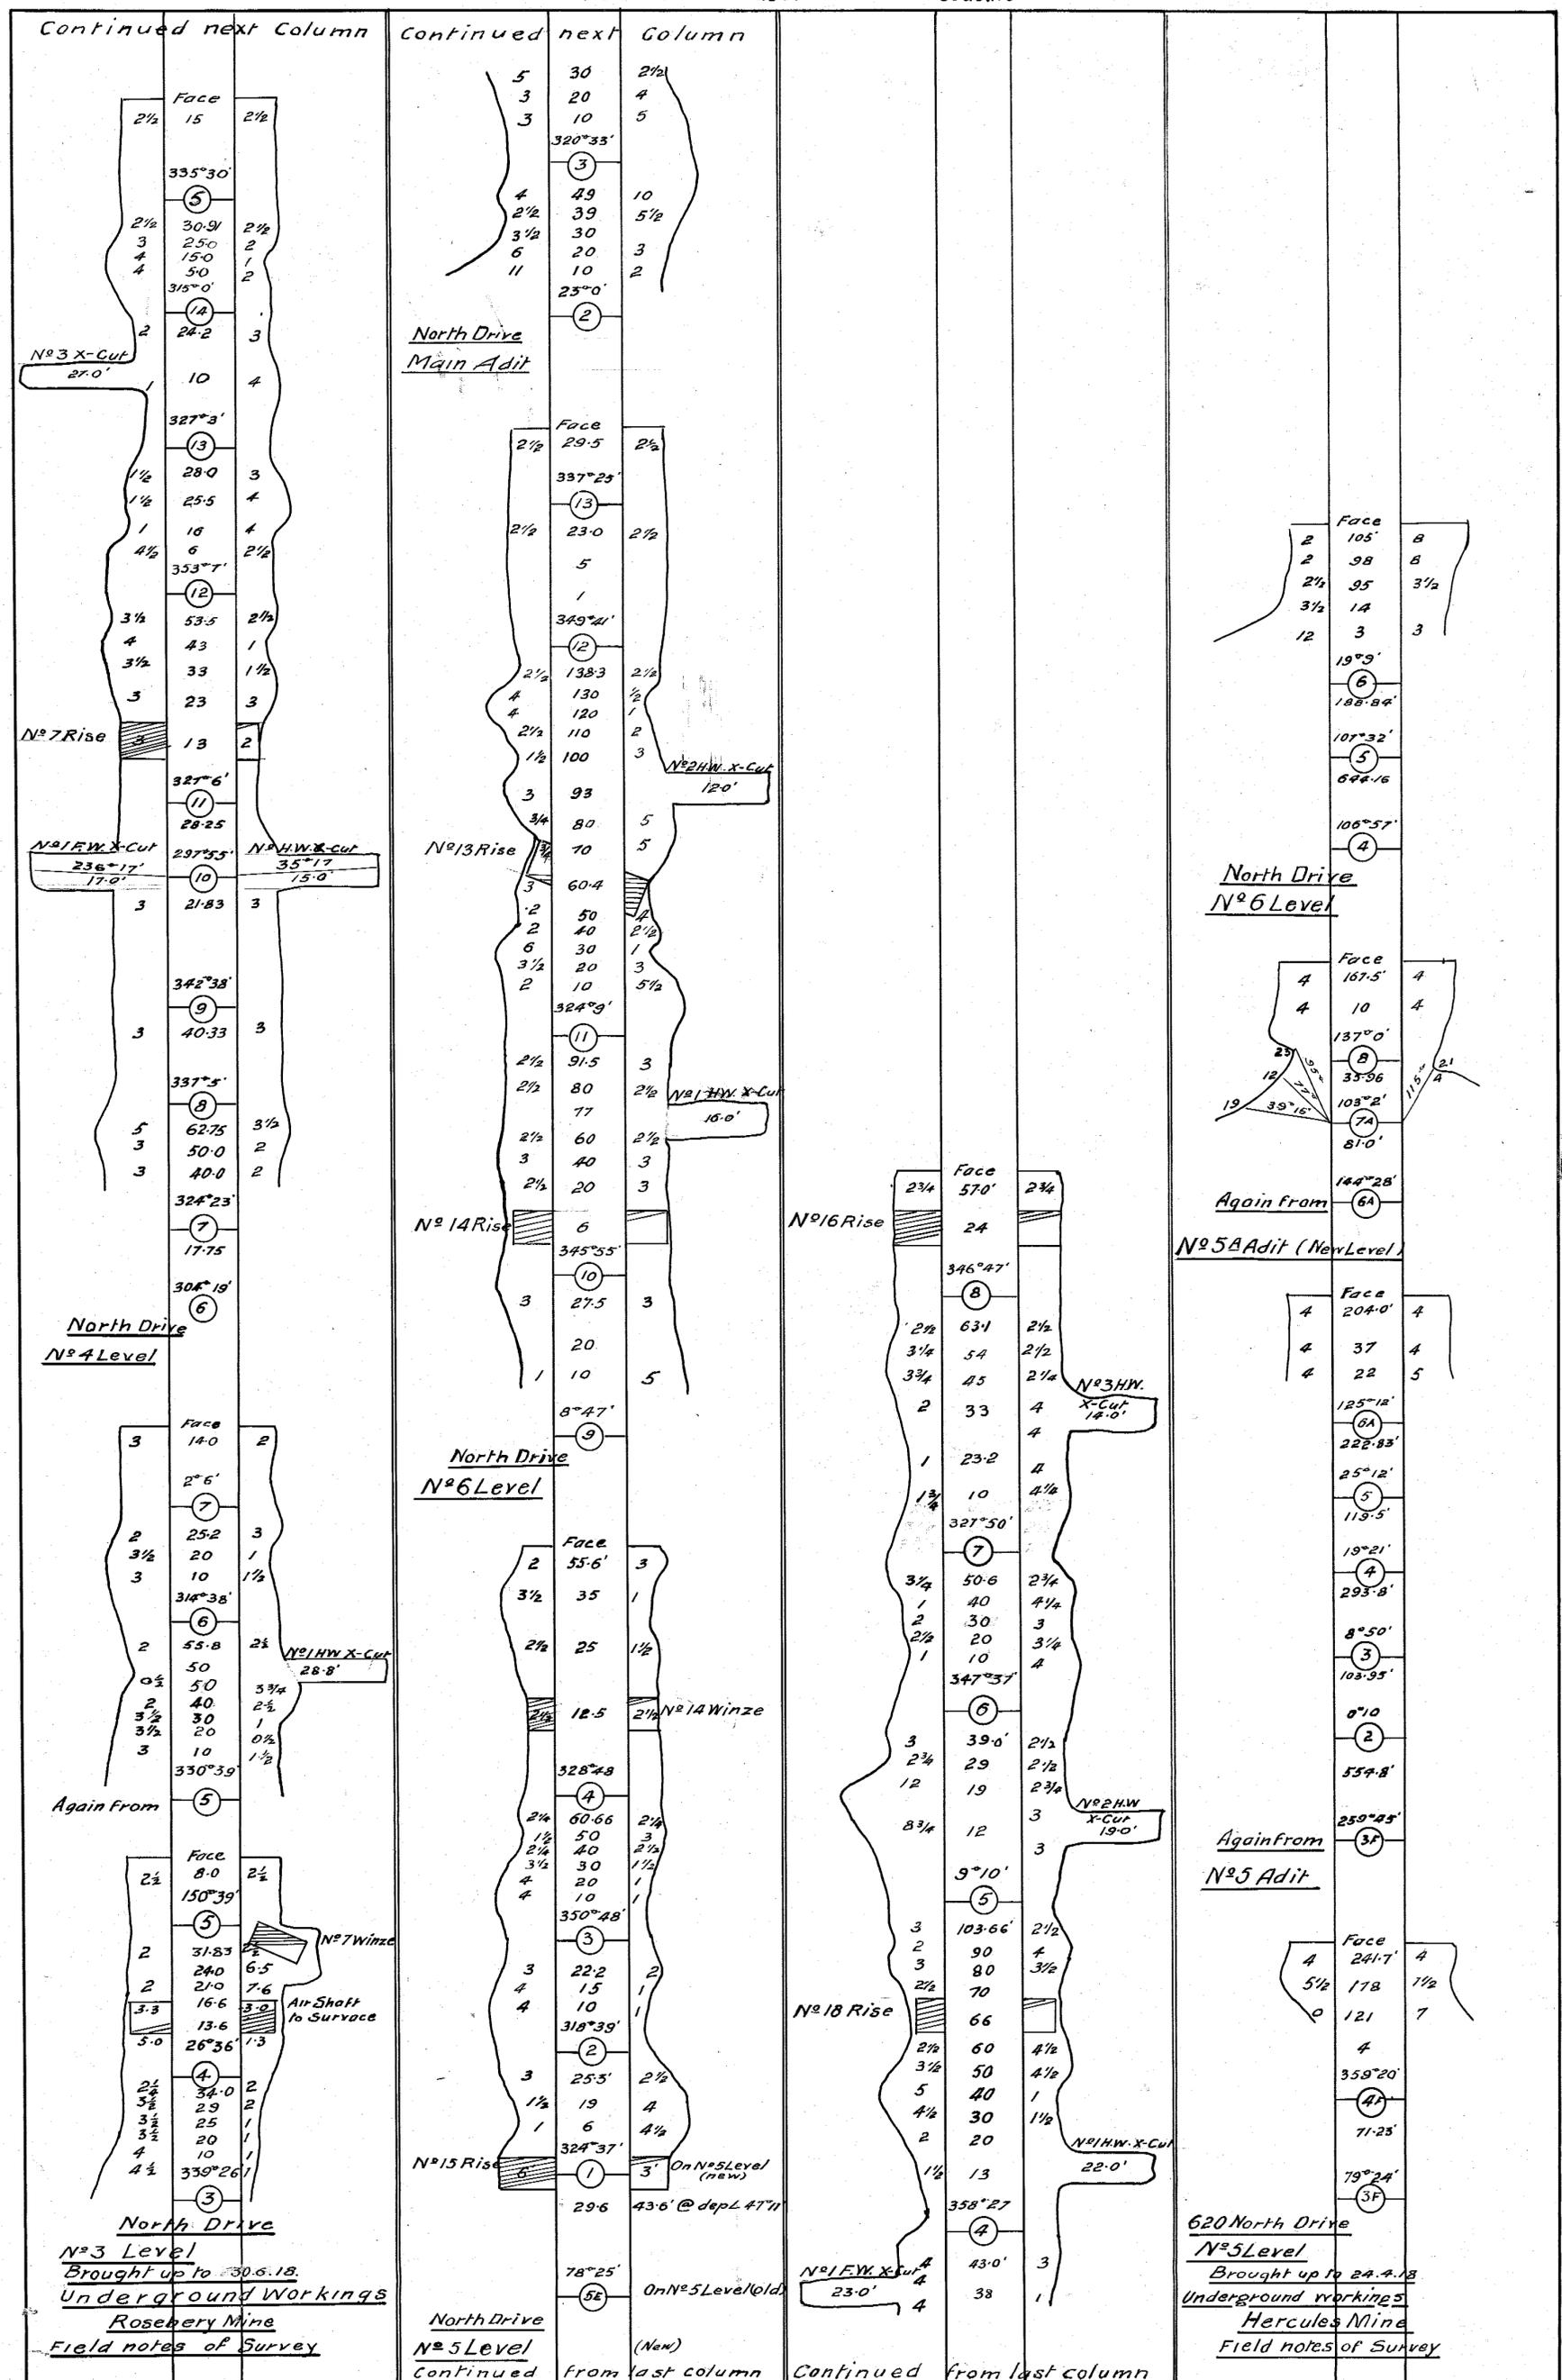

North Drive
No 3 Level
Brought up to 30.6.18.
Underground Workings
Rosebery Mine
Field notes of Survey

North Drive
No 5 Level
Continued from last column

Continued from last column

620 North Drive
No 5 Level
Brought up to 24.4.18
Underground workings
Hercules Mine
Field notes of Survey