


0055-096

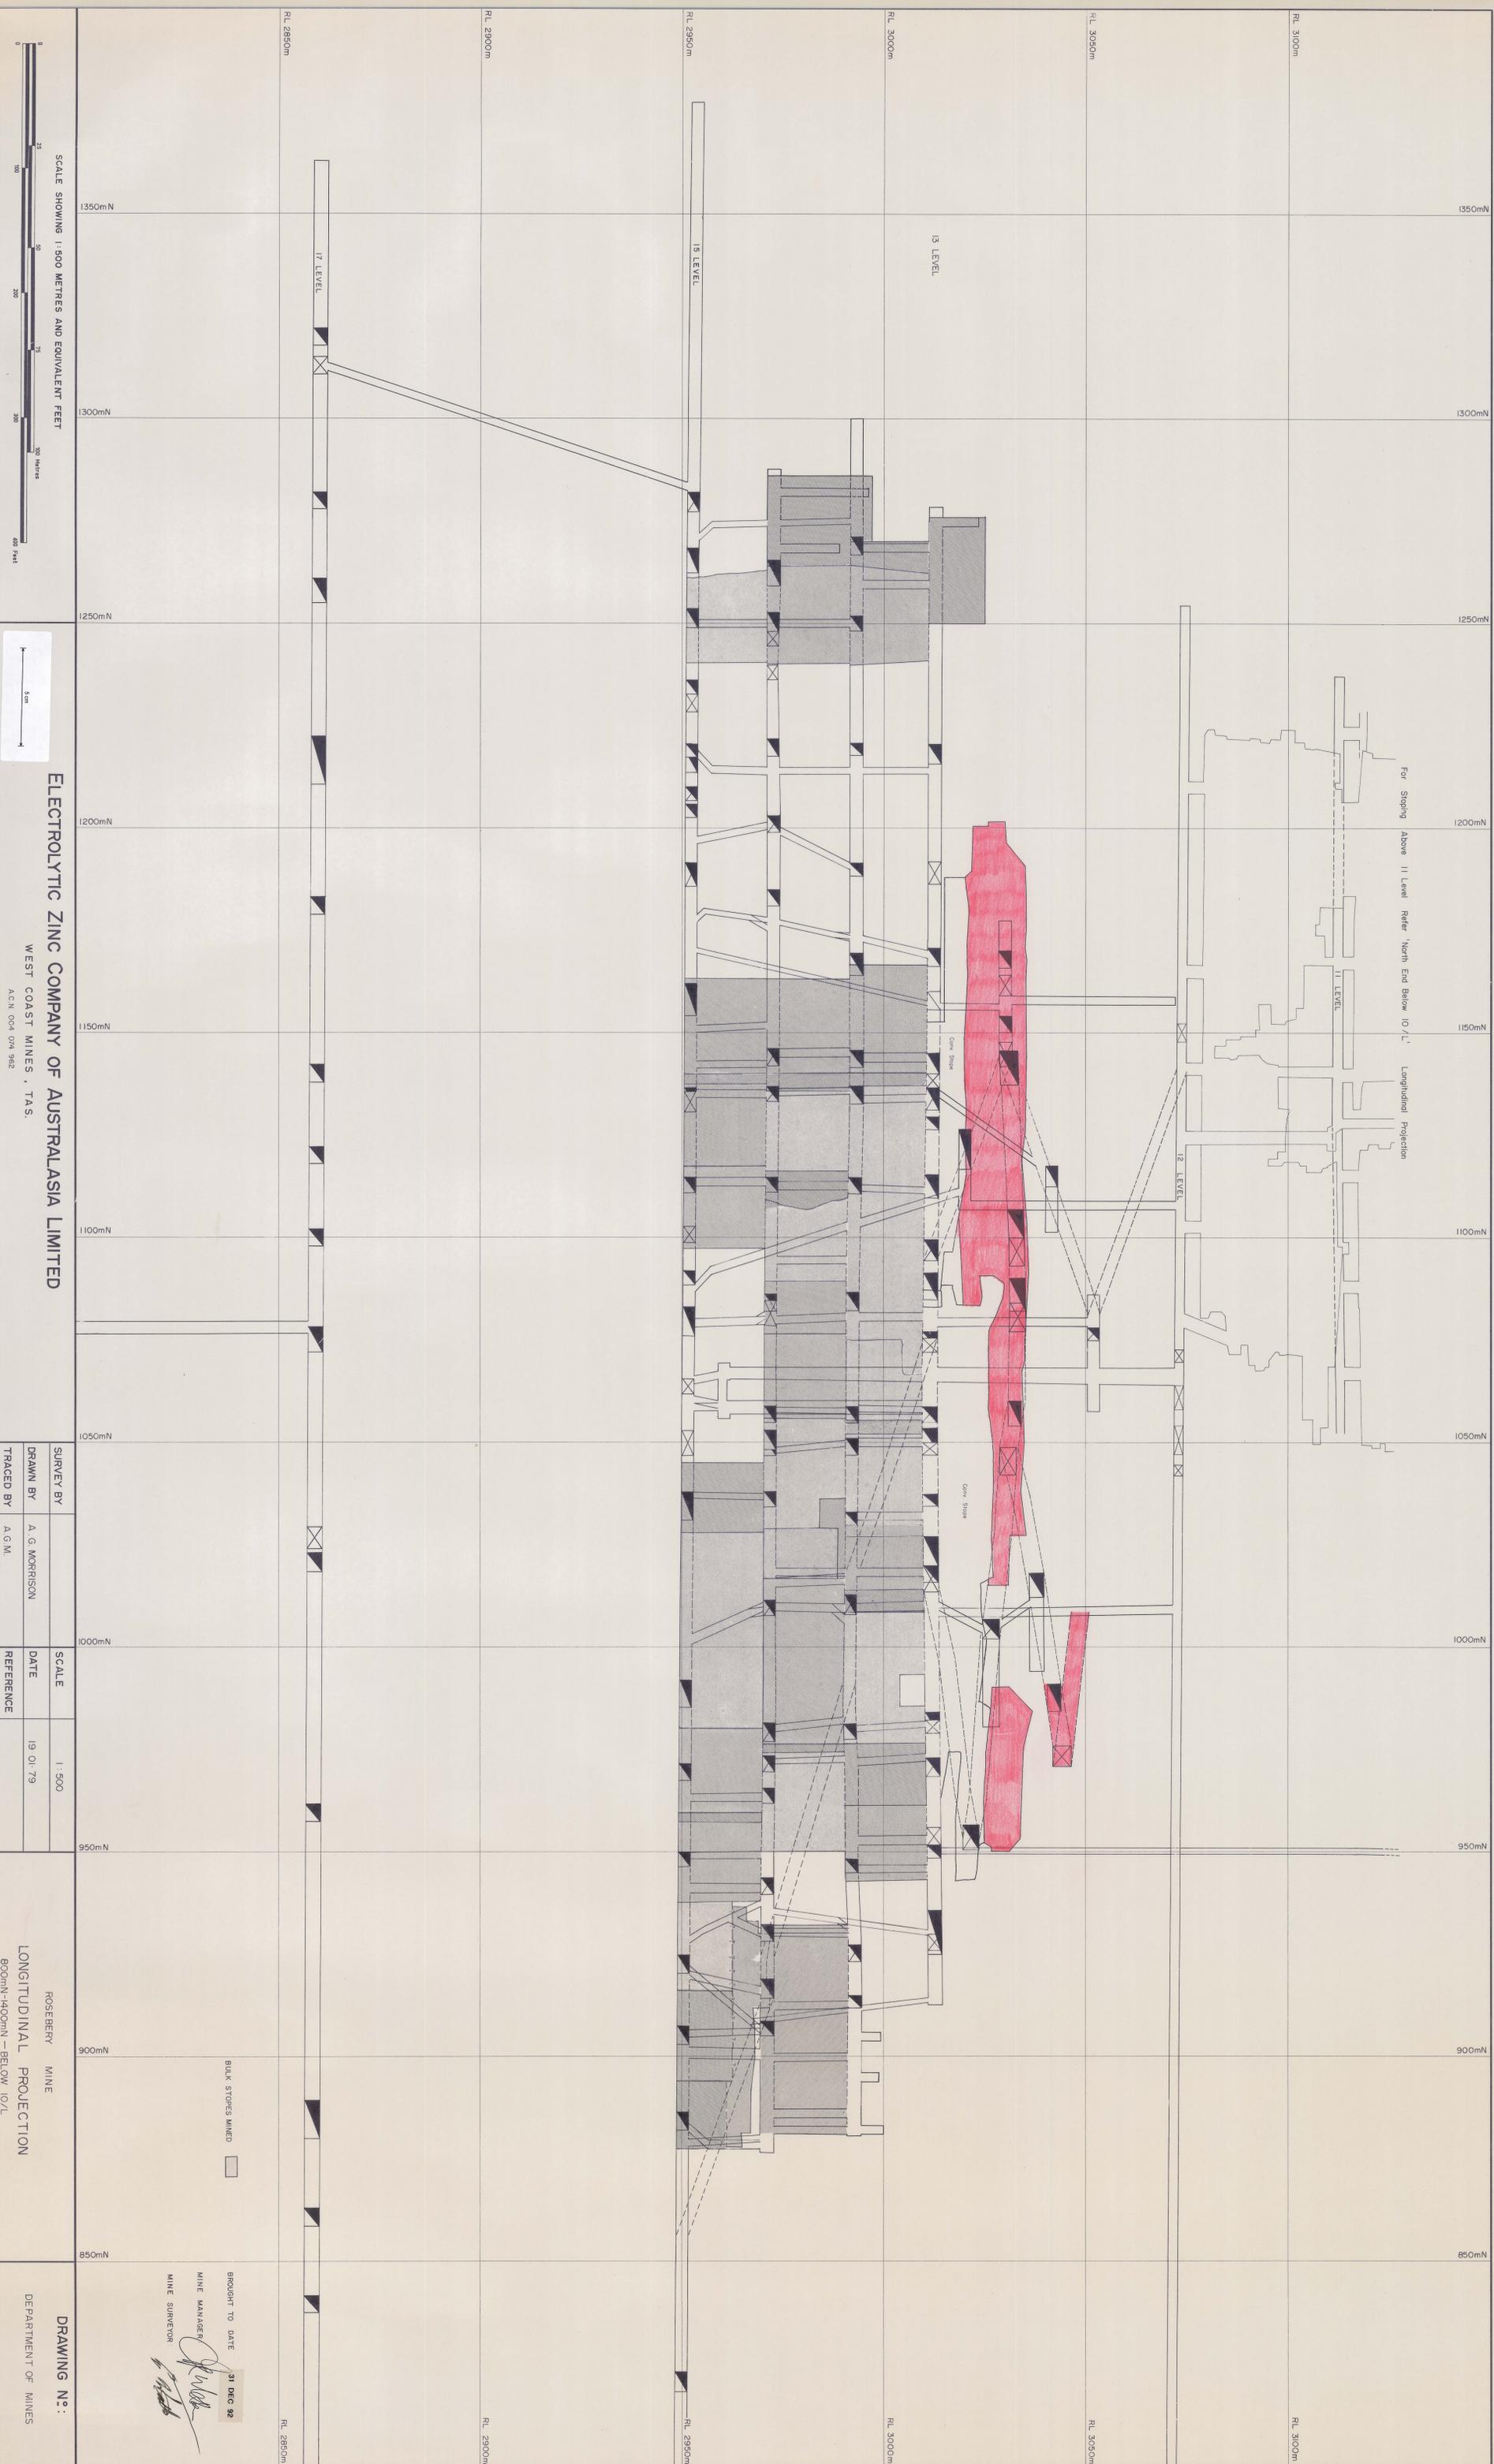

ELECTROLYTIC ZINC COMPANY OF AUSTRALASIA LIMITED

WEST COAST MINES, TAS.
A.C.N. 004 074 982

SURVEY BY	
DRAWN BY	A. G. MORRISON
TRACED BY	A. G. M.

SCALE	1:500
DATE	19.01.79
REFERENCE	

ROSEBERY MINE
LONGITUDINAL PROJECTION
800mN-1400mN - BELOW 10/L

DRAWING No. :
DEPARTMENT OF MINES

BROUGHT TO DATE 21 DEC 82
MINE MANAGER
MINE SUPERVISOR