

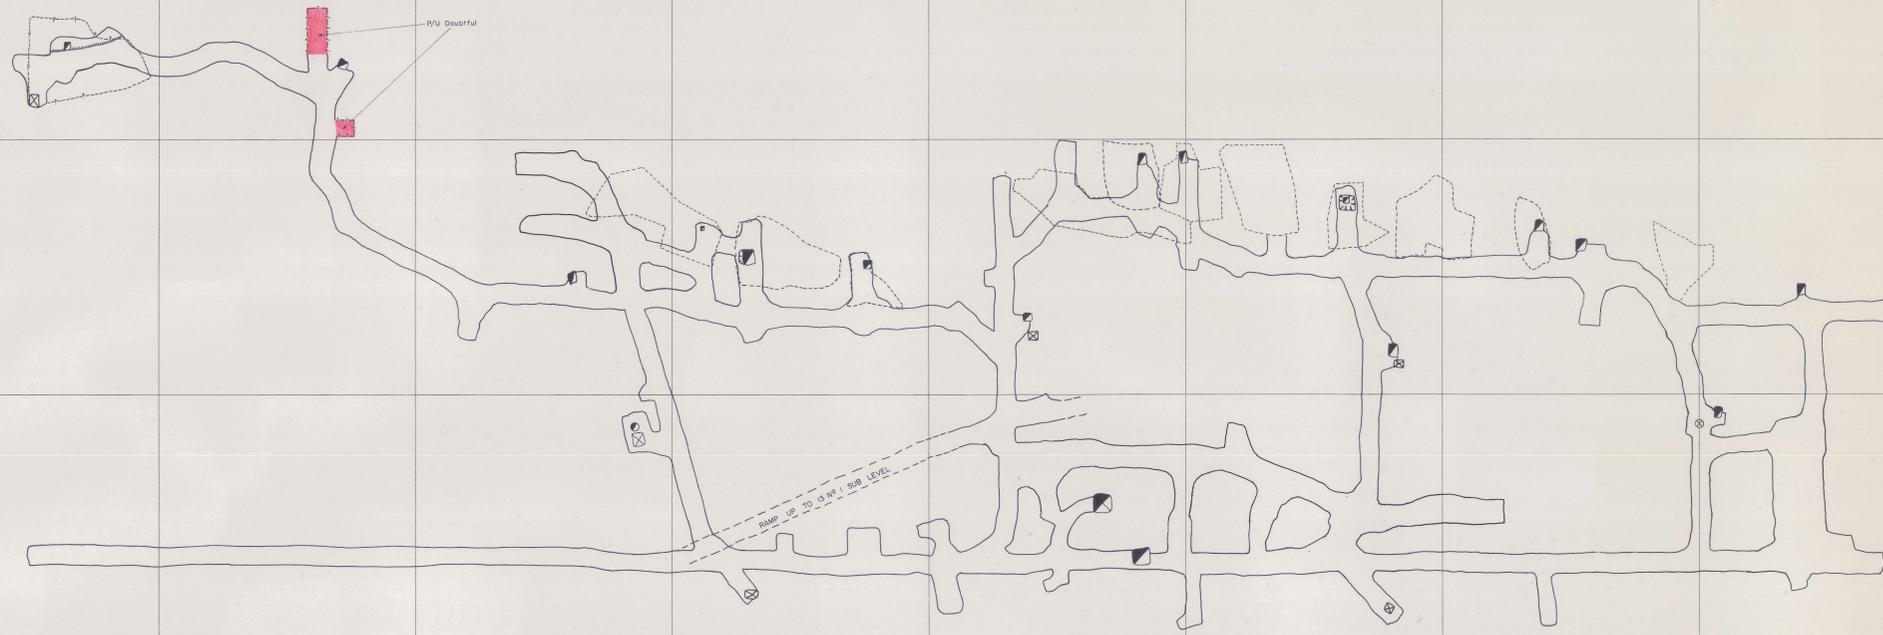


0055-097

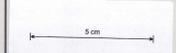

BROUGHT TO DATE 31 DEC 92
 MINE MANAGER: *[Signature]*
 MINE SURVEYOR: *[Signature]*

SCALE SHOWING 1:500 METRES AND EQUIVALENT FEET

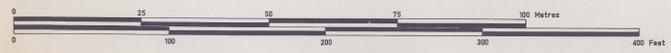

ELECTROLYTIC ZINC COMPANY OF AUSTRALASIA LIMITED

WEST COAST MINES, T.A.S.
 A.C.N. 004 074 962

SURVEY BY		SCALE	1:500
DRAWN BY	P. J. S.	DATE	11-10-82
TRACED BY	G. M. B.	REFERENCE	

ROSEBERY MINE
 No. 13 LEVEL (3)

DRAWING NO: 3 1 2

