
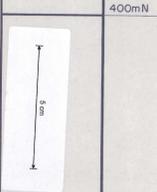
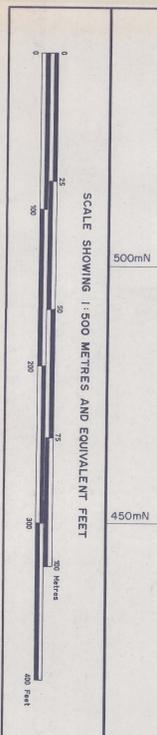


0055-108

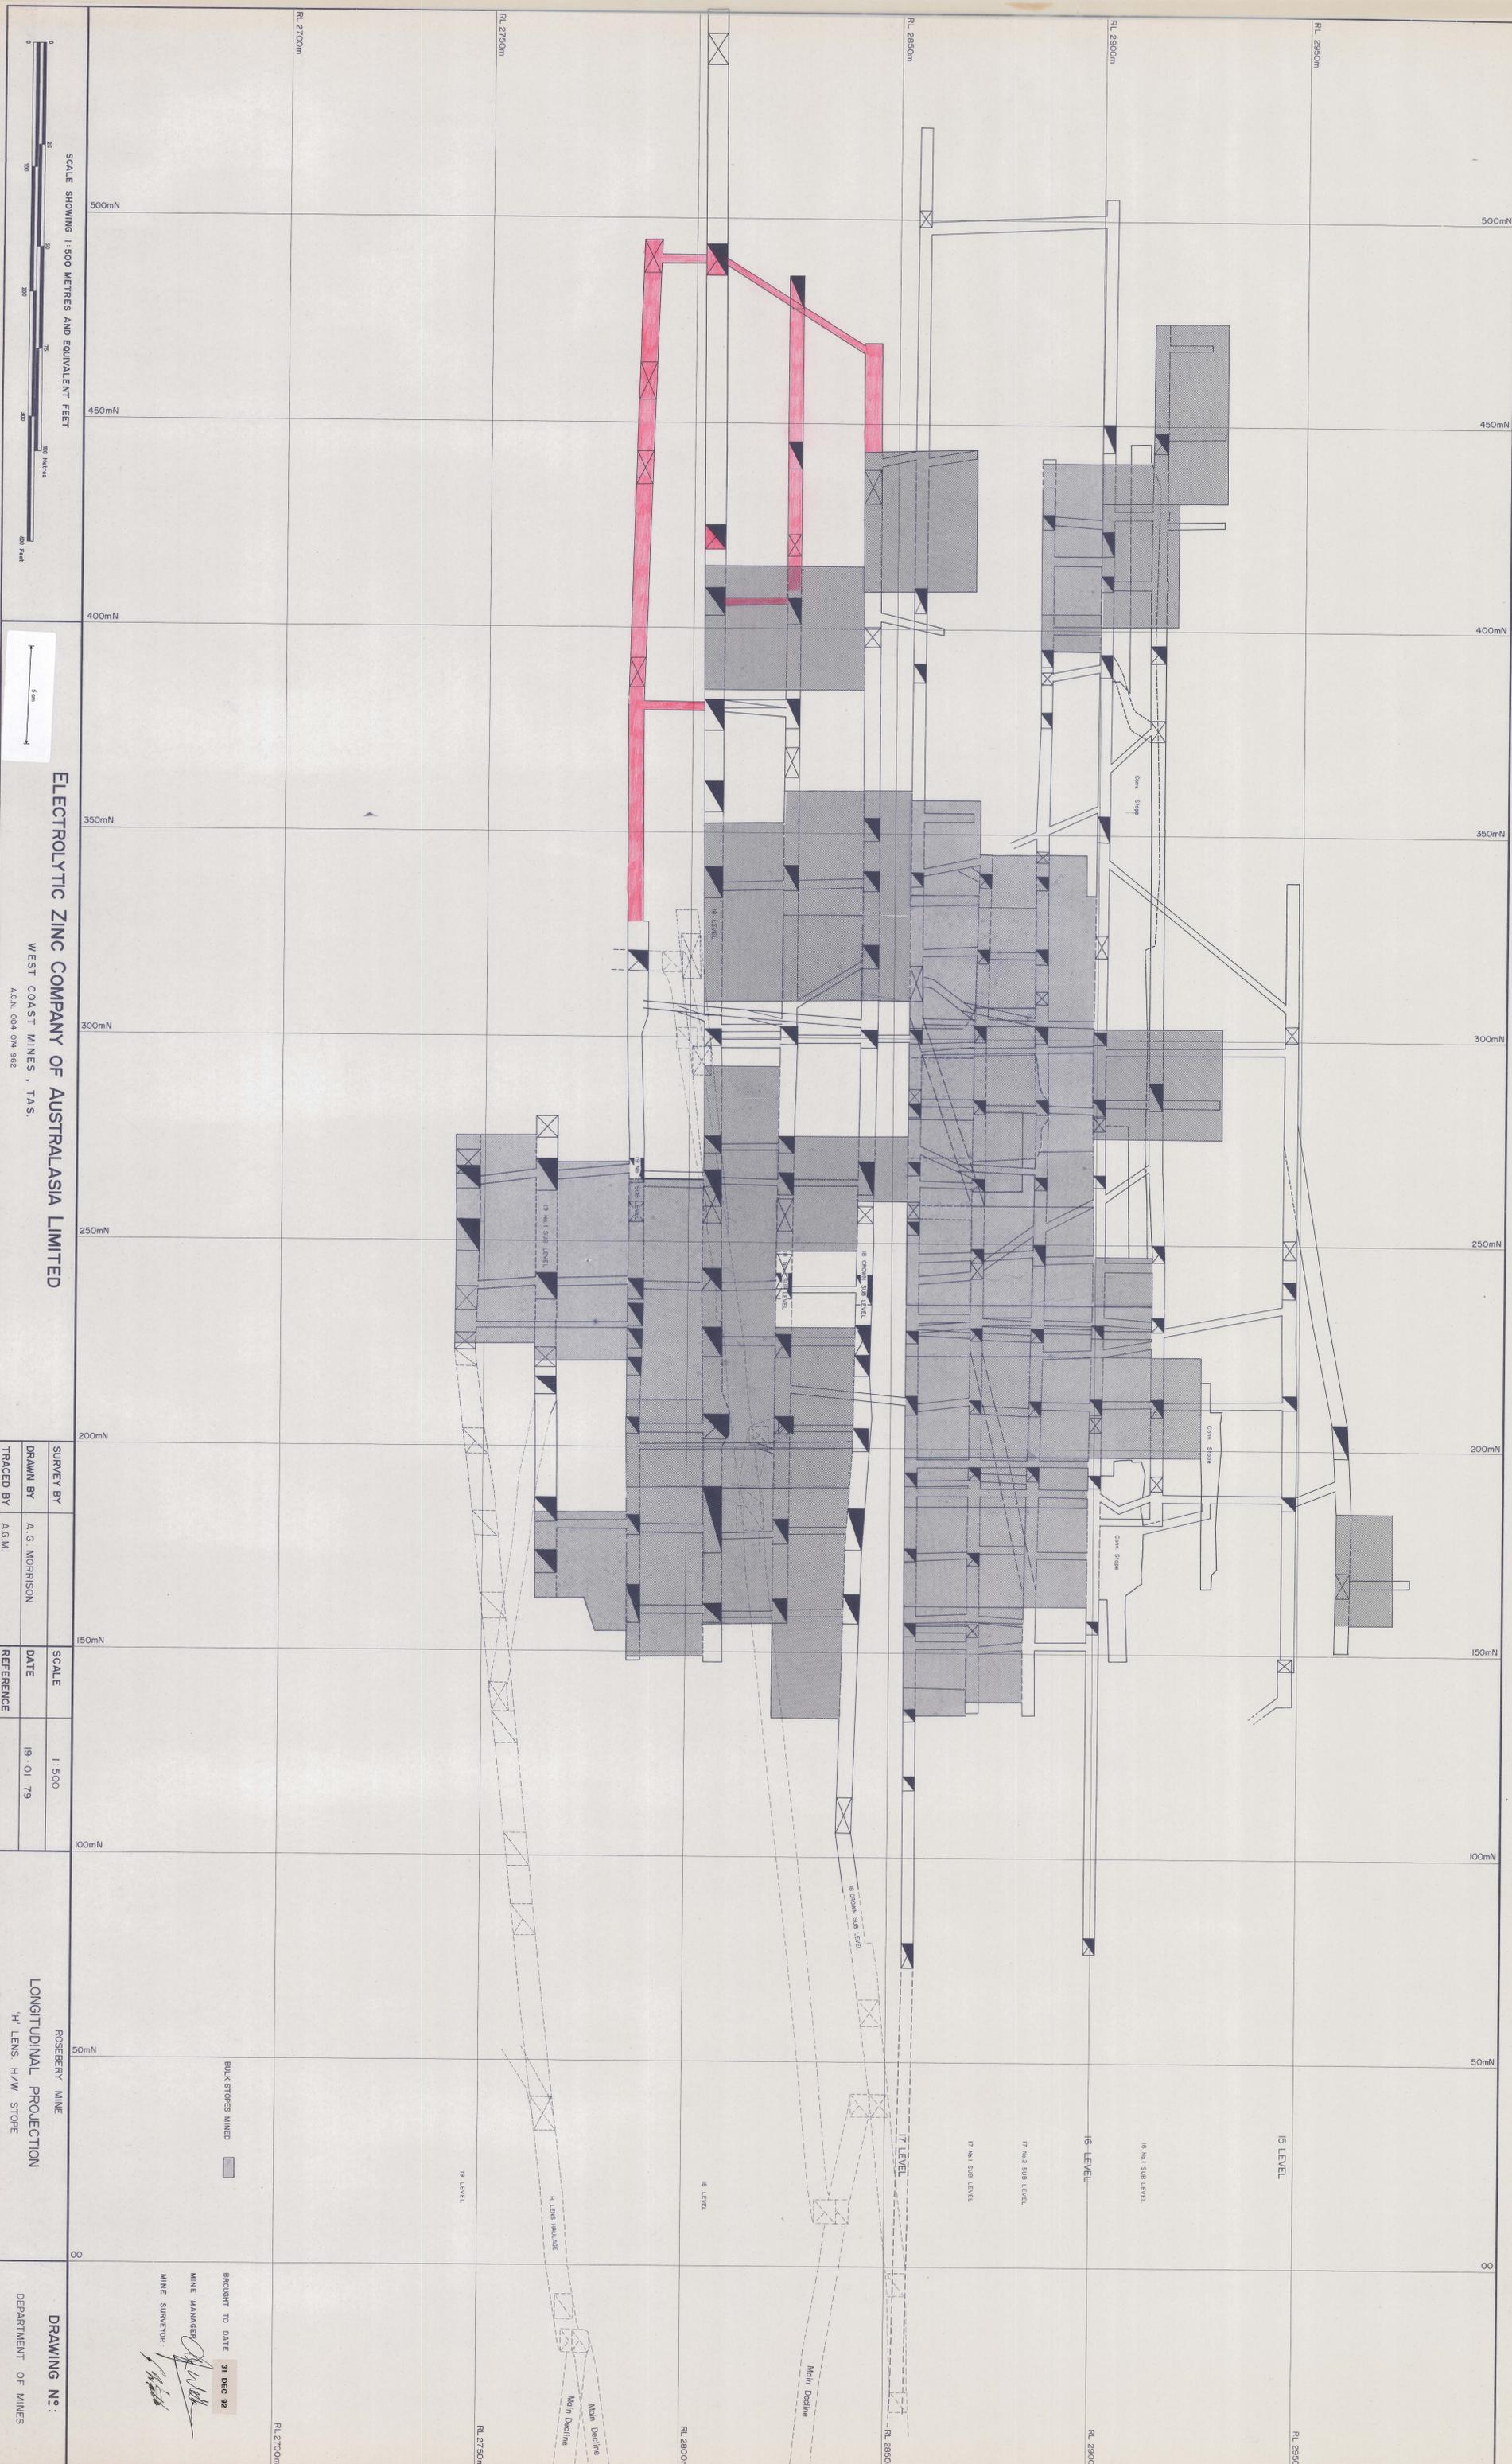

ELECTROLYTIC ZINC COMPANY OF AUSTRALASIA LIMITED

WEST COAST MINES, TAS.

A.C.N. 004 074 982

SURVEY BY	SCALE
DRAWN BY	DATE
TRACED BY	REFERENCE
A.G. MORRISON	1:500
A.G.M.	19.01.79

ROSEBERY MINE

LONGITUDINAL PROJECTION

H' LENS H/W SLOPE

50m S-550m N BELOW 15 LEVEL

DRAWING No.:

DEPARTMENT OF MINES

BROUGHT TO DATE 31 DEC 92

MINING MANAGER

MINING SUPERVISOR

RL 2700m

RL 2750m

RL 2800m

RL 2850m

RL 2900m

RL 2950m