


0055 - 111

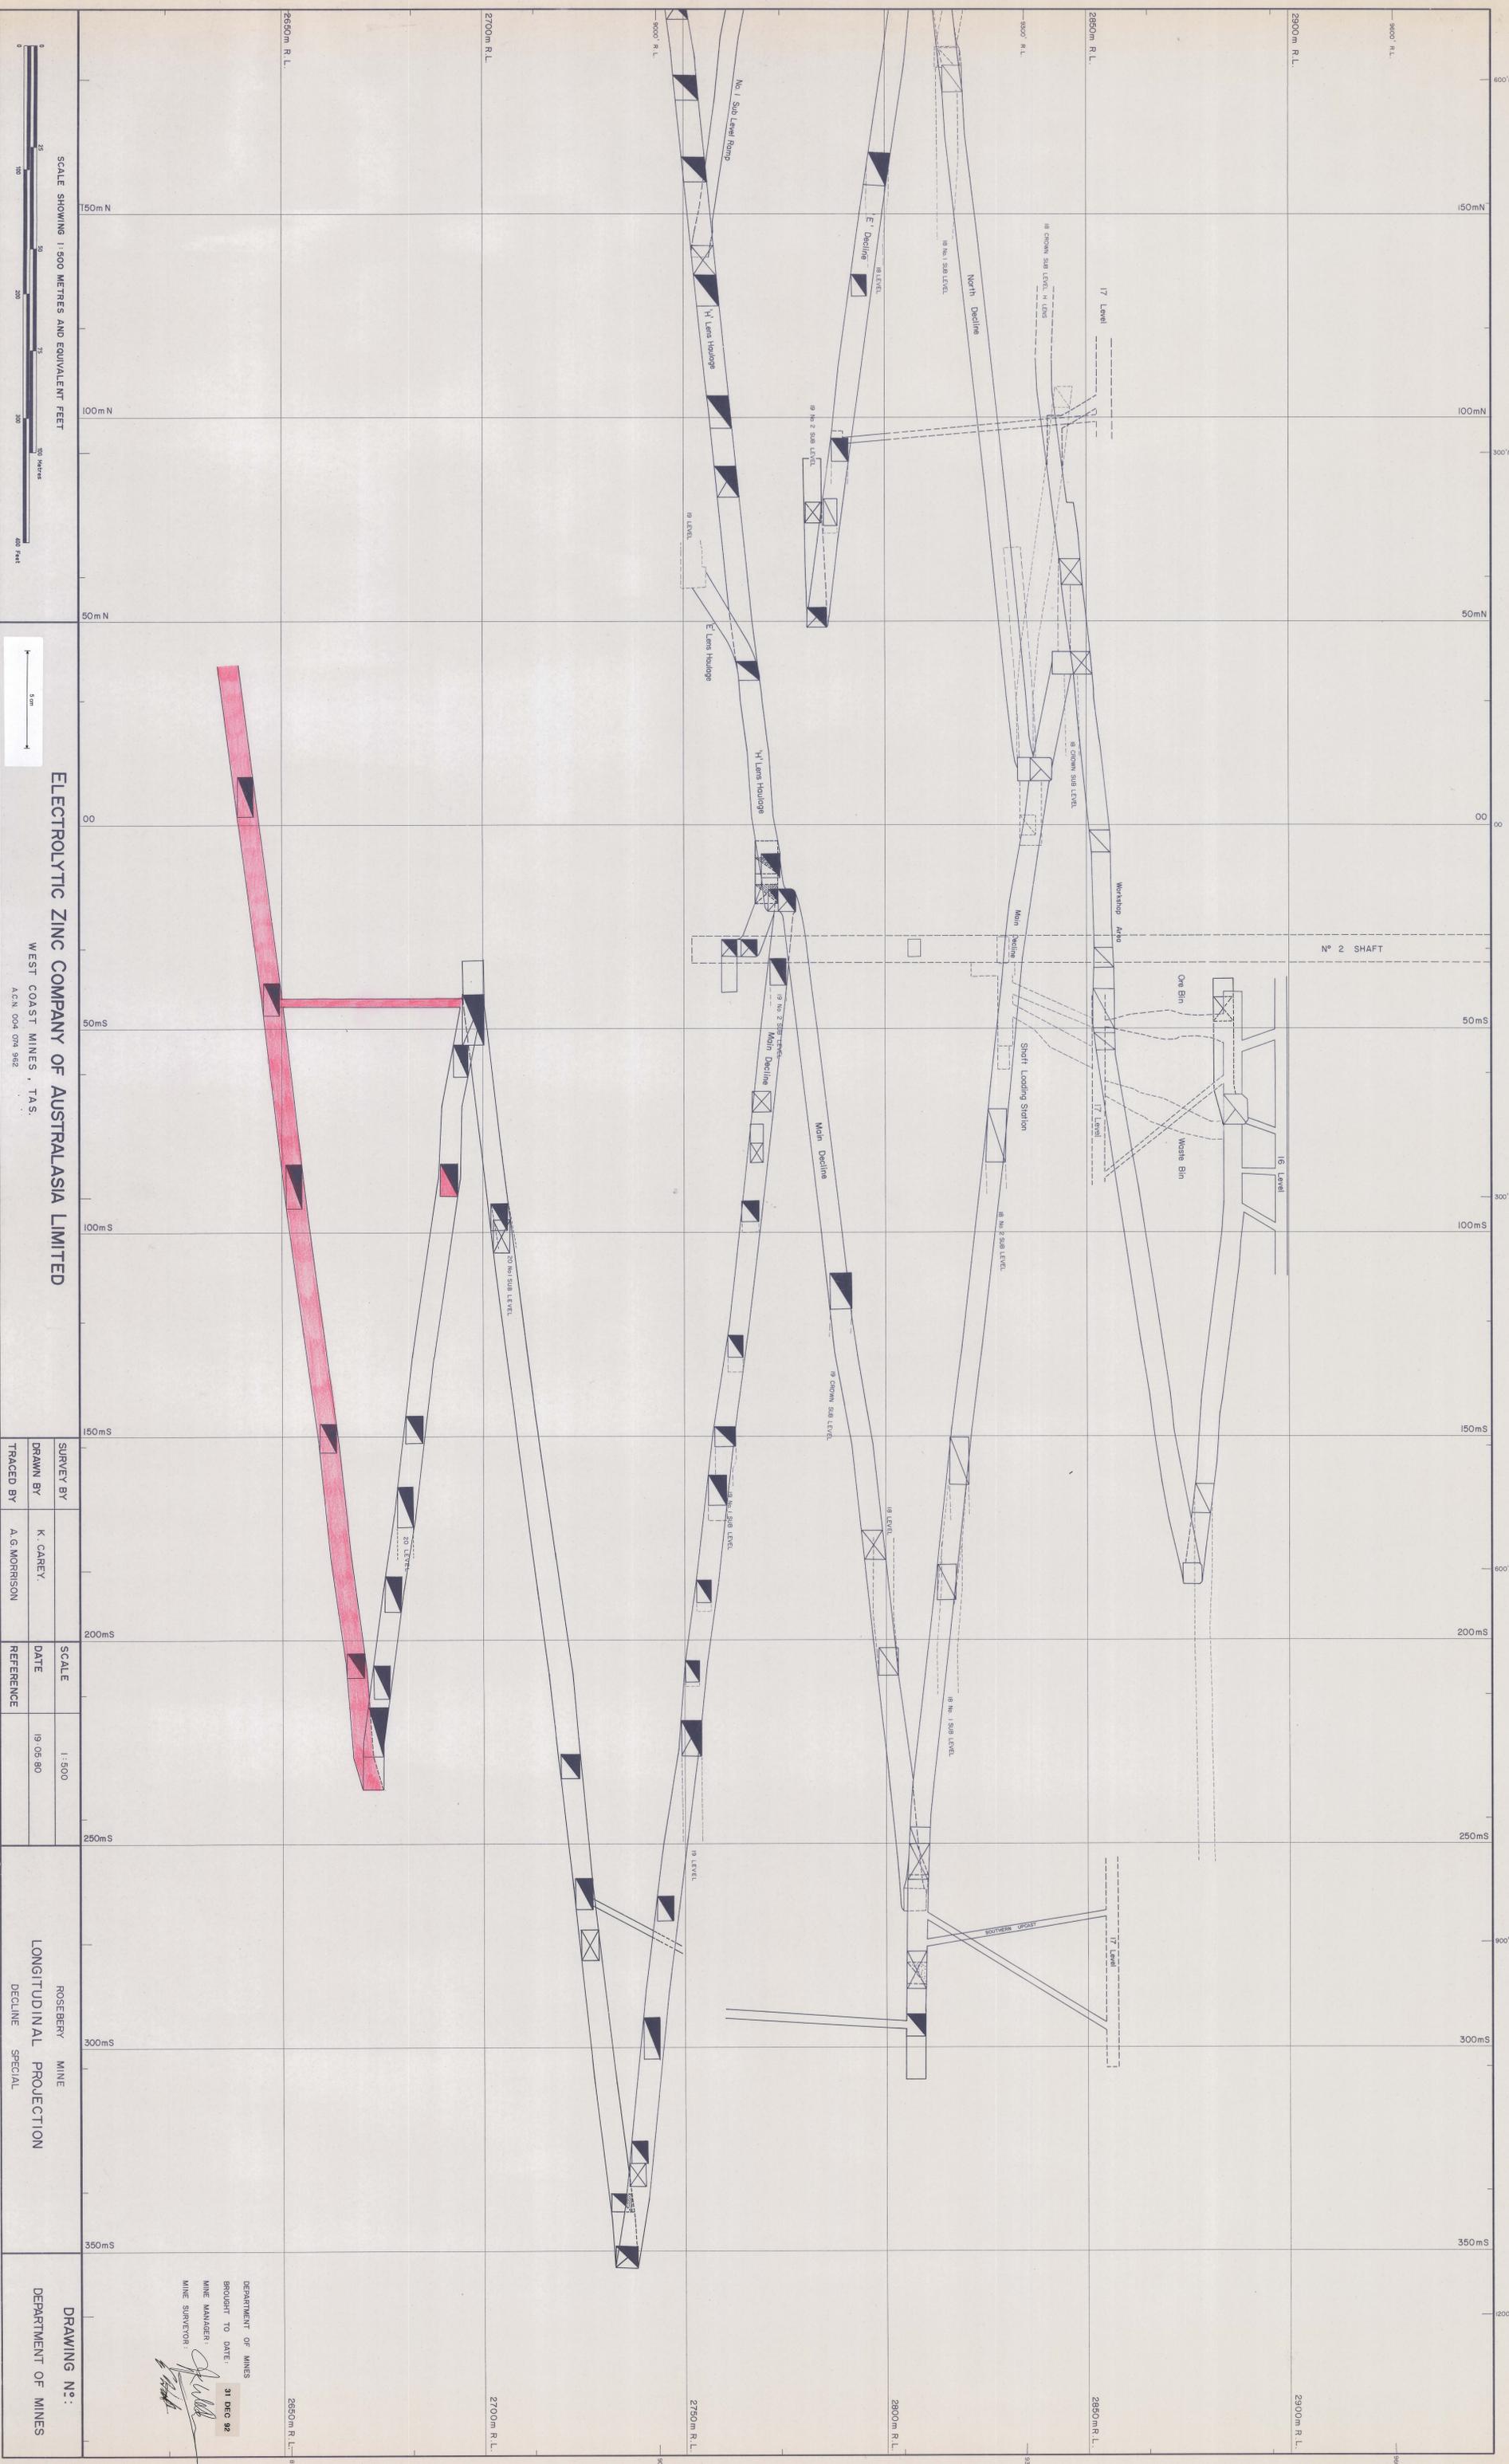

ELECTROLYTIC ZINC COMPANY OF AUSTRALASIA LIMITED
 WEST COAST MINES, TAS.
 A.C.N. 004 074 982

SURVEY BY	K. CAREY.
DRAWN BY	A.G. MORRISON
TRACED BY	

SCALE	1:500
DATE	19.02.80
REFERENCE	

ROSEBERY MINE
 LONGITUDINAL PROJECTION
 DECLINE SPECIAL

DRAWING NO.:
 DEPARTMENT OF MINES

DEPARTMENT OF MINES
 BROUGHT TO DATE: 31 DEC 92
 MINE MANAGER:
 MINE SUPERVISOR: