

0055-113

PASMINCO MINING - Rosebery


A.C.N. 004 074 962

	By	Date
Drawn		05-DEC-91
Traced		
Checked		
Approved		

ROSEBERY MINE

20 LEVEL

J LENS

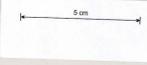

SCALE: 1:500

FILE:

DESIGN:

DRAWING No.

SURVEY:


Revisions	No	By	Date	Details			App	References		
				No	By	Date		No	By	Date

DEPARTMENT OF MINES

BOUGHT TO DATE: 31 DEC 92

MINE MANAGER: *[Signature]*

MINE SURVEYOR: *[Signature]*

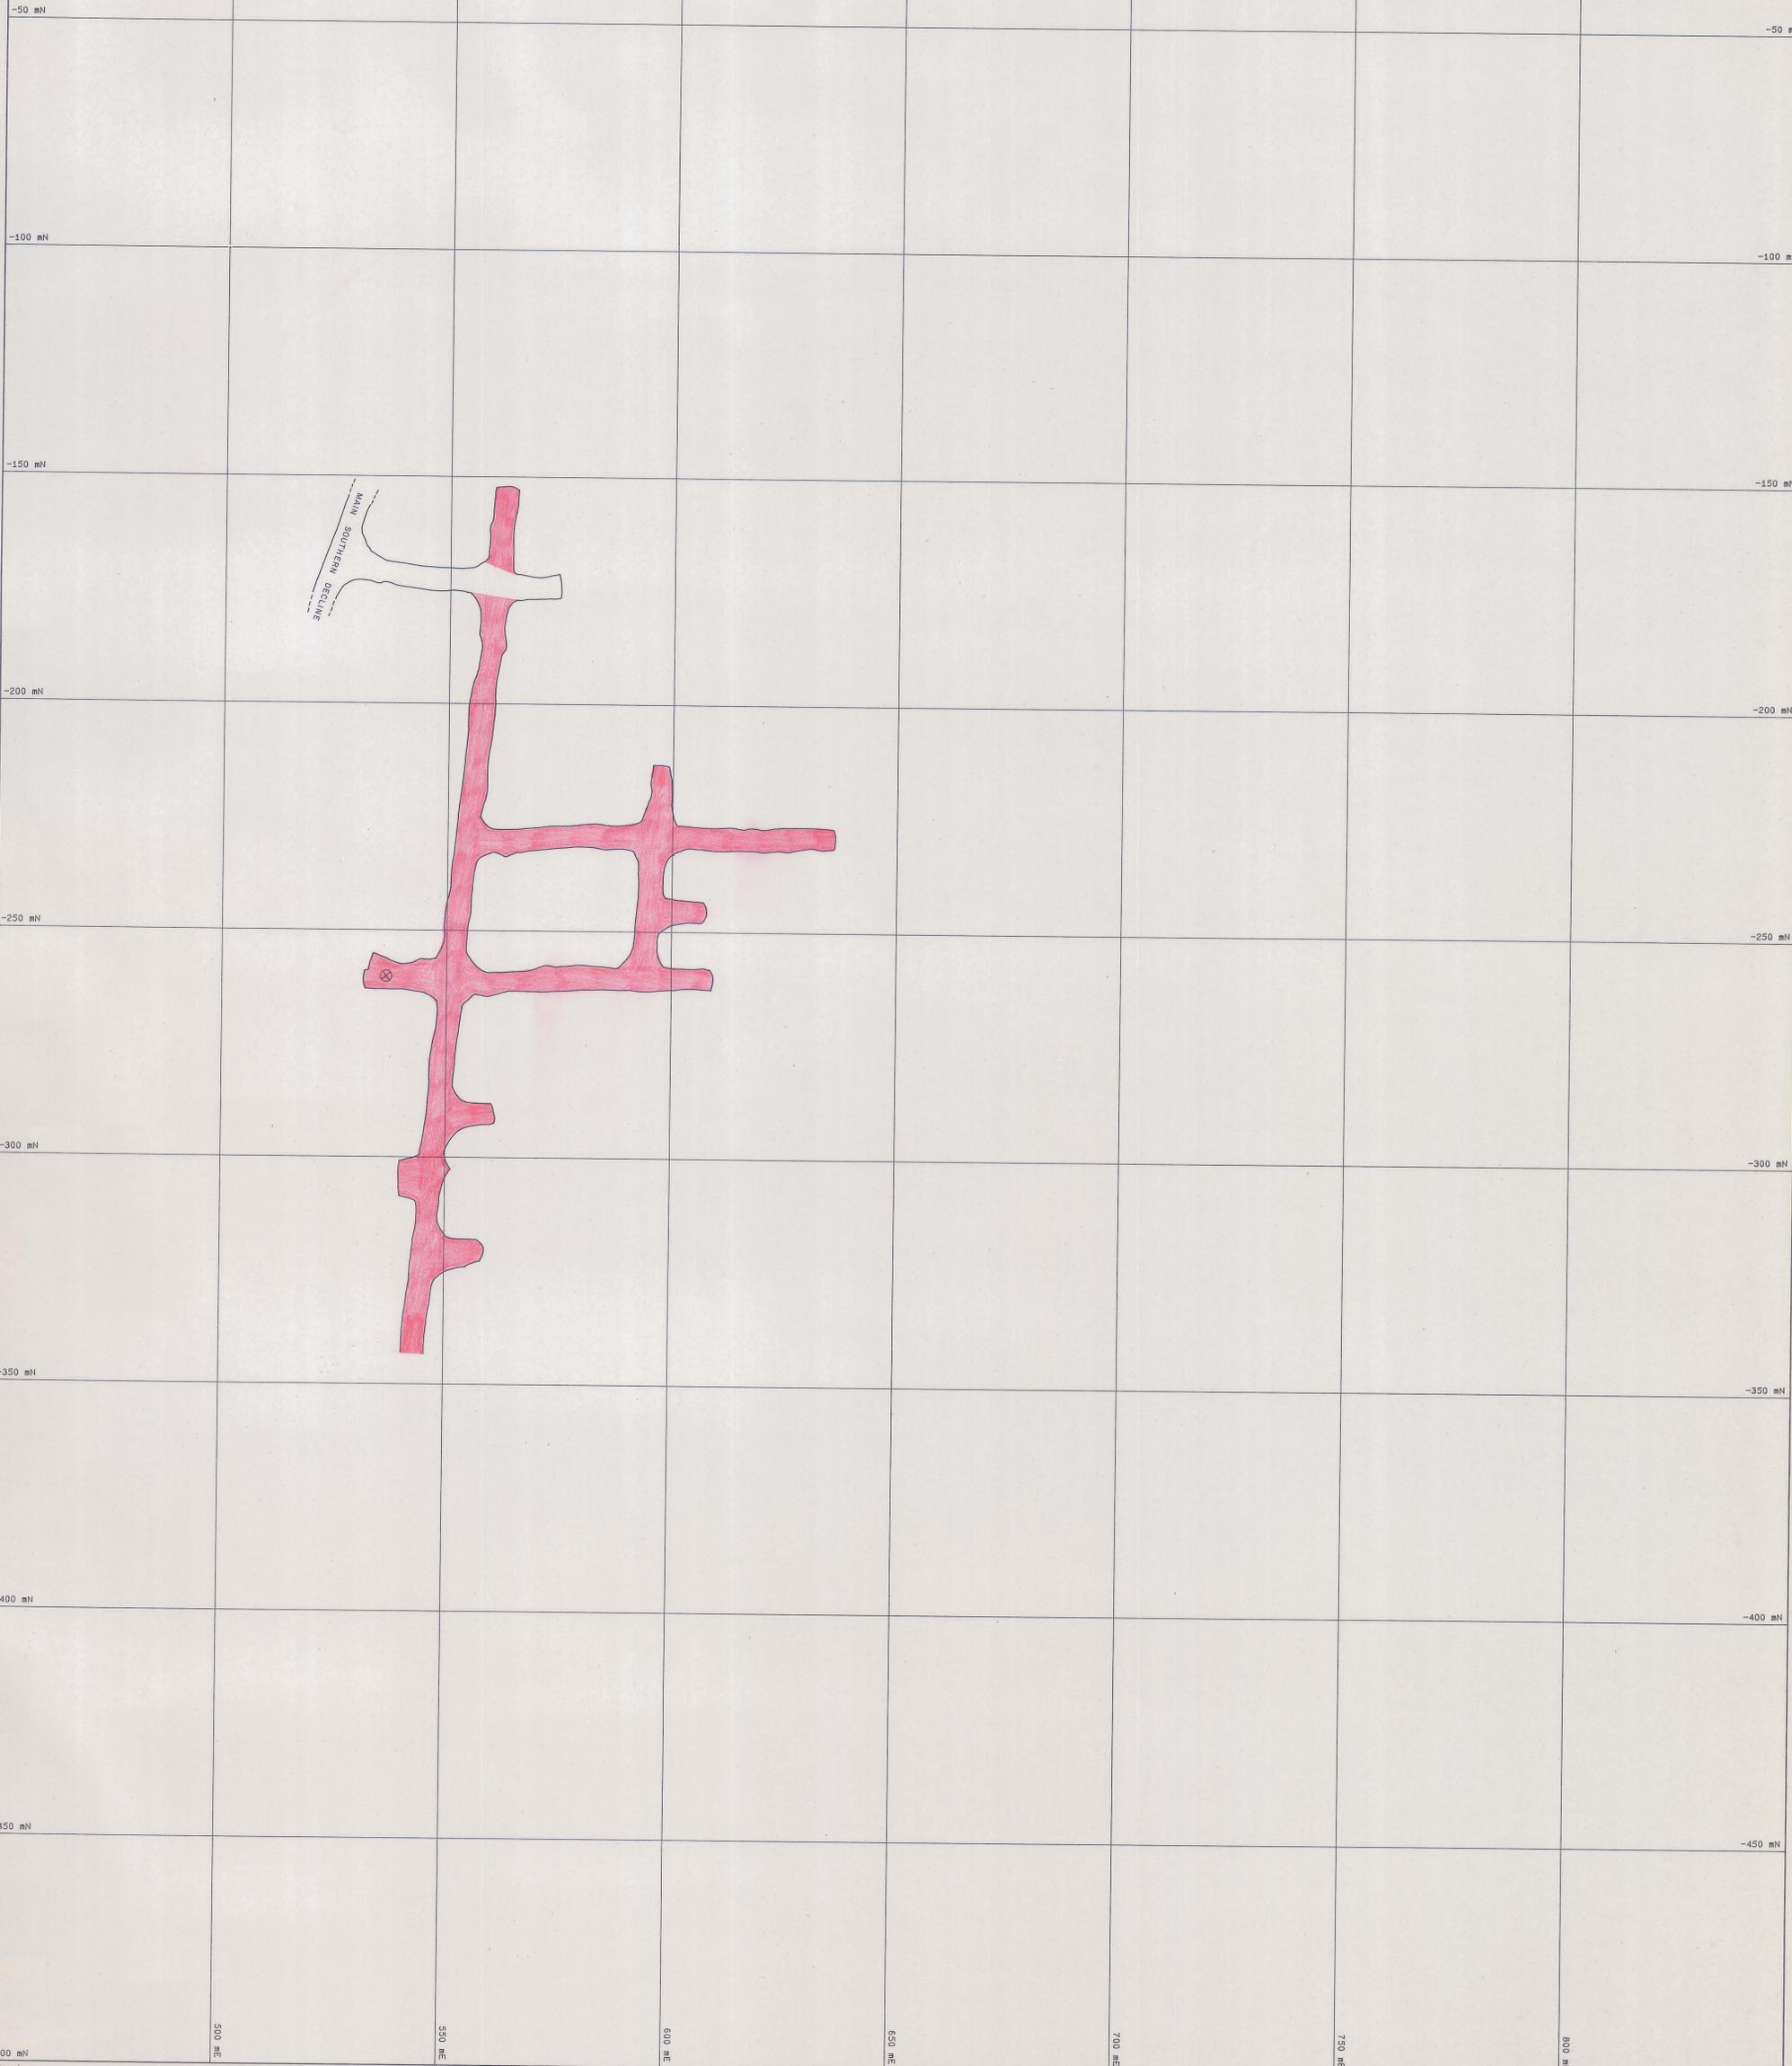

6097201F