



0055-118

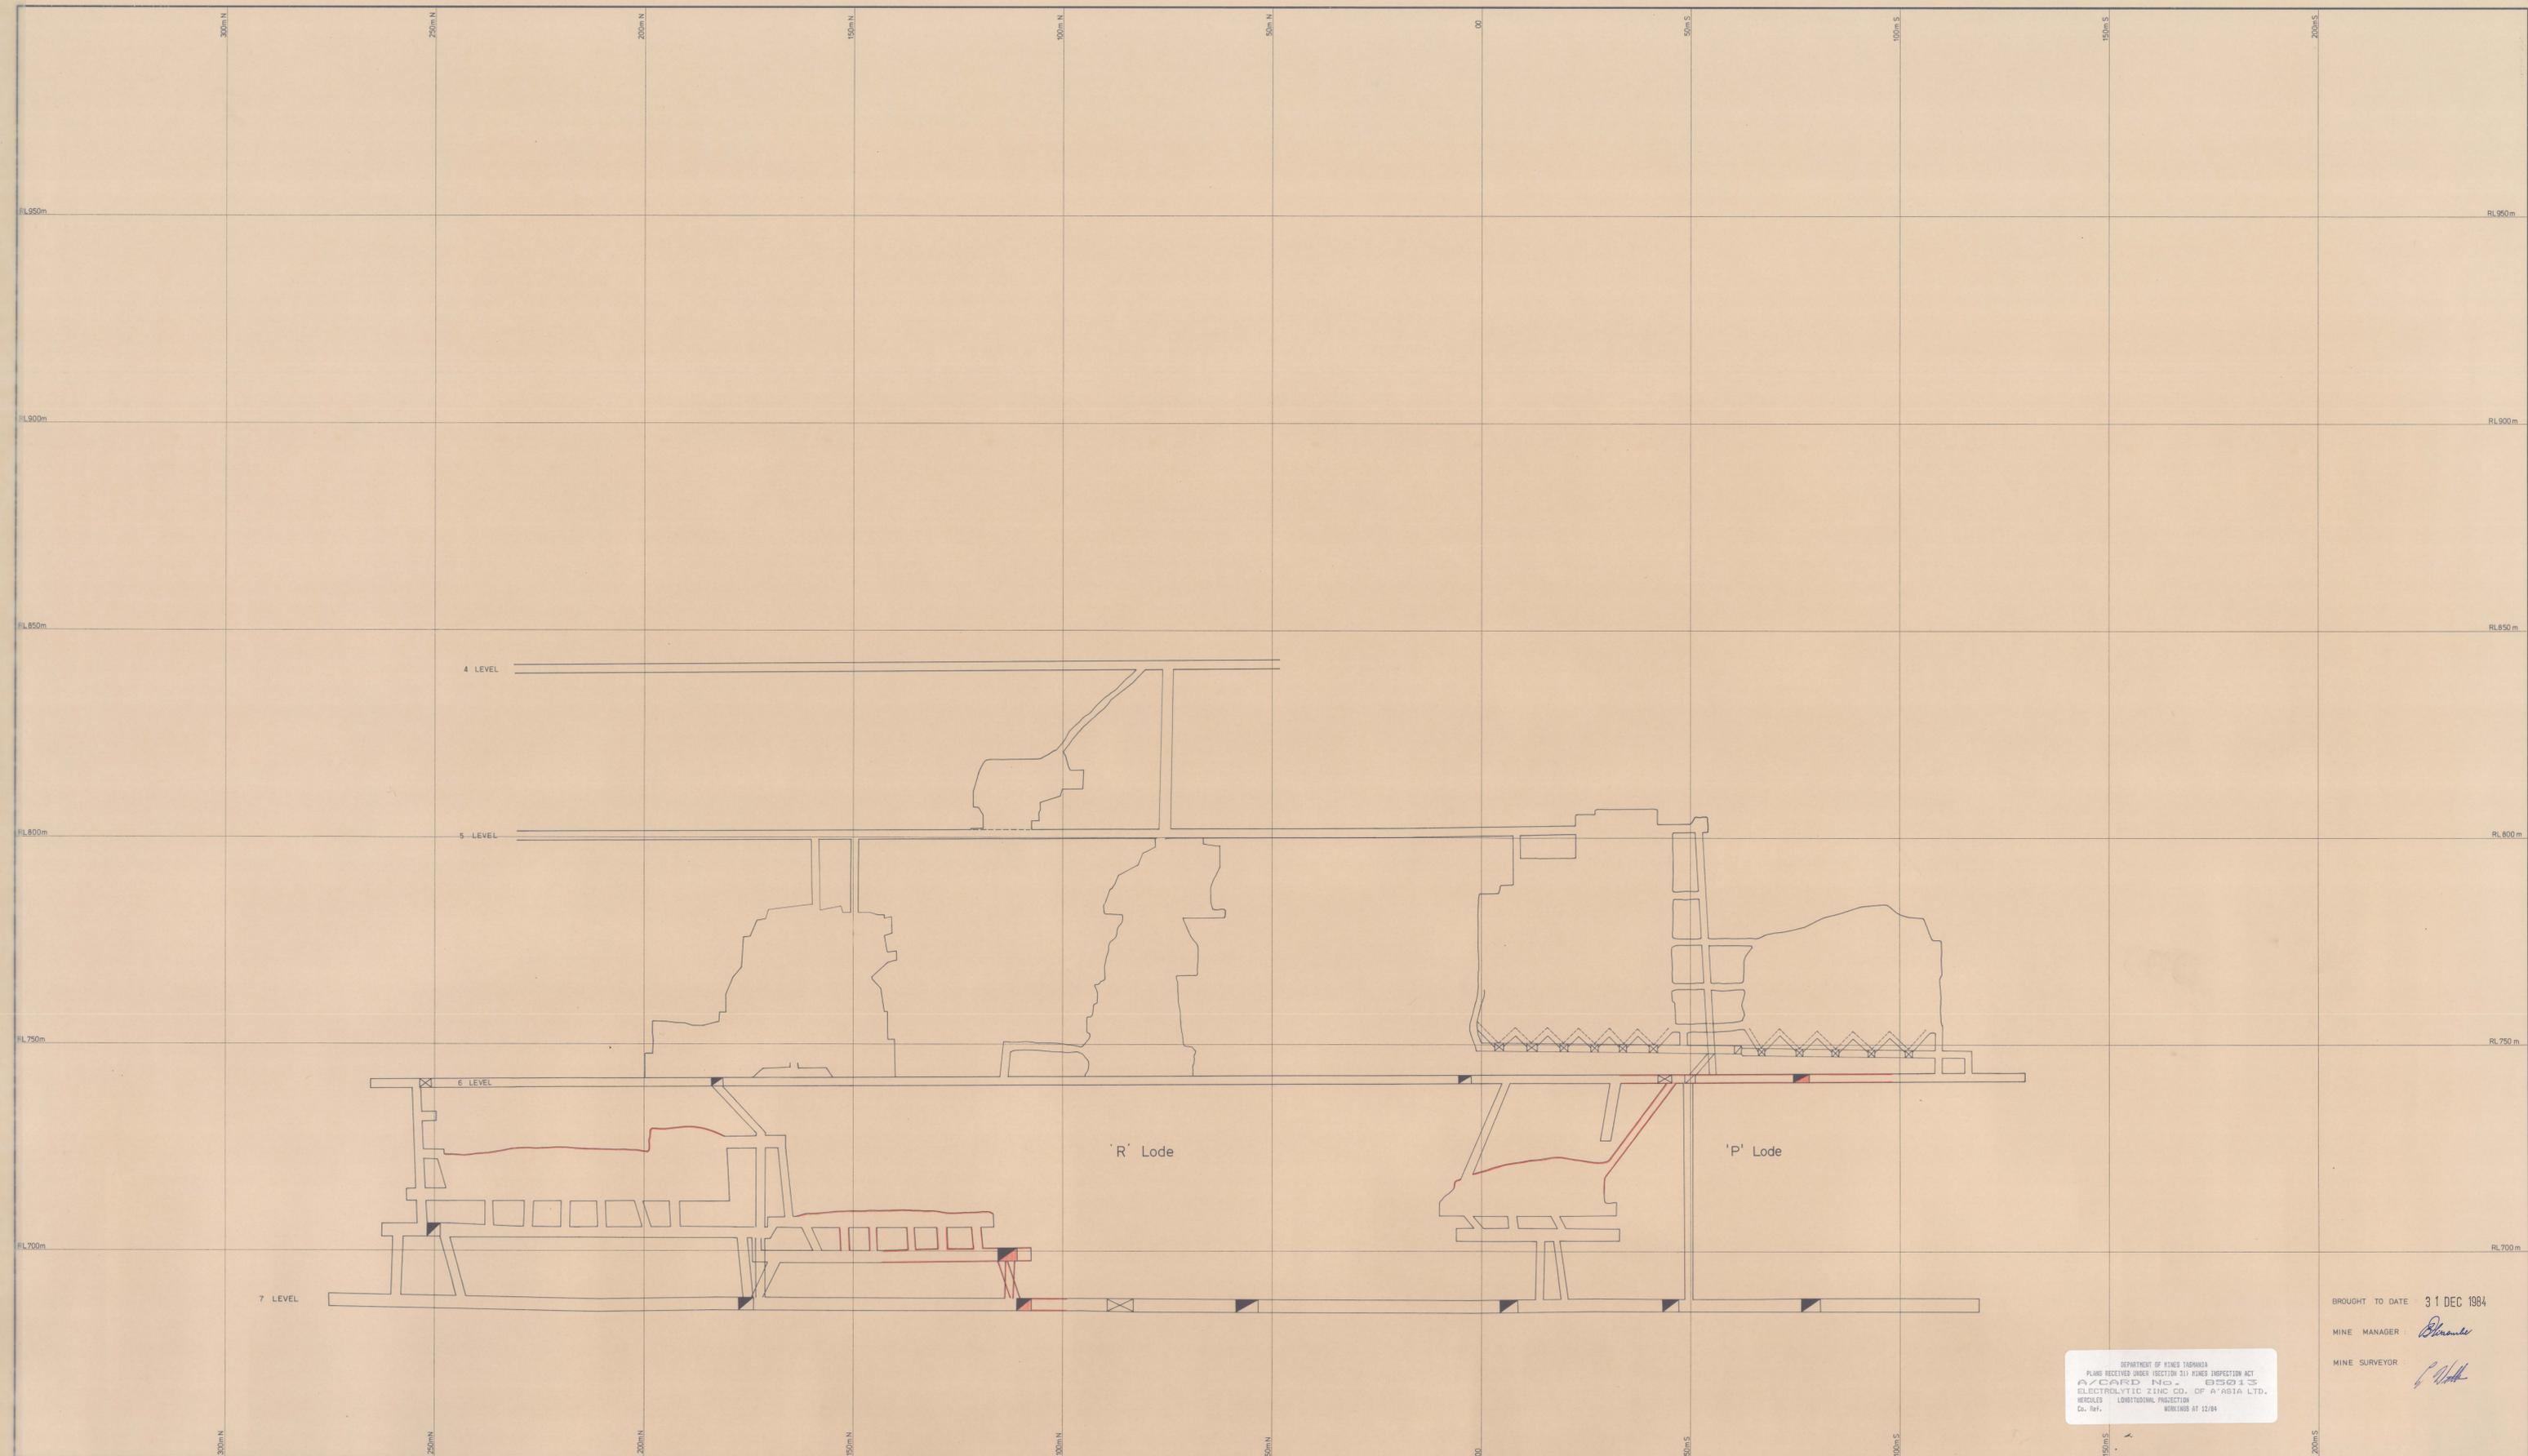

DEPARTMENT OF MINES TASMANIA
 PLANS RECEIVED UNDER (SECTION 31) MINES INSPECTION ACT
 APPROVED NO. 635233
 ELECTROLYTIC ZINC CO. OF AUSTRALIA LTD.
 HERCULES LONGITUDINAL PROJECTION
 Co. Ref. WORKINGS AT 12/84

BROUGHT TO DATE : 31 DEC 1984
 MINE MANAGER : *B. H. ...*
 MINE SURVEYOR : *P. J. ...*

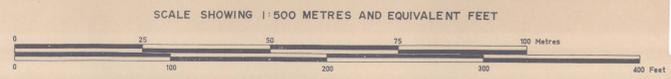

ELECTROLYTIC ZINC COMPANY OF AUSTRALASIA LIMITED
 WEST COAST MINES, TAS.

SURVEY BY	SCALE	1 : 500
DRAWN BY	DATE	1973
TRACED BY P.J. Lowe	REFERENCE	

HERCULES MINE
 LONGITUDINAL PROJECTION

DRAWING N^o :
 DEPARTMENT OF MINES