


0055-119

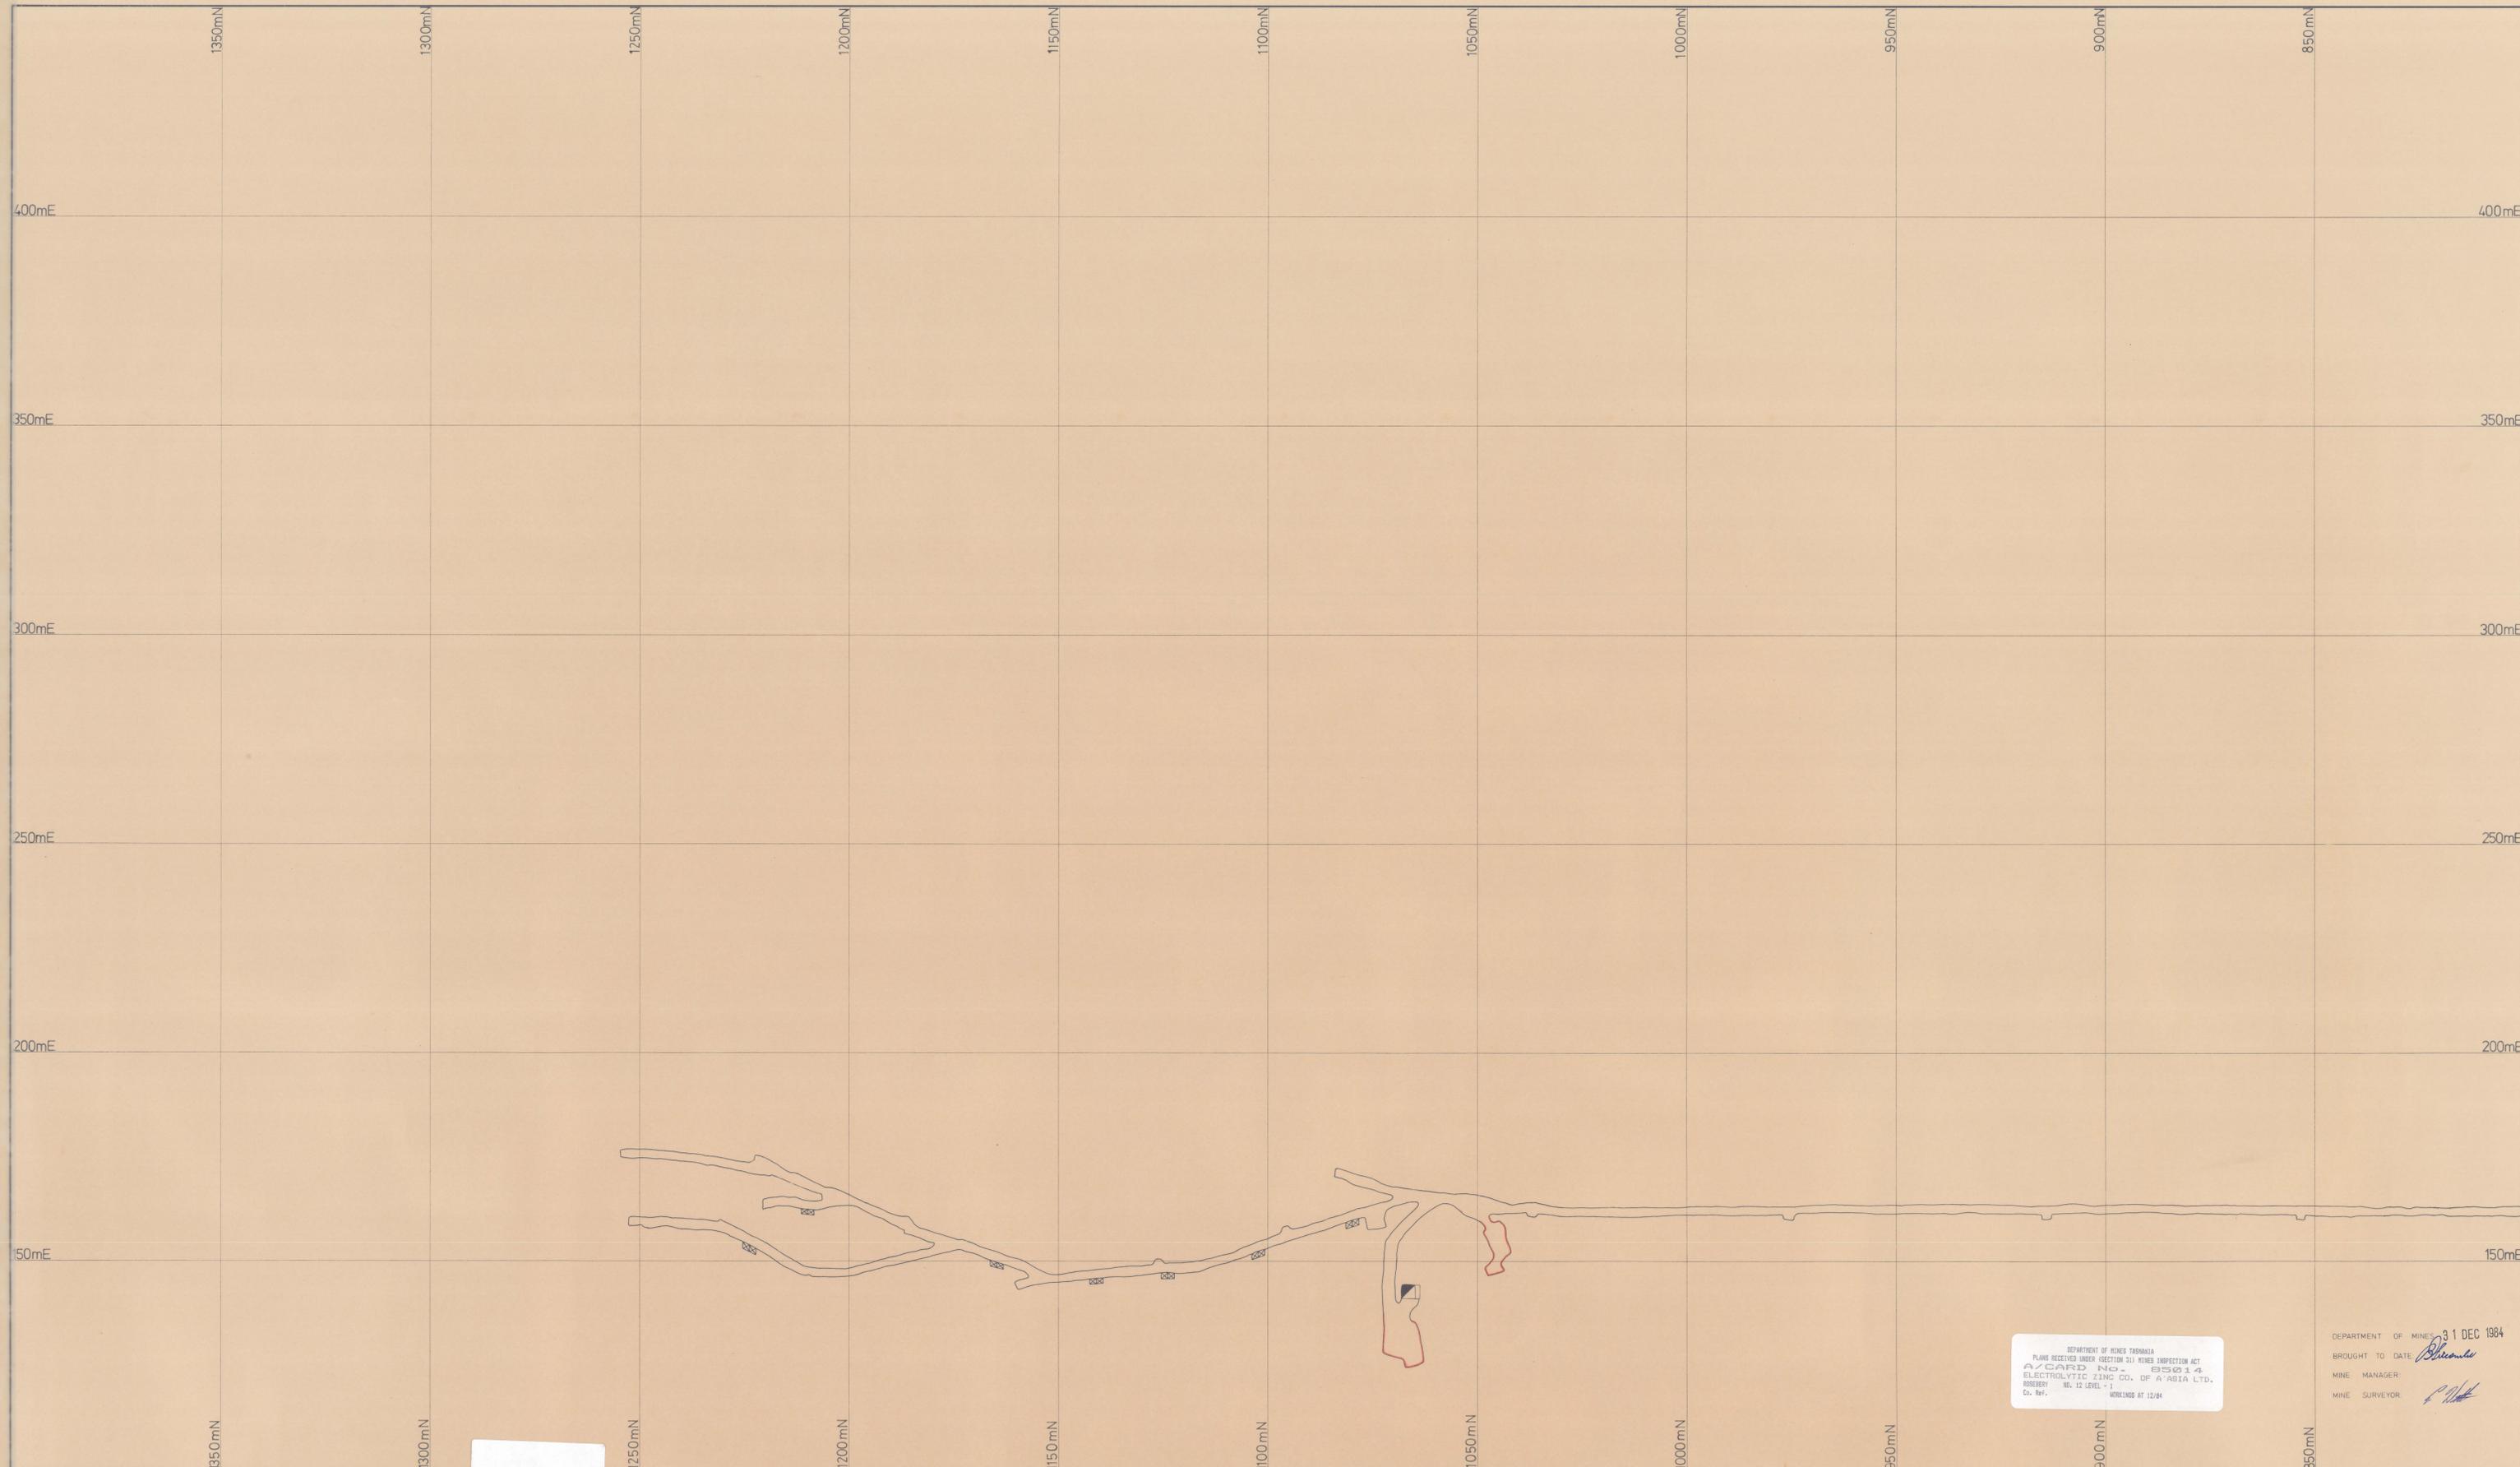

SCALE SHOWING 1:500 METRES AND EQUIVALENT FEET

ELECTROLYTIC ZINC COMPANY OF AUSTRALASIA LIMITED
WEST COAST MINES, T.A.S.

SURVEY BY		SCALE	1 500
DRAWN BY		DATE	1975
TRACED BY	RJR	REFERENCE	

DEPARTMENT OF MINES TASMANIA
PLANS RECEIVED UNDER SECTION 311 MINES INSPECTION ACT
A/CARD NO. 85014
ELECTROLYTIC ZINC CO. OF AUSTRALASIA LTD.
ROSEBERY NO. 12 LEVEL +1
Co. Ref. WORKINGS AT 12/84

DEPARTMENT OF MINES 31 DEC 1984
BROUGHT TO DATE *Blair*
MINE MANAGER
MINE SURVEYOR *RJR*

ROSEBERY MINE
No 12 LEVEL ①

DRAWING No: ② ③