

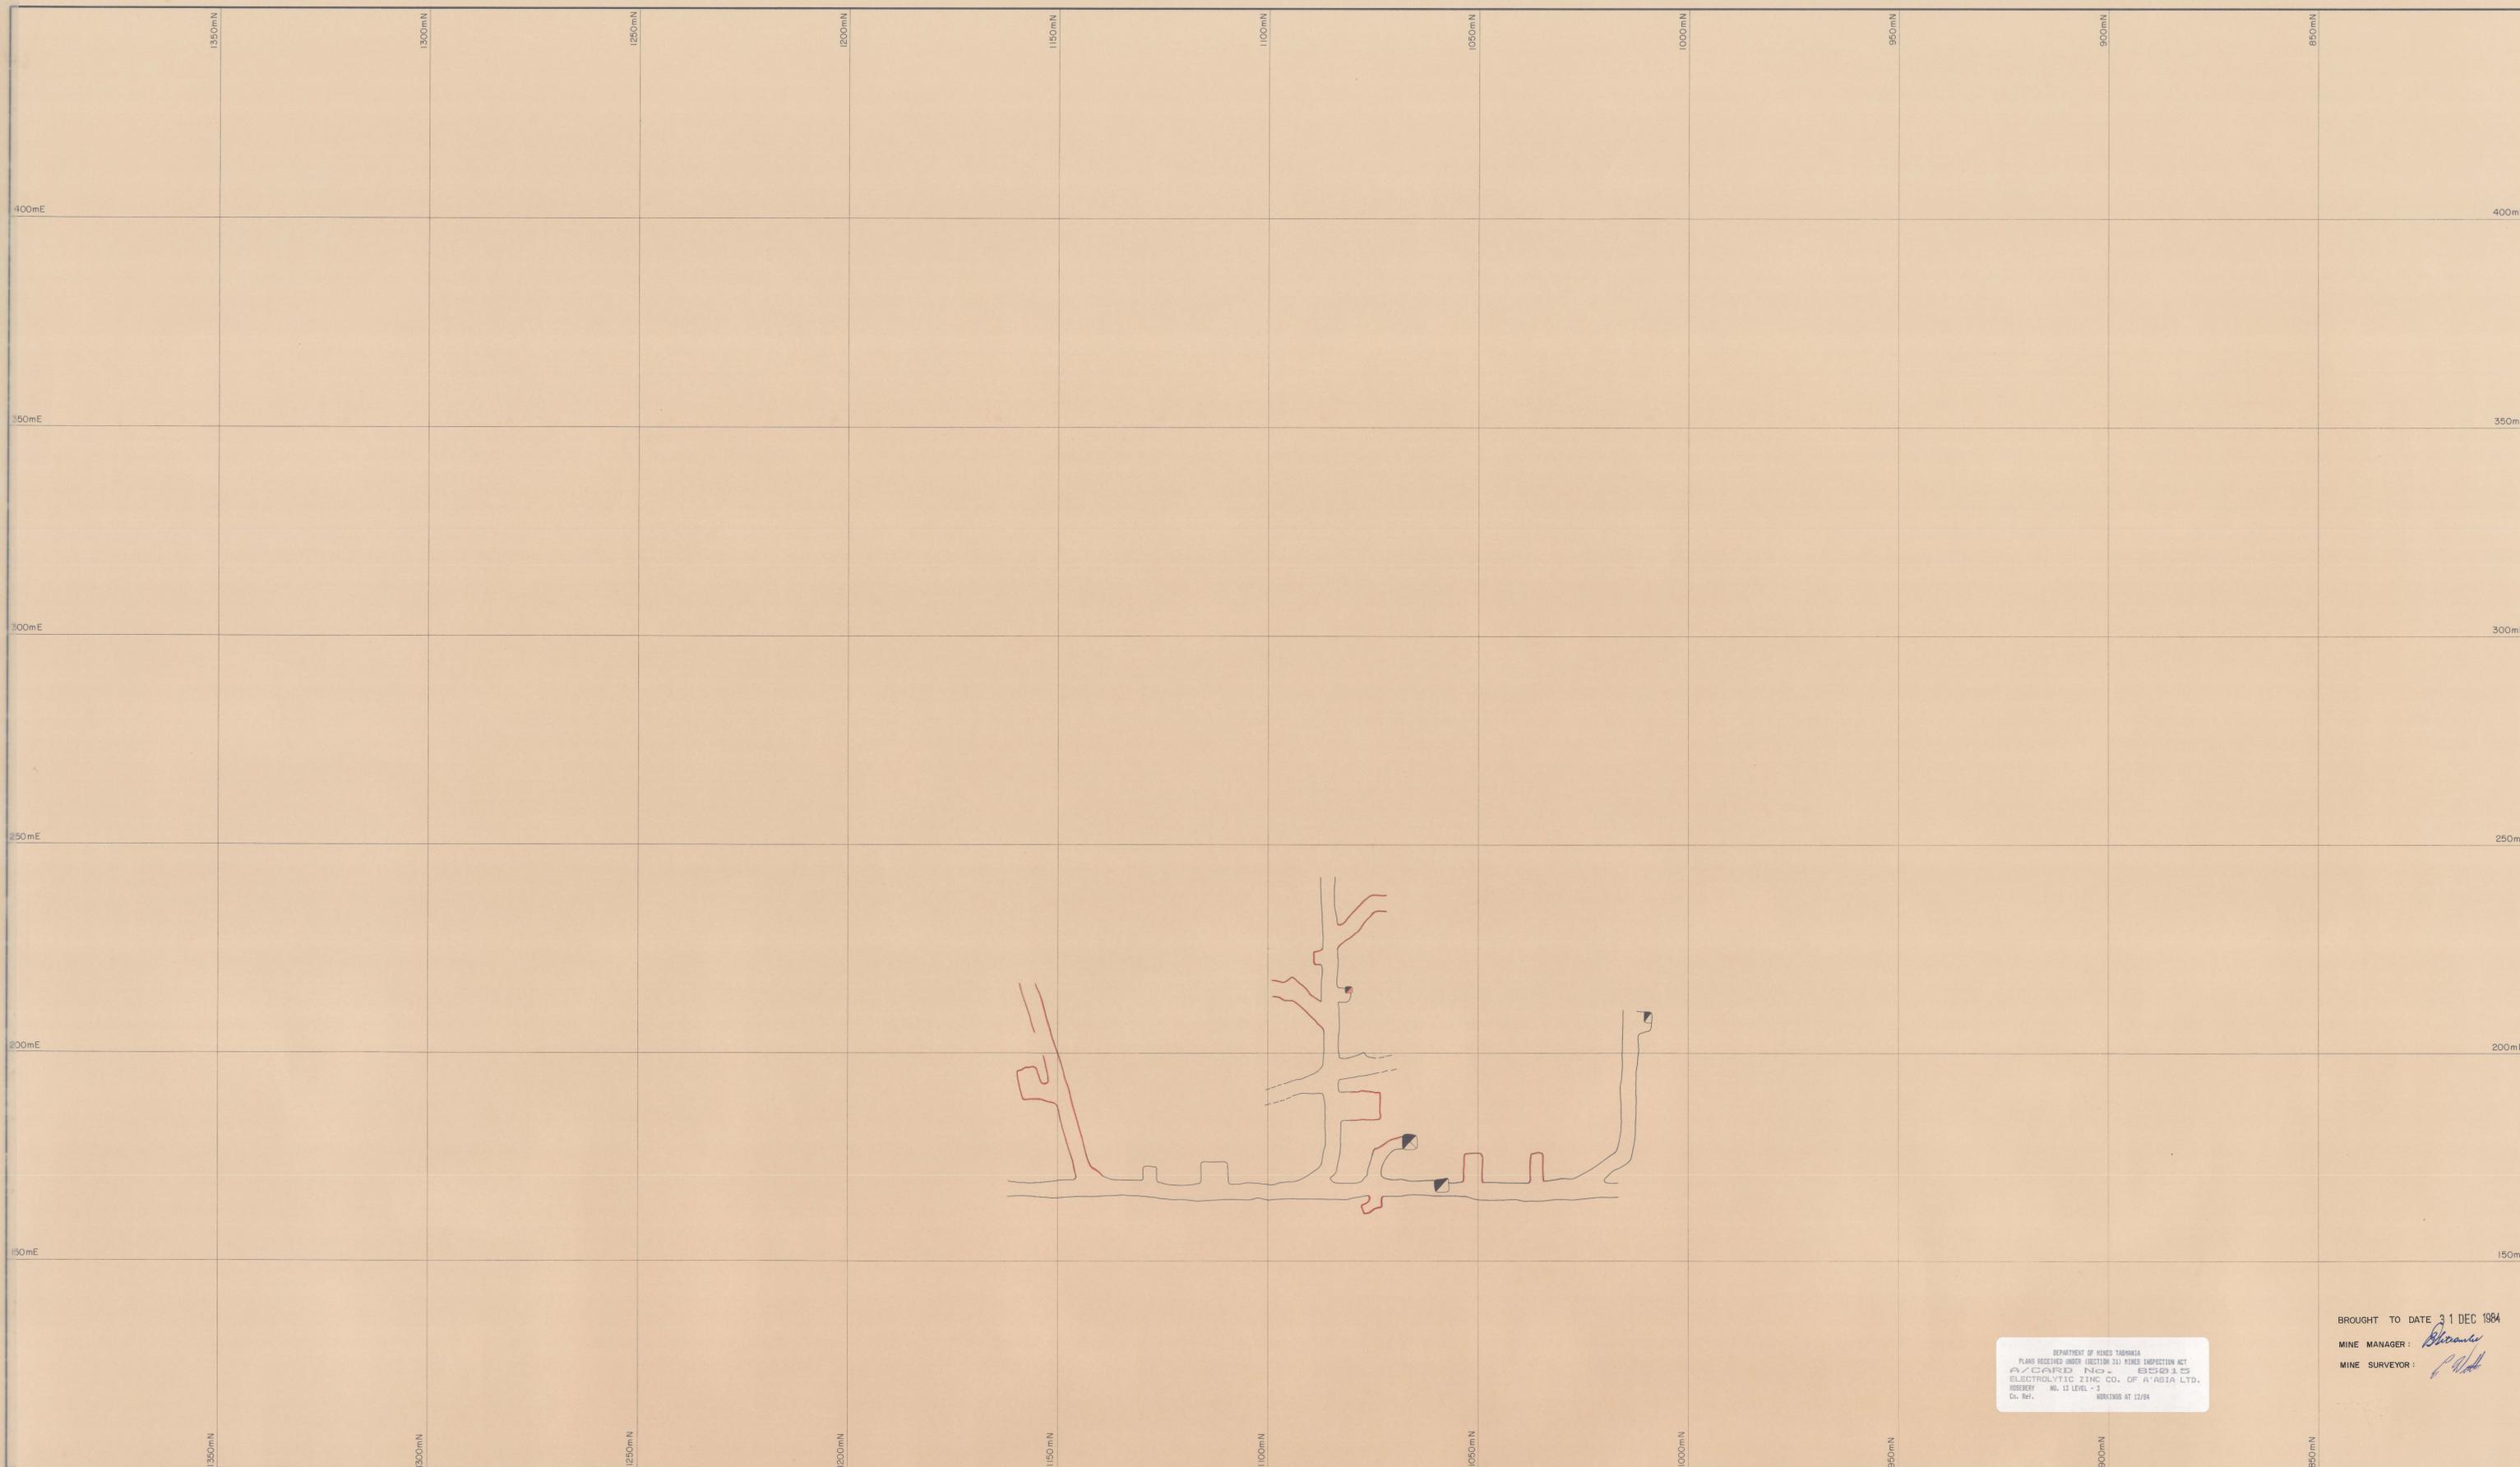


0055-12-D

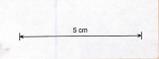

DEPARTMENT OF MINES TASMANIA
 PLANS RECEIVED UNDER SECTION 51 MINES INSPECTION ACT
 A/CARD No. 85015
 ELECTROLYTIC ZINC CO. OF AUSTRALIA LTD.
 ROSEBERY No. 13 LEVEL - 3
 Co. Ref. WORKINGS AT 12/84

BROUGHT TO DATE 31 DEC 1984
 MINE MANAGER: *[Signature]*
 MINE SURVEYOR: *[Signature]*

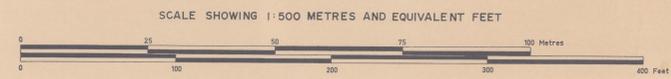

ELECTROLYTIC ZINC COMPANY OF AUSTRALASIA LIMITED
 WEST COAST MINES, T.A.S.

SURVEY BY		SCALE	1:500
DRAWN BY	P. J. S.	DATE	11 10 82
TRACED BY	G. M. B.	REFERENCE	

ROSEBERY MINE
 No. 13 LEVEL (3)

DRAWING No.:

