



0055-121

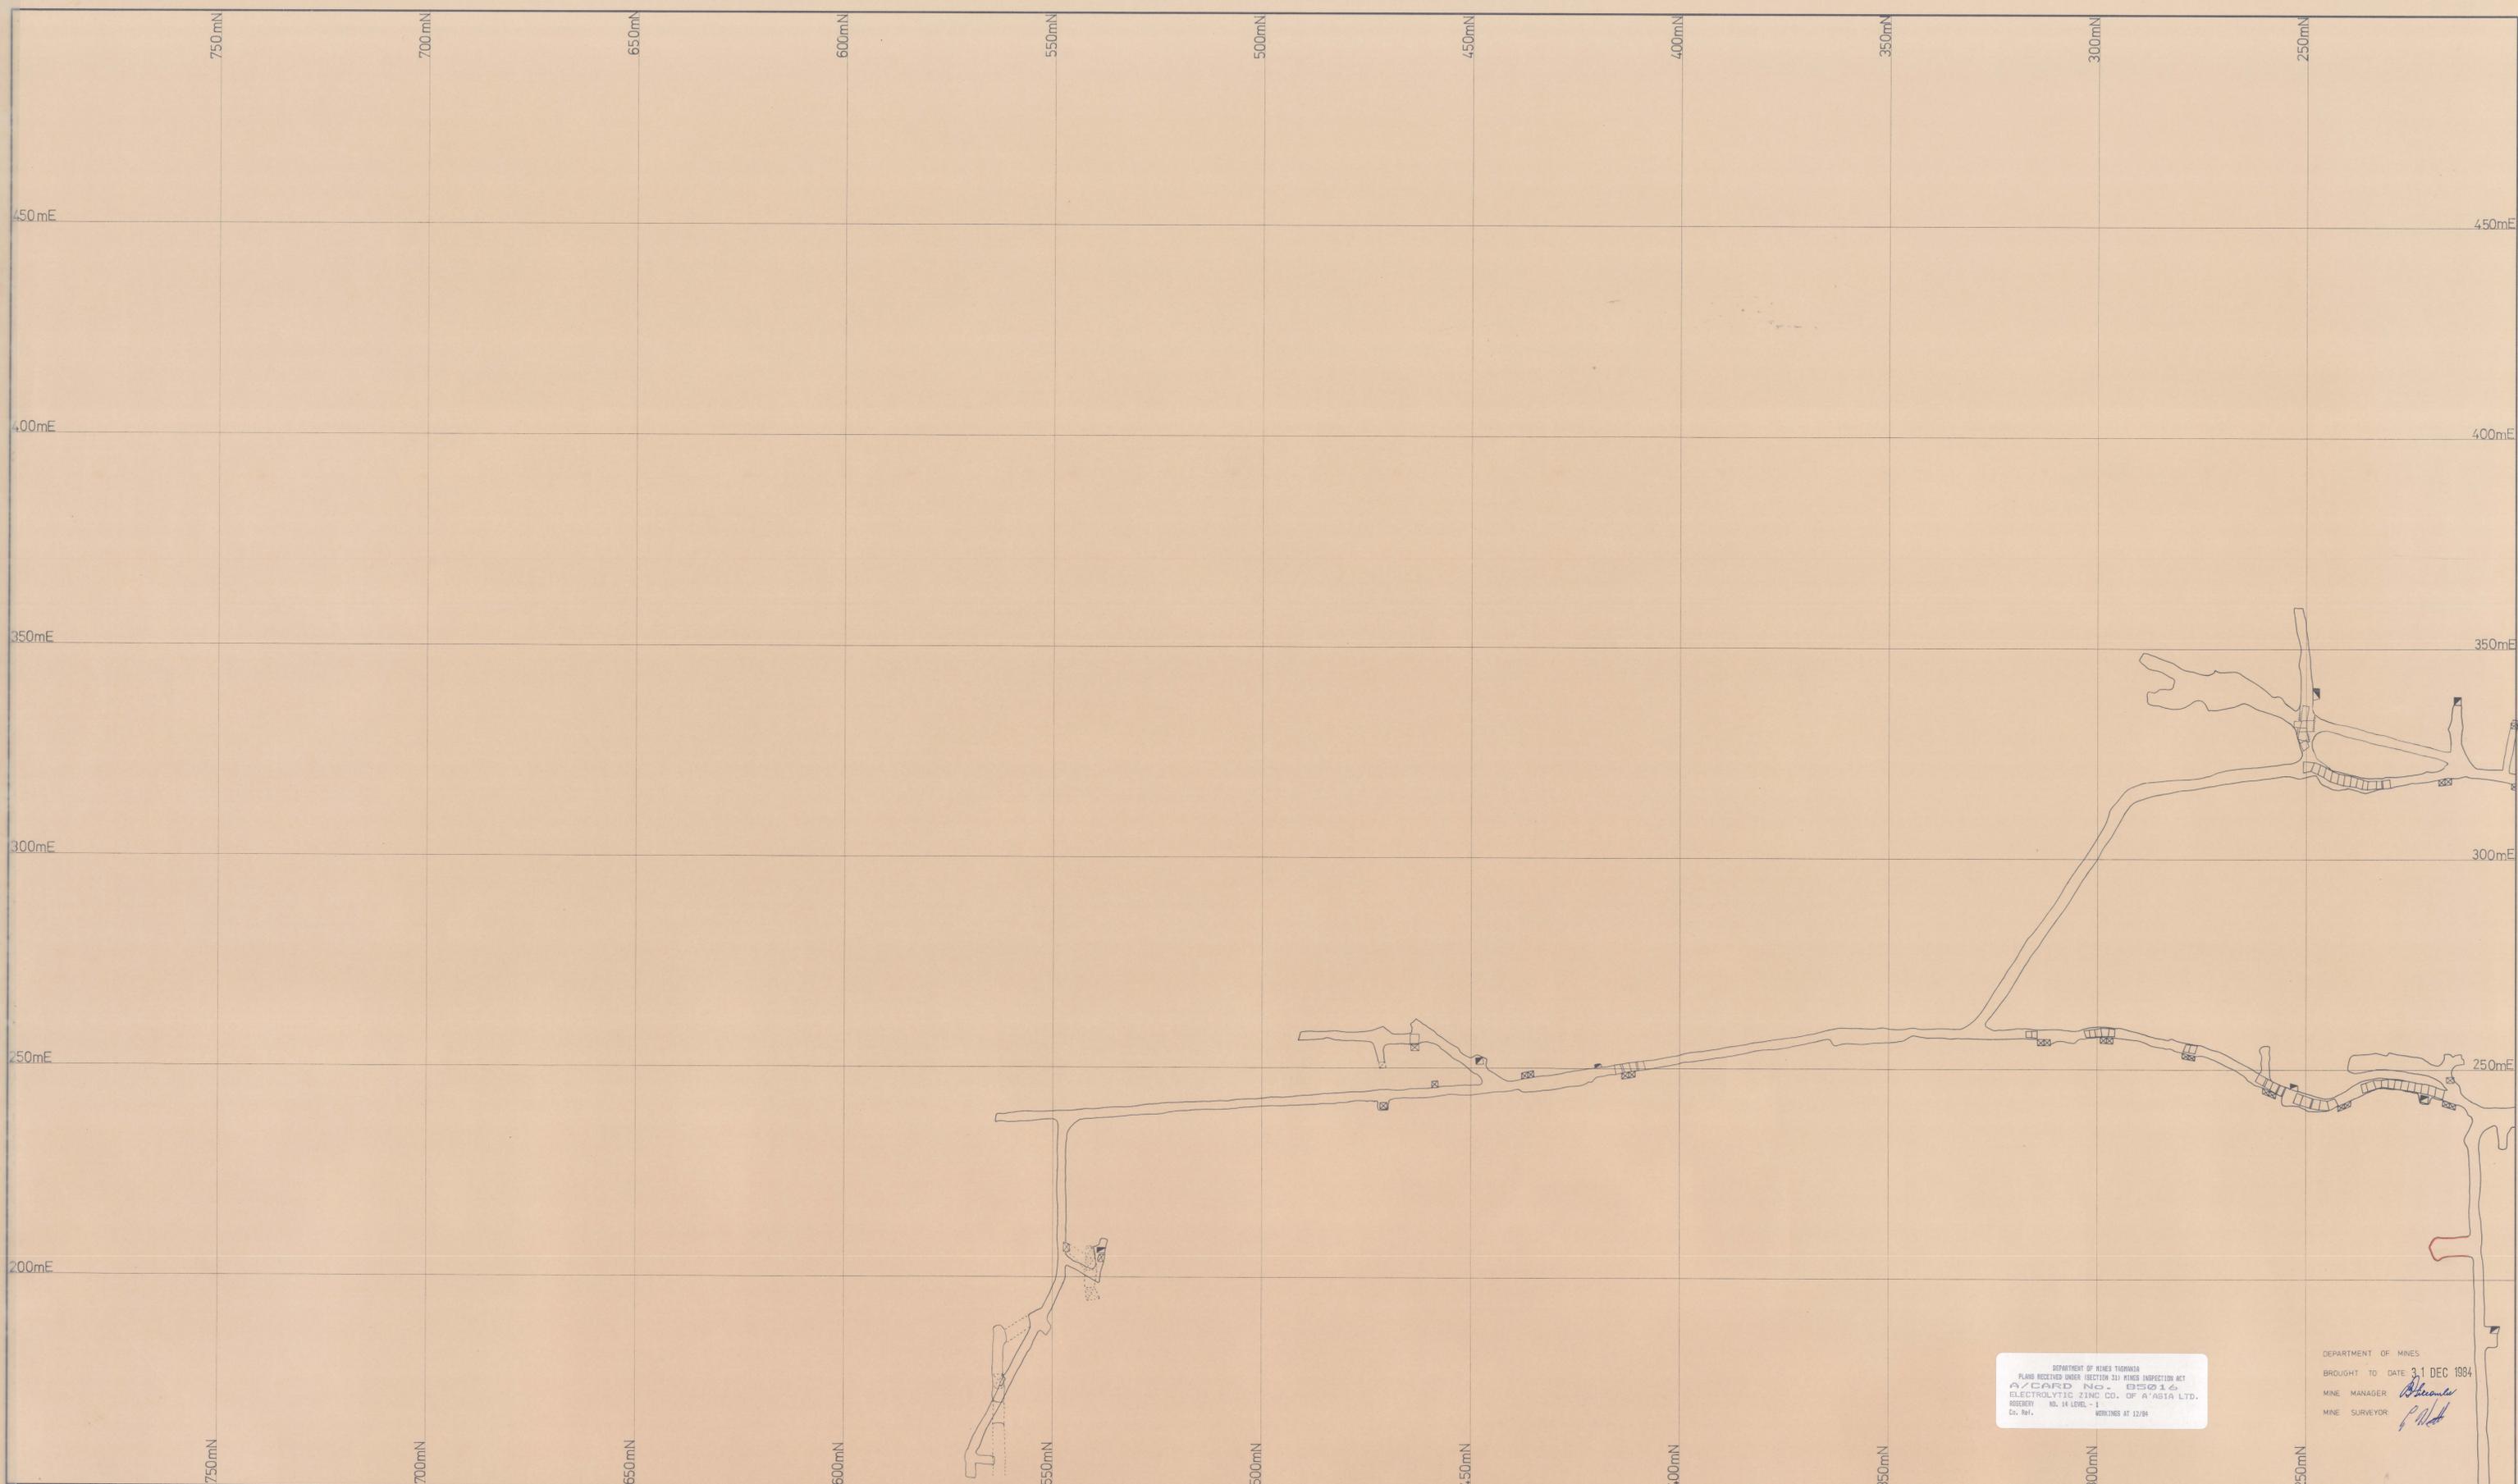

DEPARTMENT OF MINES TASMANIA
 PLANS RECEIVED UNDER SECTION 331 MINES INSPECTION ACT
 PLAN NO. 13 0350 1 2
 ELECTROLYTIC ZINC CO. OF AUSTRALIA LTD.
 ROSEBERY NO. 14 LEVEL - 1
 Co. Ref. WORKINGS AT 12/84

DEPARTMENT OF MINES
 BROUGHT TO DATE 31 DEC 1984
 MINE MANAGER *[Signature]*
 MINE SURVEYOR *[Signature]*

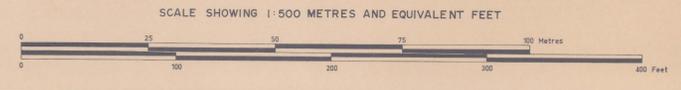

ELECTROLYTIC ZINC COMPANY OF AUSTRALASIA LIMITED
 WEST COAST MINES, TAS.

SURVEY BY		SCALE	1:500
DRAWN BY		DATE	1975
TRACED BY	I.T.M.	REFERENCE	

ROSEBERY MINE
 NO 14 LEVEL ①

