

0055-123

# ELECTROLYTIC ZINC COMPANY OF AUSTRALASIA LIMITED



WEST COAST MINES DEPT.

ROSEBERY MINE  
15 LEVEL

SCALE: 1:500  
DESIGN:  
SURVEY:  
DRAWING No. 3

Drawn	By	Date
Traced	G.M.B.	08-02-84
Checked		
Approved		

Revisions				Details				References			
No.	By	Date		App.	No.	By	Date	App.	No.	By	Date

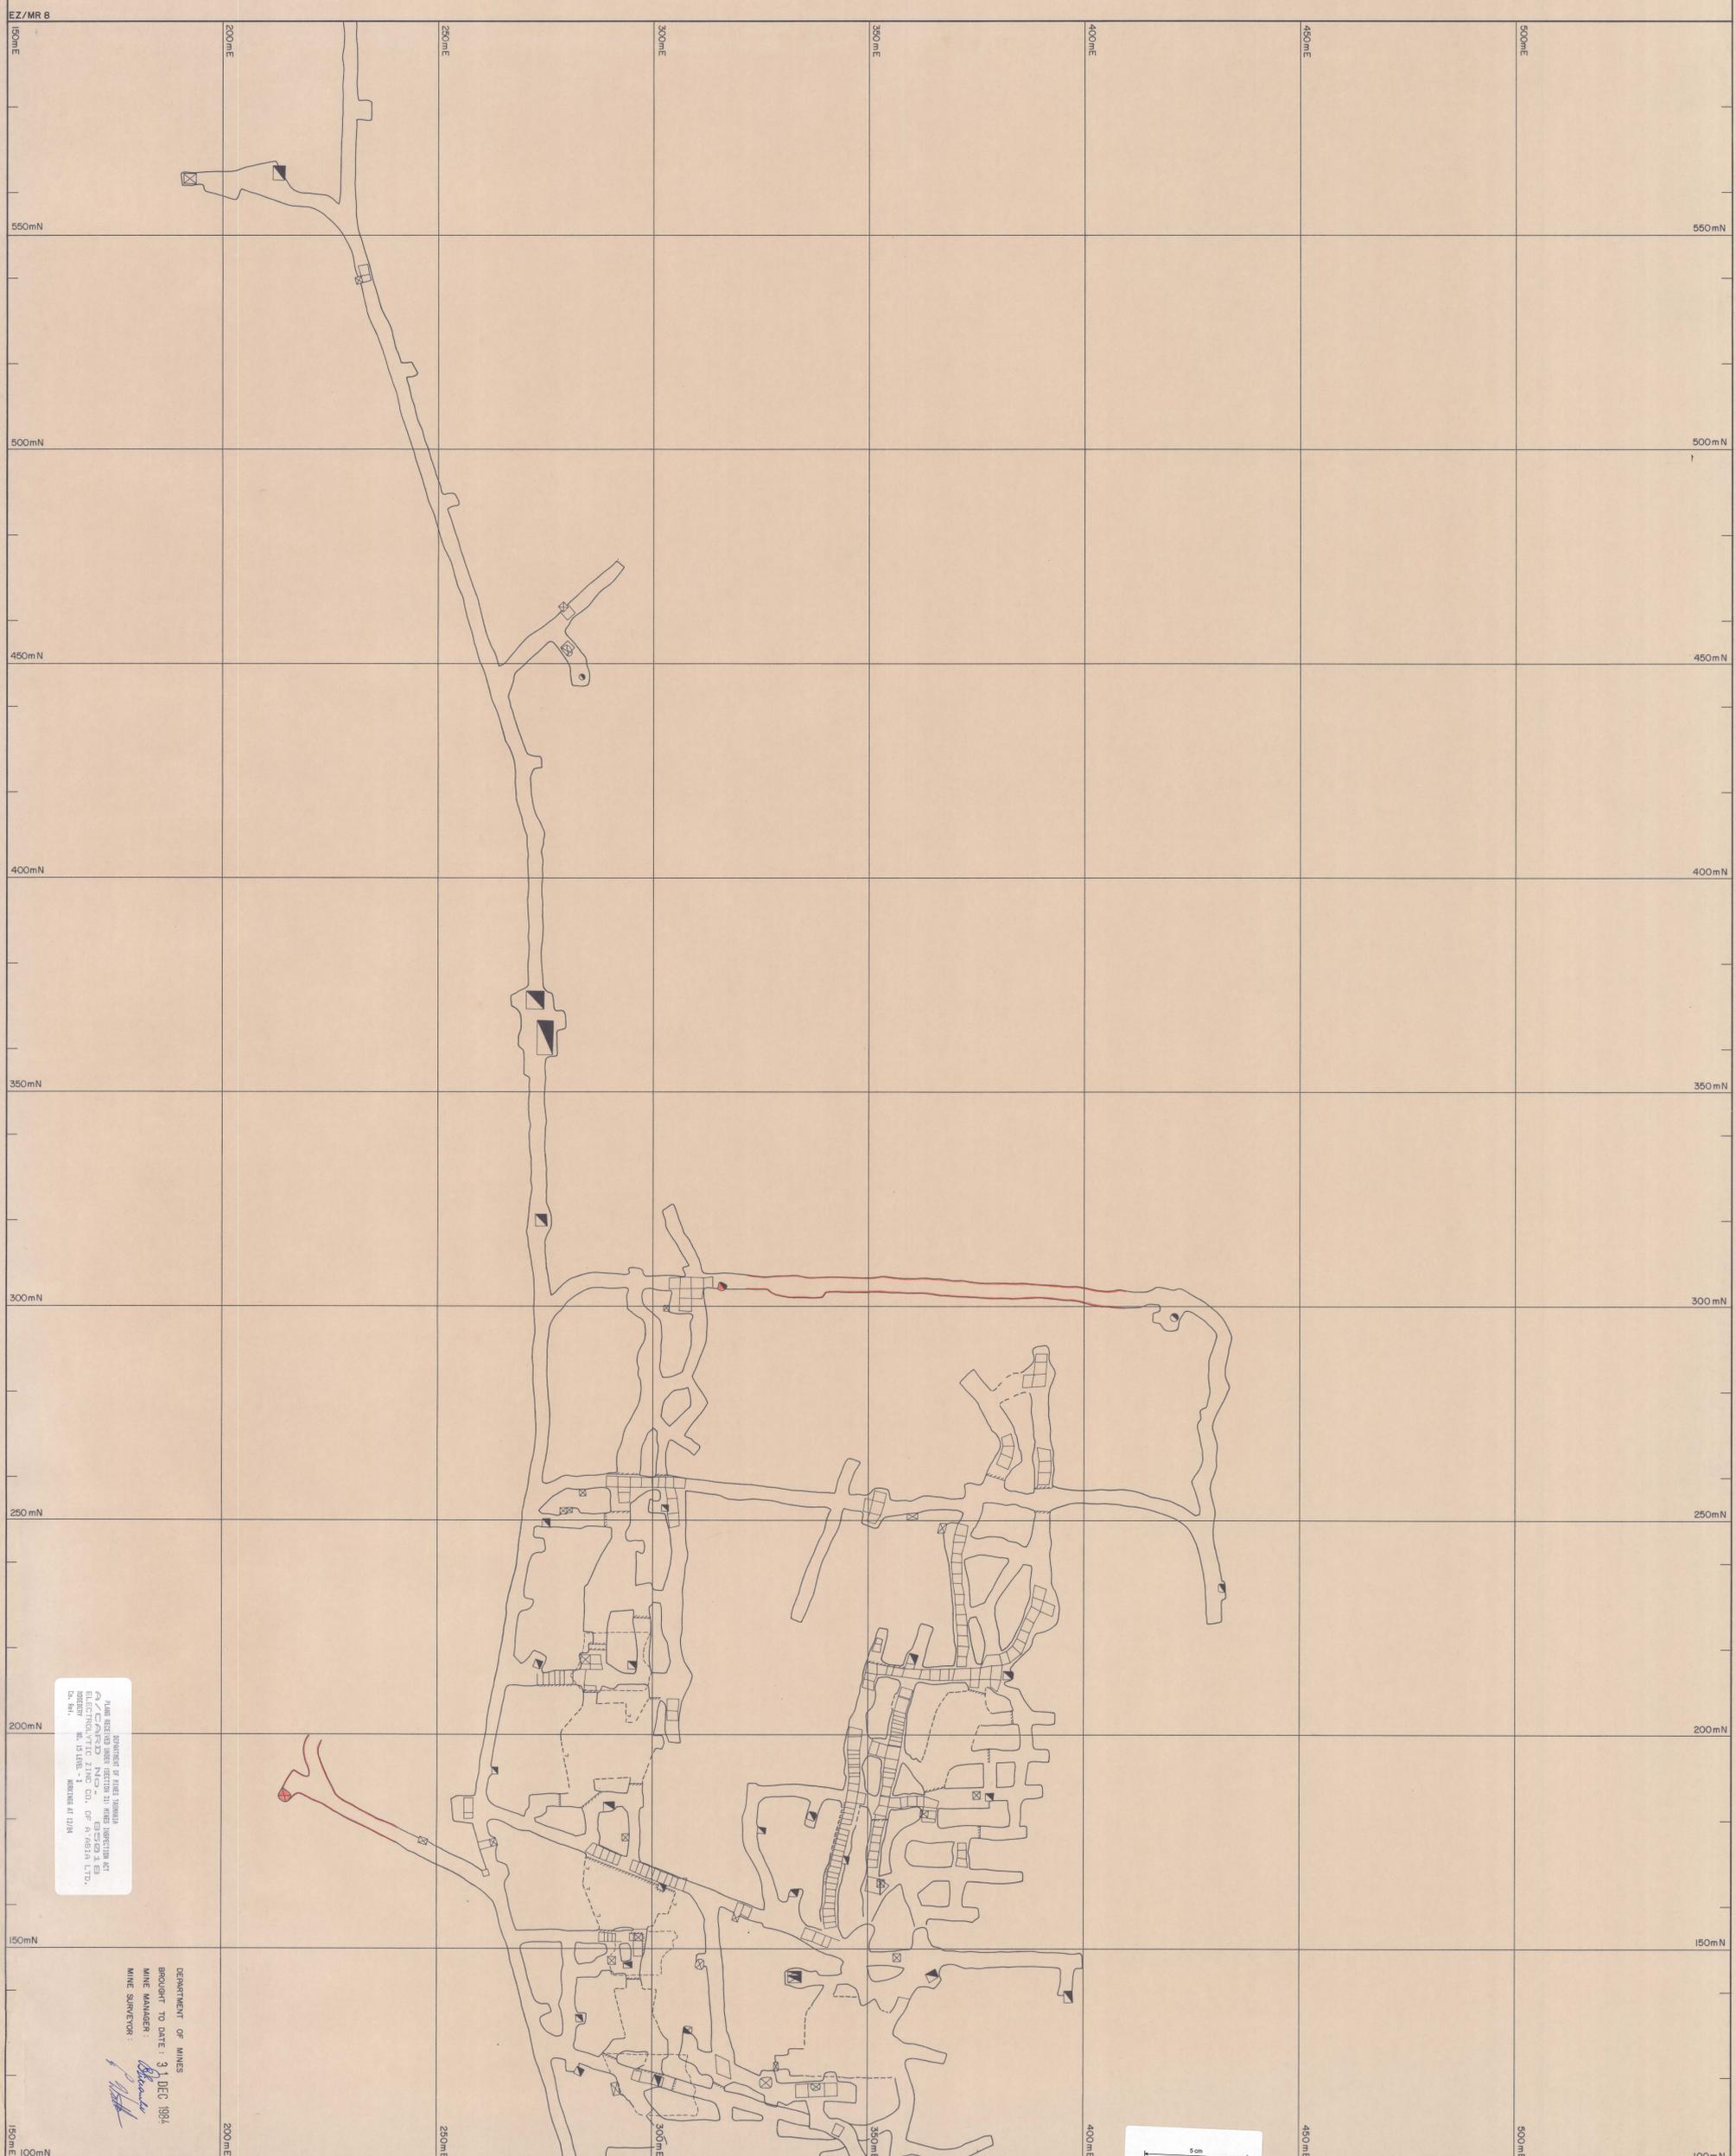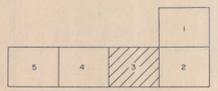

PLANS RECEIVED FROM DIRECTOR OF MINES DEPARTMENT OF MINES  
ELECTROLYTIC ZINC CO. OF AUSTRALASIA LTD.  
ROSEBERY MINE 15 LEVEL - 1  
DRAWING OF 12/84

DEPARTMENT OF MINES  
BROUGHT TO DATE: 31 DEC 1984  
MINE MANAGER: *[Signature]*  
MINE SURVEYOR: *[Signature]*

