


0055-125

ELECTROLYTIC ZINC COMPANY OF AUSTRALASIA LIMITED

WEST COAST MINES

DEPT.



ROSEBERRY MINE
15 LEVEL

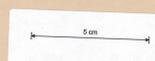

SCALE: 1:500	FILE:
DESIGN:	DRAWING No. 4
SURVEY:	No.

Drawn	By	Date
Traced	G.M.B.	08-02-84
Checked		
Approved		

Revisions	Details			App.			References		
	No.	By	Date	No.	By	Date	No.	By	Date

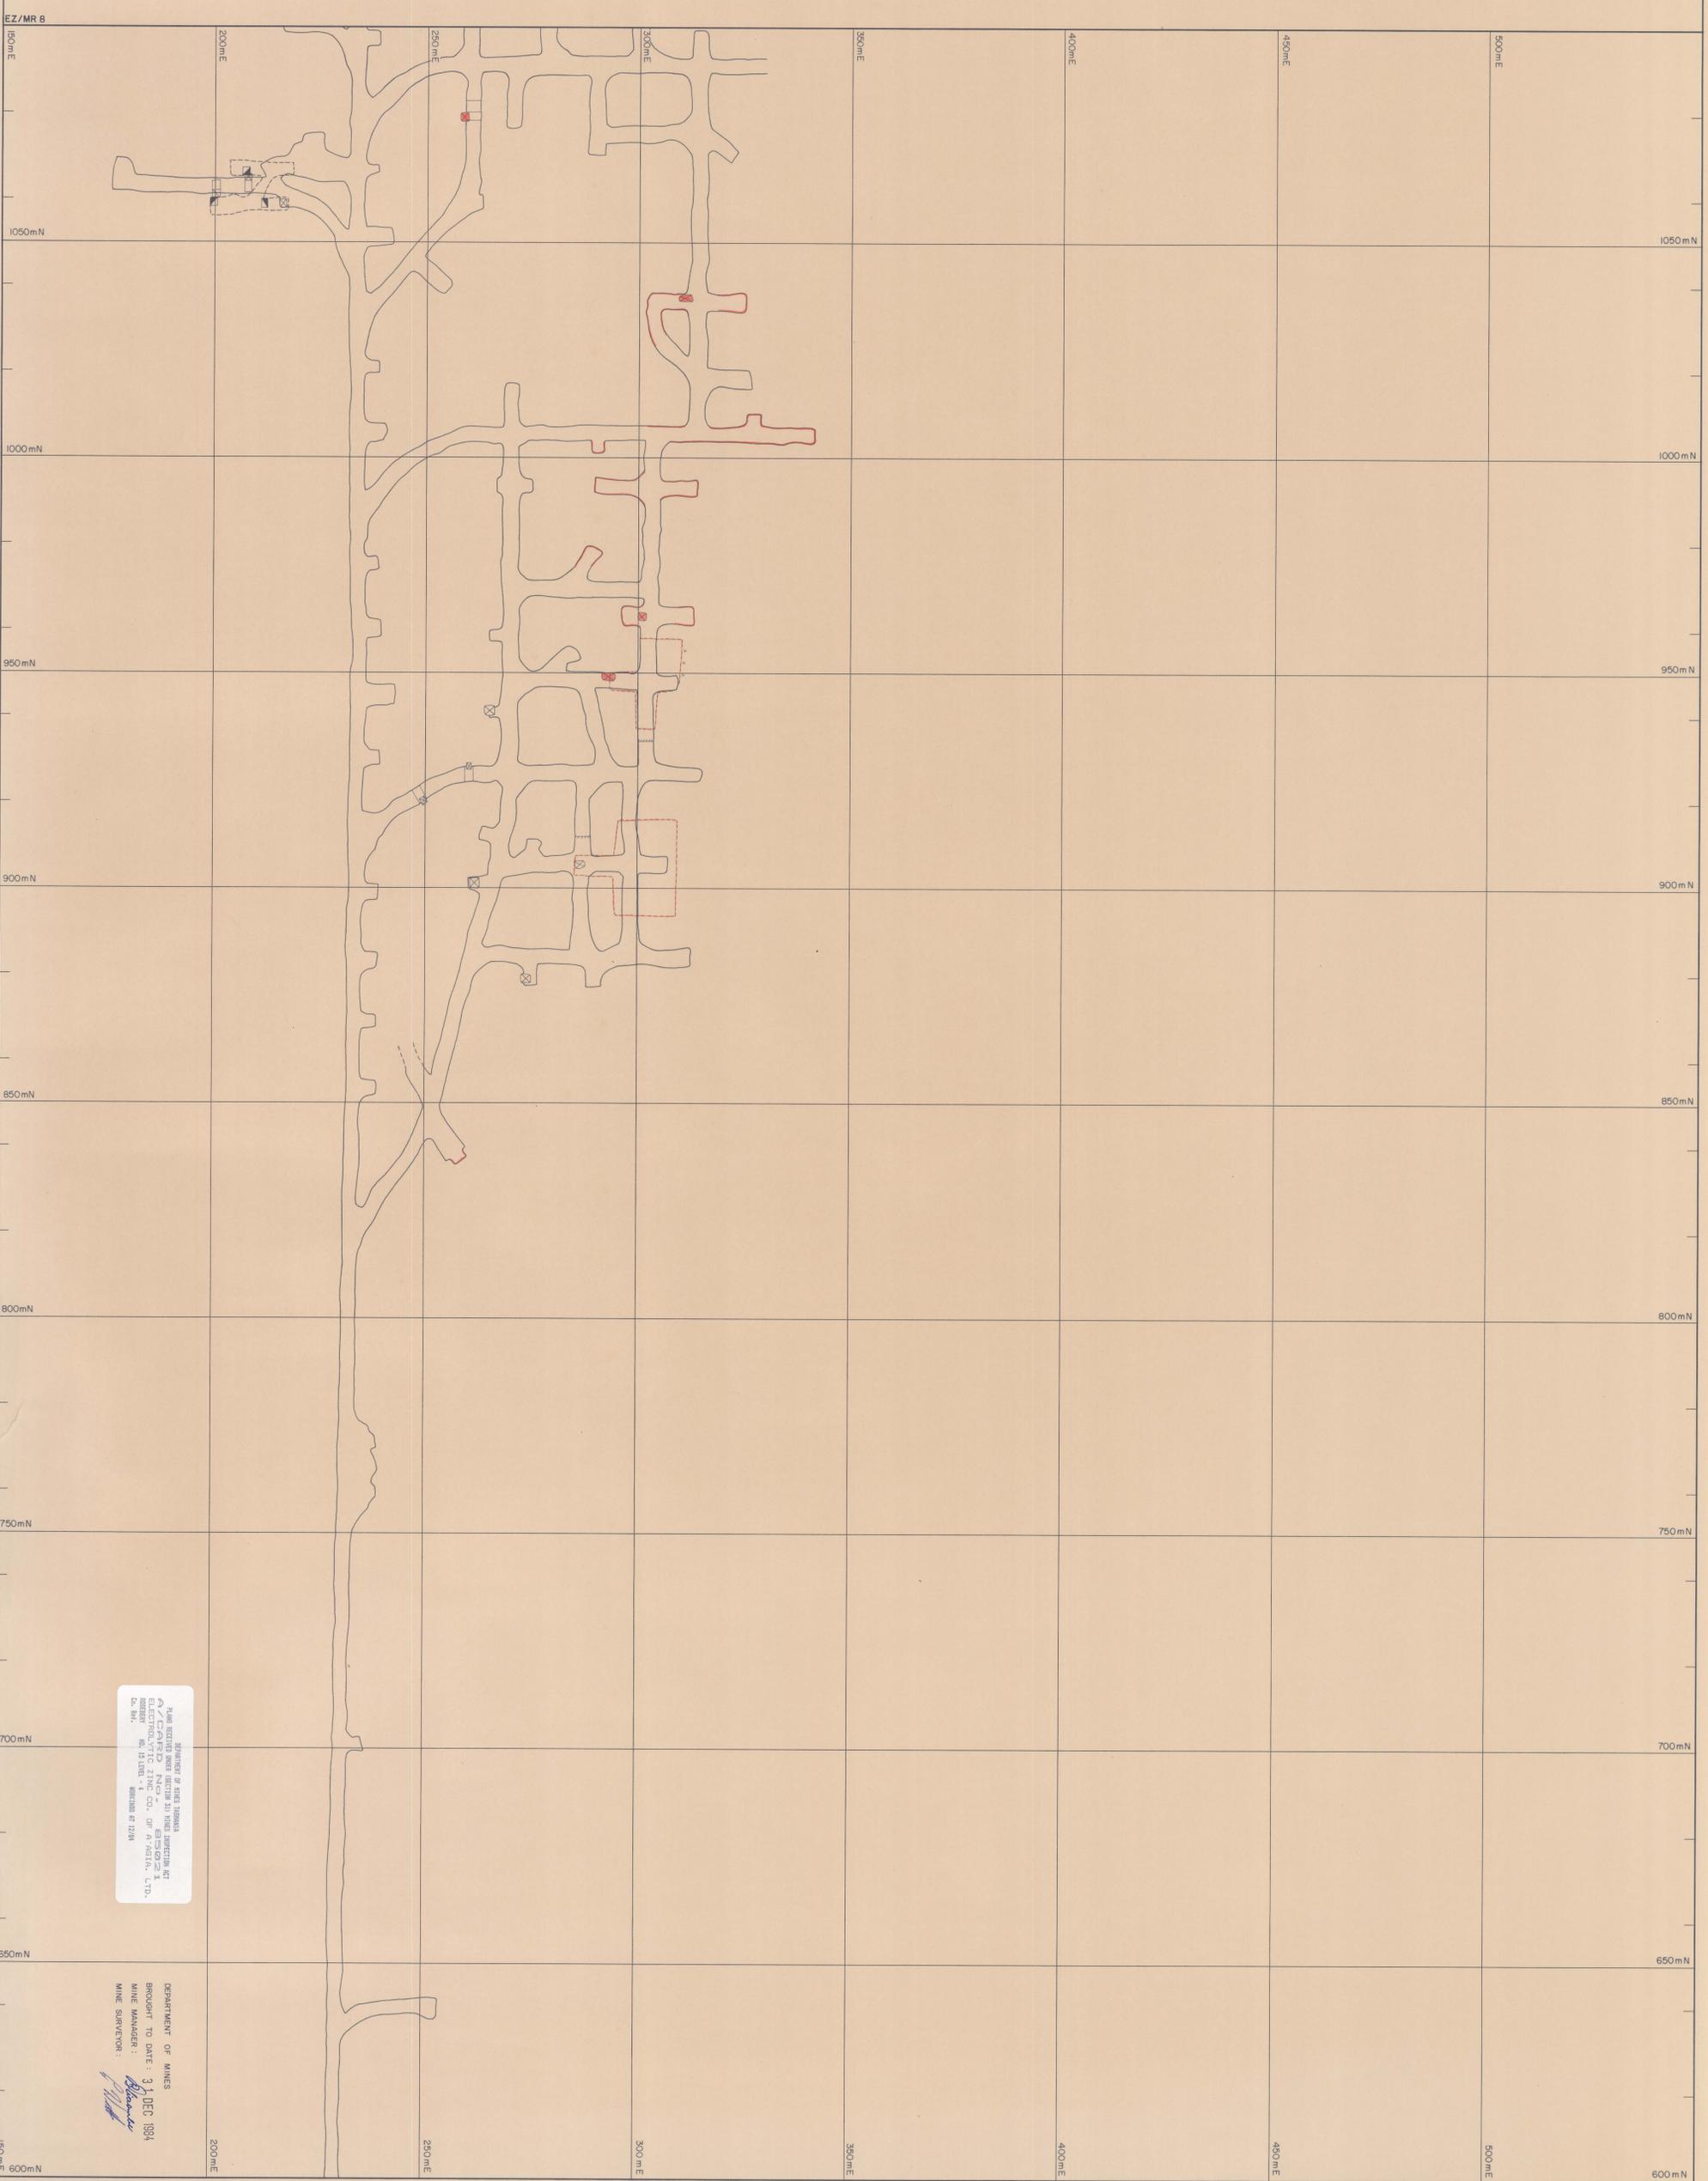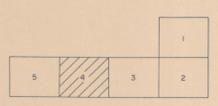

DEPARTMENT OF MINES
 ROSEBERRY MINE
 ELECTROLYTIC ZINC COMPANY
 15 LEVEL - 4
 WORKING AT 12/84

DEPARTMENT OF MINES
 BROUGHT TO DATE: 31 DEC 1984
 MINE MANAGER: *[Signature]*
 MINE SURVEYOR: *[Signature]*